


Google earth





Google earth



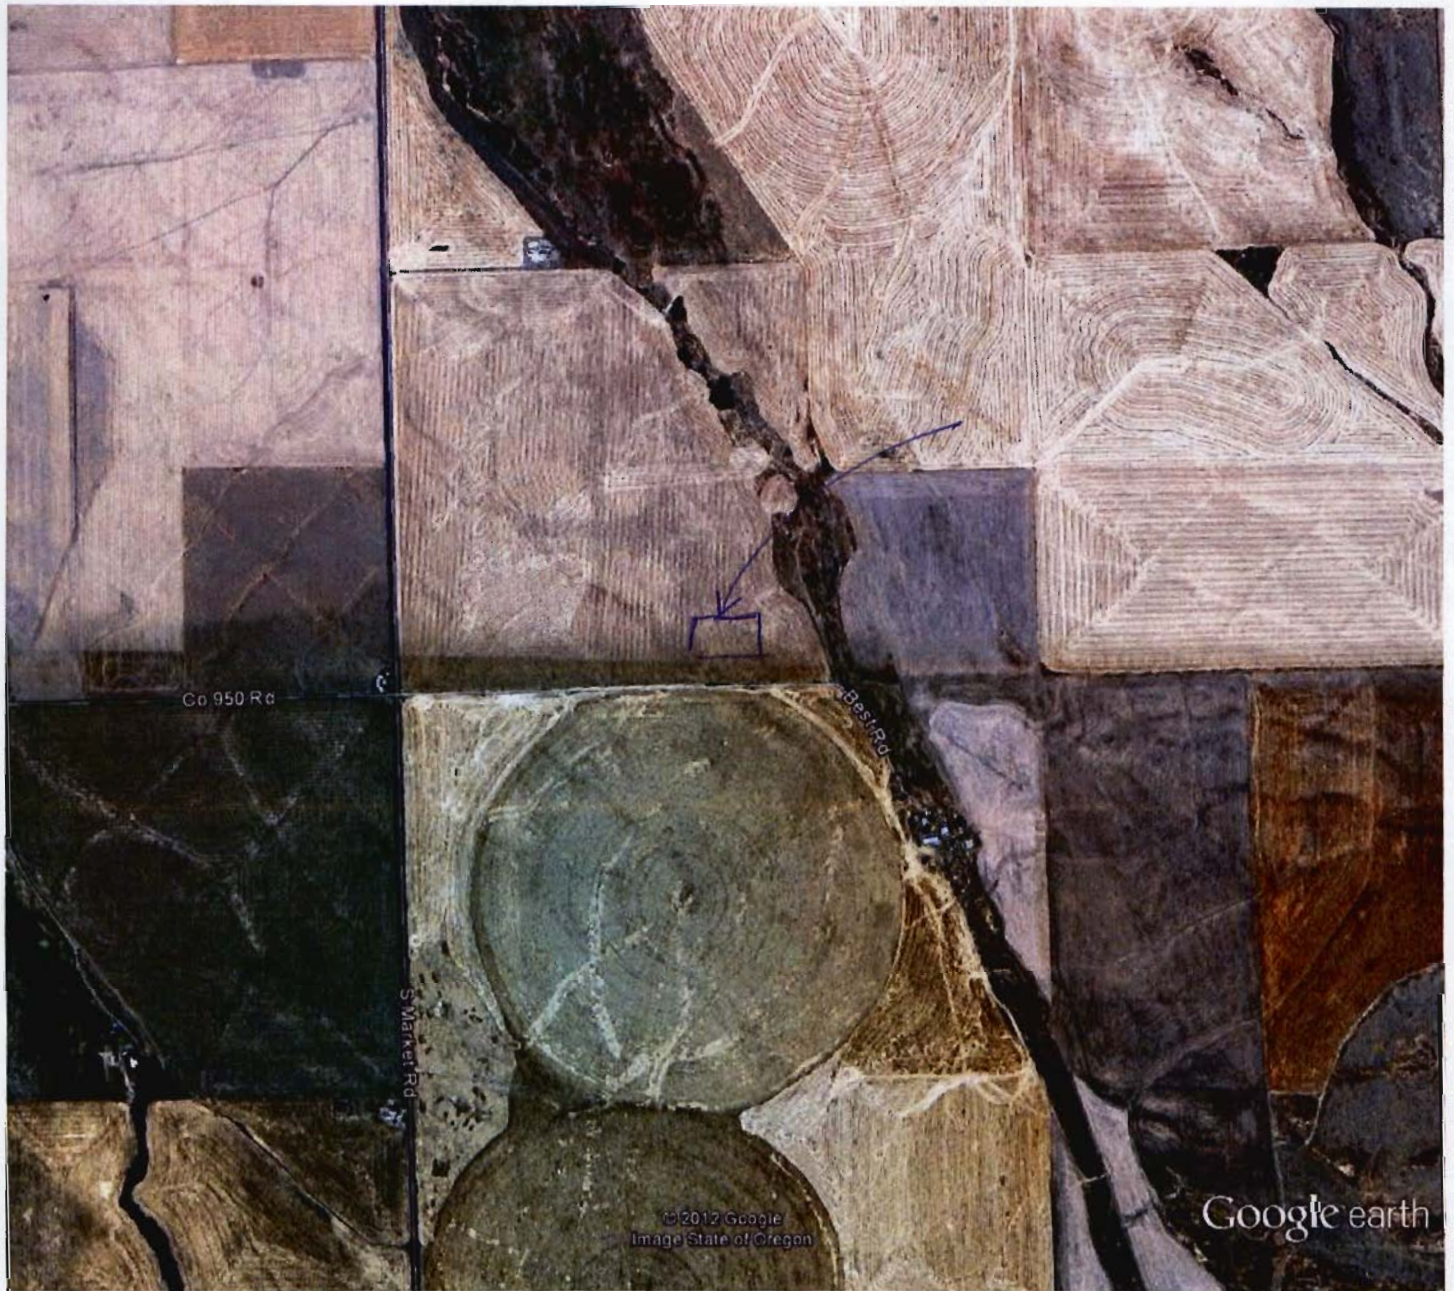

Google earth

feet 4000
km 1

