


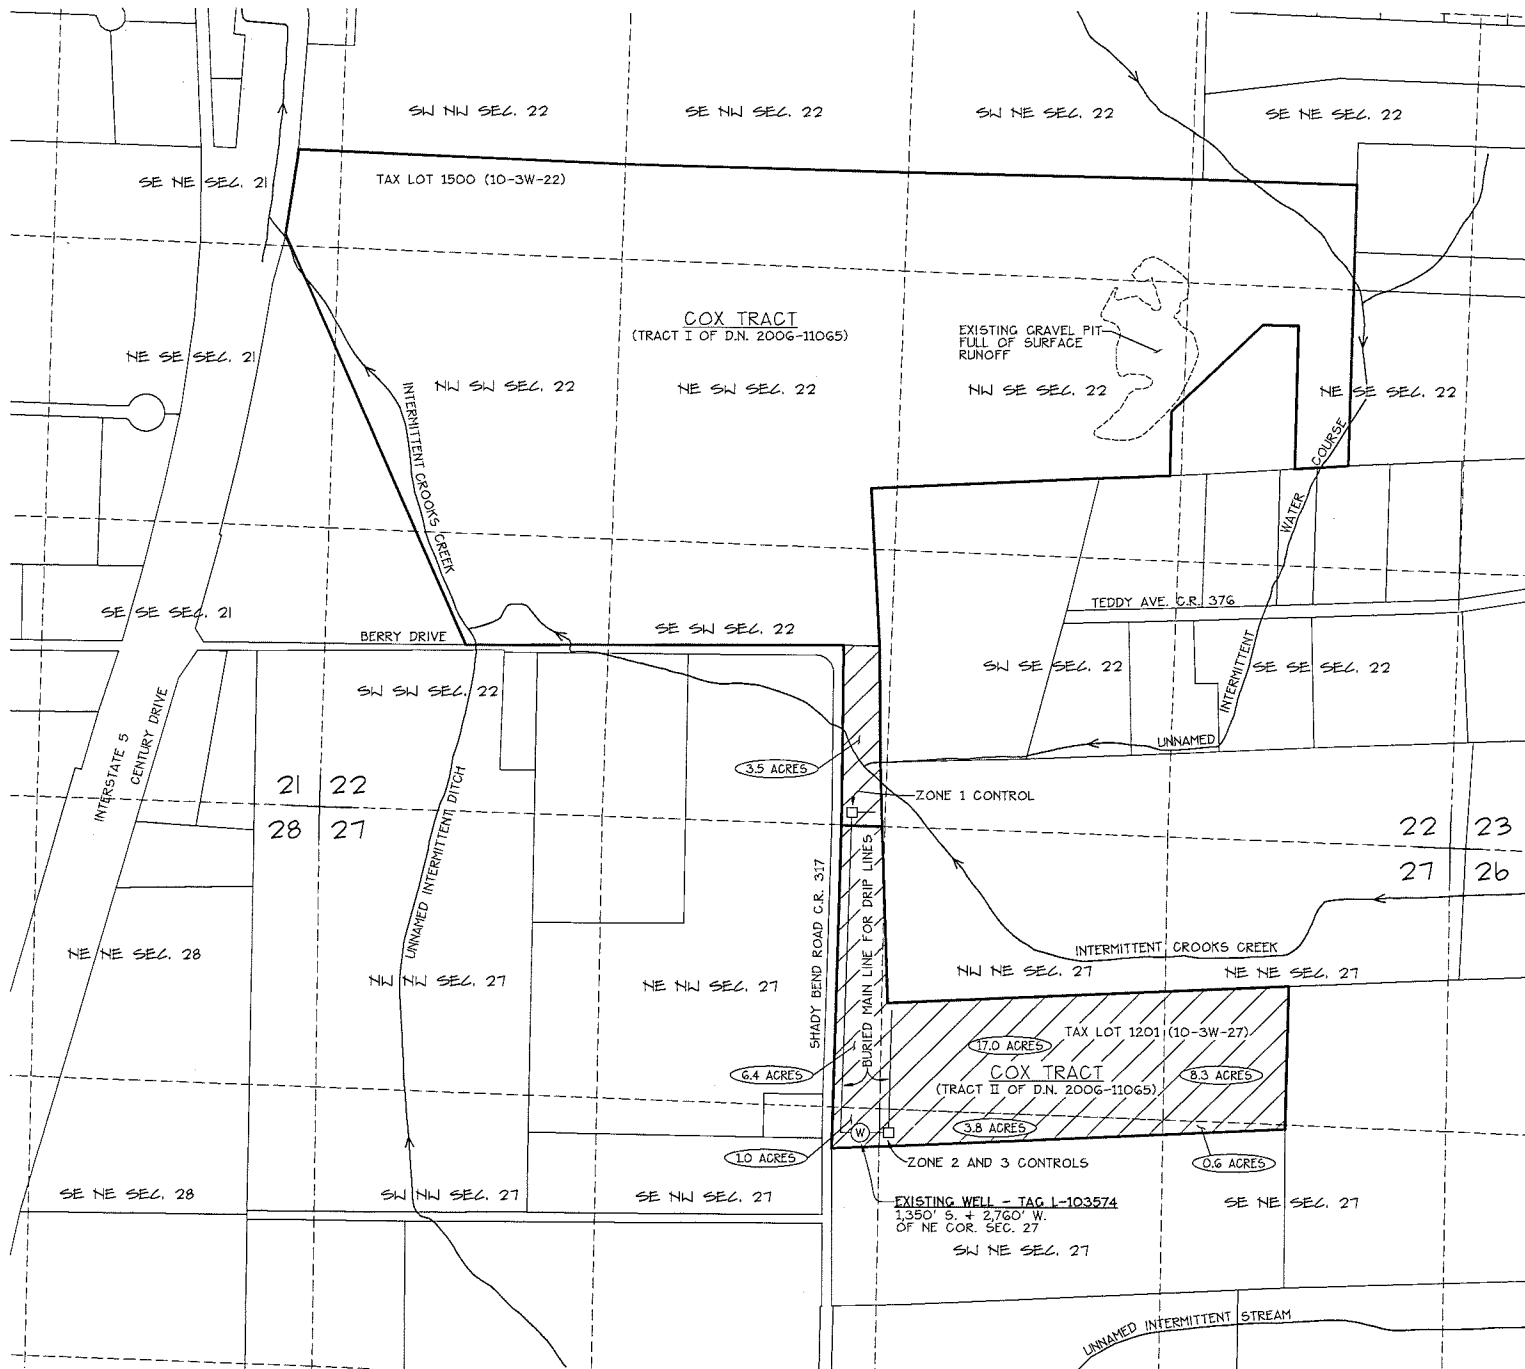

GROUND WATER APPLICATION MAP

FOR
WADE COX

LOCATED IN
SW 1/4 SEC. 22 + N. 1/2 SEC. 27,
T. 10 S., R. 3 W., W.M.
LINN COUNTY, OREGON

~~OCTOBER 22, 2012~~
REVISED FEBRUARY 12, 2013

0 200 400 800 FT.
SCALE: 1" = 400'

OWNER:

WADE A. COX
33927 BERRY DRIVE NE
ALBANY, OR 97322

APPLICANT:

WADE A. COX
33927 BERRY DRIVE NE
ALBANY, OR 97322

SITE ADDRESS:

TAX LOT 1500
33875 + 33927 BERRY DRIVE NE
ALBANY, OR 97322
TAX LOT 1201
NO ASSIGNED ADDRESS

TAX LOTS:

TAX LOT 1500 (10-3W-22)
TAX LOT 1201 (10-3W-27)

LEGEND:

AREA TO BE IRRIGATED WITH GROUND WATER. 40.6 ACRES.

10.0 ACRES AREA TO BE IRRIGATED WITH GROUND WATER PER QUARTER-QUARTER SECTION

POINT OF APPROPRIATION - WELL

RECEIVED

FEB 13 2013


WATER RESOURCES DEPT
SALEM, OREGON

DISCLAIMER:

THIS MAP IS NOT INTENDED TO PROVIDE
LEGAL DIMENSIONS OR LOCATIONS OF
PROPERTY OWNERSHIP LINES

Date: 2/12/2013 Time: 11:57
Scale: 1=400(FS)
File: dwg\2012\12-25\12-25wr.dwg (lan)

K & D ENGINEERING, Inc.
276 N.W. Hickory Street, P.O. Box 726
Albany, Oregon 97321
(541) 928-2583

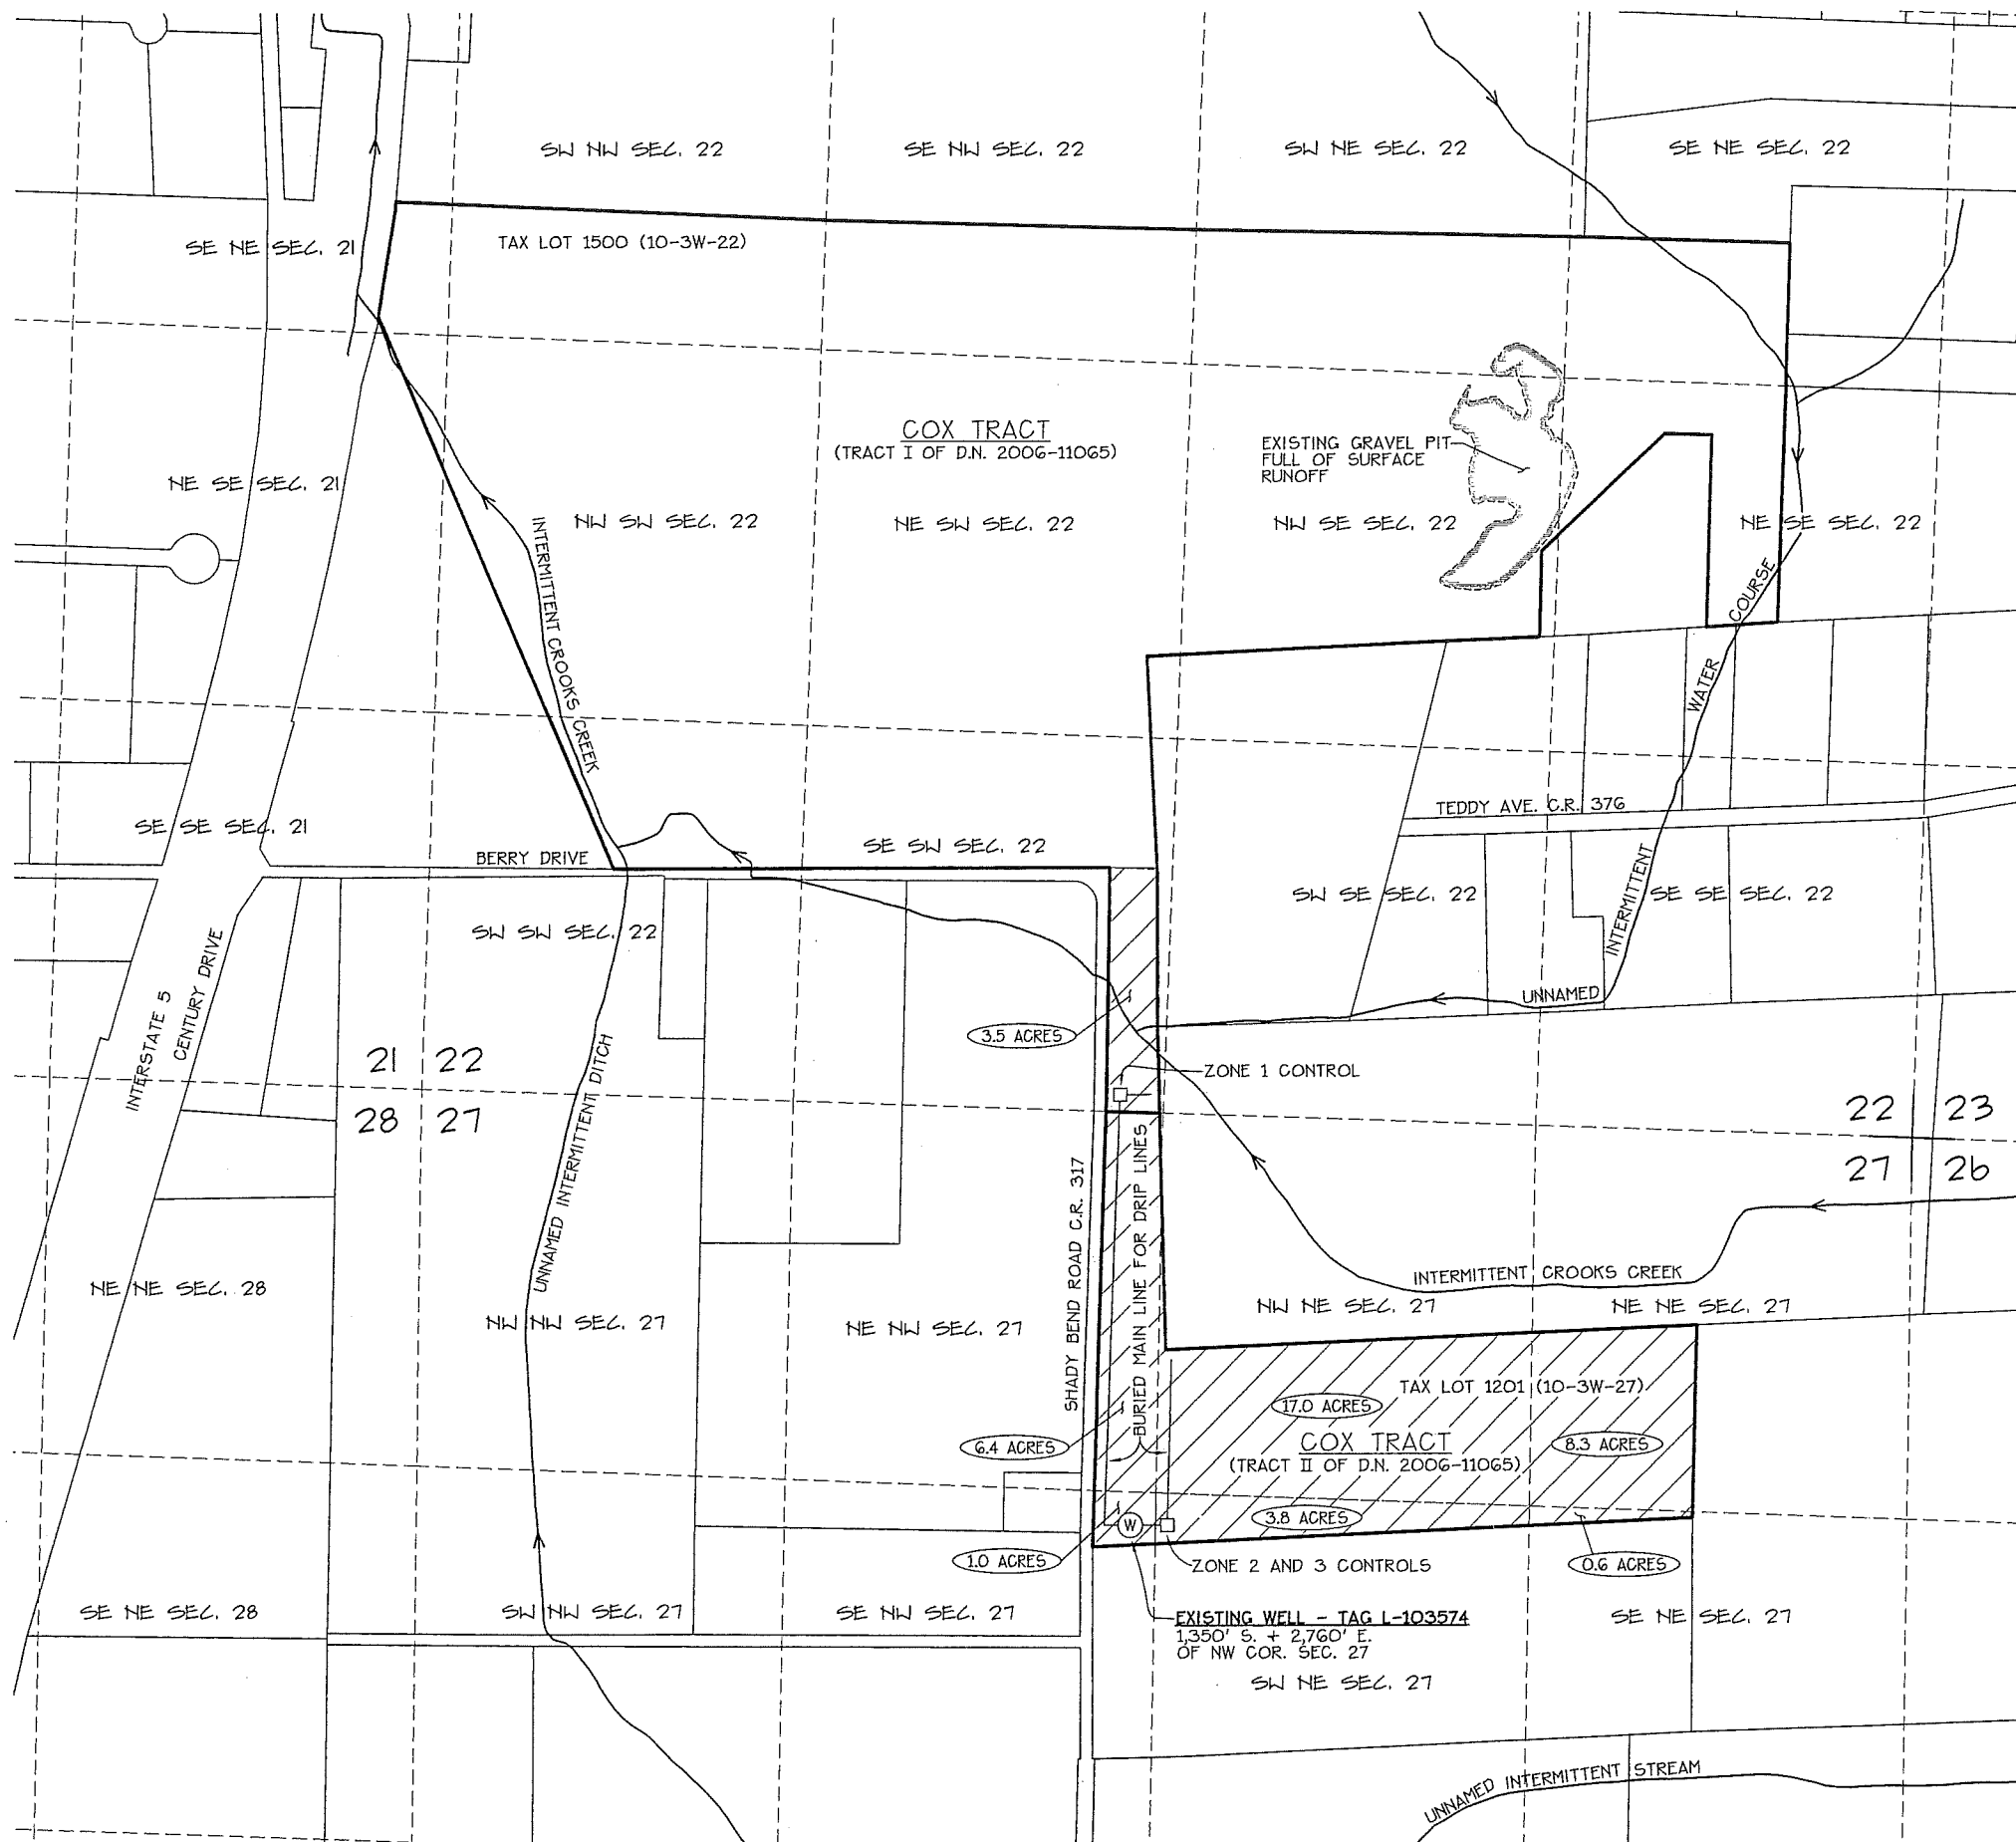

GROUND WATER
APPLICATION MAP
FOR
WADE COX
LOCATED IN
SW 1/4 SEC. 22 + N. 1/2 SEC. 27,
T. 10 S., R. 3 W., W.M.
LINN COUNTY, OREGON
OCTOBER 22, 2012

RECEIVED

NOV 16 2012

WATER RESOURCES DEPT
SALEM, OREGON

0 200 400 800 FT.

SCALE: 1" = 400'

OWNER:

WADE A. COX
33927 BERRY DRIVE NE
ALBANY, OR 97322

APPLICANT:

WADE A. COX
33927 BERRY DRIVE NE
ALBANY, OR 97322

SITE ADDRESS:


TAX LOT 1500
33875 + 33927 BERRY DRIVE NE
ALBANY, OR 97322
TAX LOT 1201
NO ASSIGNED ADDRESS

TAX LOTS:

TAX LOT 1500 (10-3W-22)
TAX LOT 1201 (10-3W-27)

LEGEND:

- AREA TO BE IRRIGATED WITH GROUND WATER. 40.6 ACRES.
- AREA TO BE IRRIGATED WITH GROUND WATER PER QUARTER-QUARTER SECTION
- POINT OF APPROPRIATION - WELL

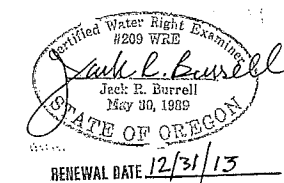

DISCLAIMER:

THIS MAP IS NOT INTENDED TO PROVIDE
LEGAL DIMENSIONS OR LOCATIONS OF
PROPERTY OWNERSHIP LINES

Date: 10/22/2012 Time: 14:07
Scale: 1=400(P5)
File: dwg\2012\12-25\12-25wr.dwg (lan)

K & D ENGINEERING, Inc.
278 N.W. Hickory Street P.O. Box 725
Albany, Oregon 97321
(541) 928-2683

G-17577