


NOT
IN
10/9/19

THIS MAP IS FOR WATER
RIGHT INFORMATION ONLY

KLAMATH ADJUDICATION
CLAIM # 93 PAGE # 00028

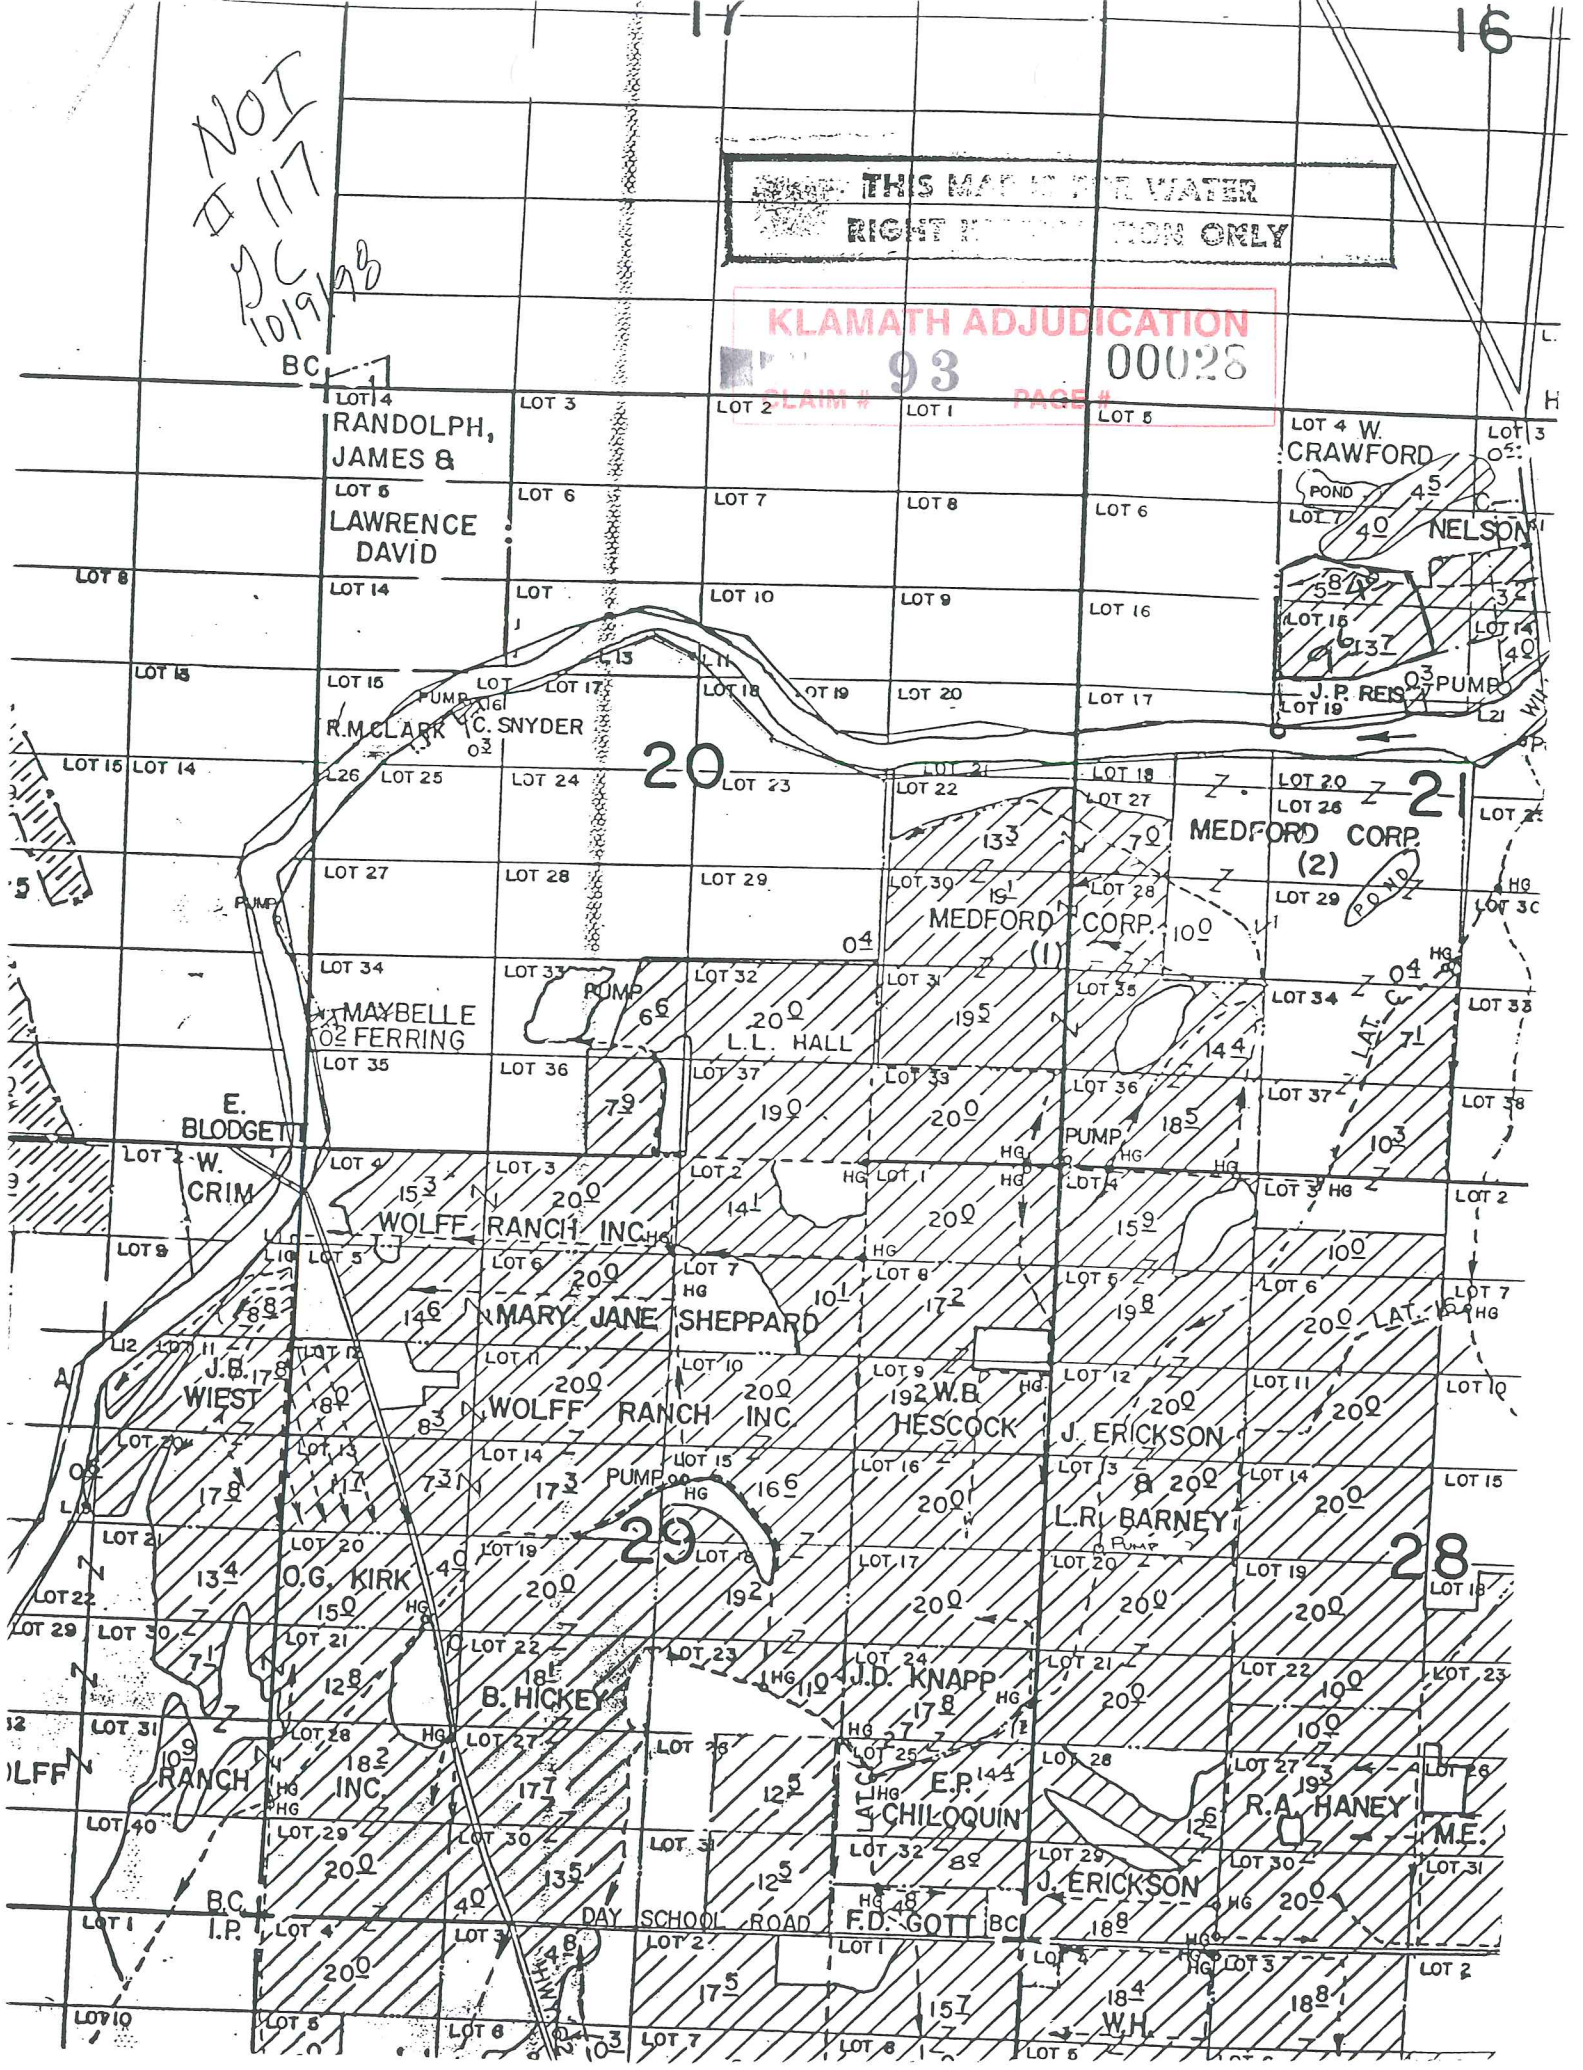

LOT 4
RANDOLPH,
JAMES &
LOT 5
LAWRENCE
DAVID

LOT 4 W.
CRAWFORD
POND
LOT 7
NELSON
LOT 15
LOT 14
LOT 19
J.P. REIS
PUMP

LOT 15
R.M. CLARK
LOT 16
C. SNYDER

MEDFORD CORP
(2)

MAYBELLE
FERRING

L.L. HALL

E. BLODGETT

WOLFF RANCH INC.

MARY JANE SHEPPARD

J.B. WIEST

WOLFF RANCH INC.

HESCOCK

J. ERICKSON

O.G. KIRK

B. HICKEY

J.D. KNAPP

E.P. CHILOQUIN

R.A. HANEY

I.P.

F.D. GOTT

J. ERICKSON

W.H.