


T.36S.R.11&12E.W.M.

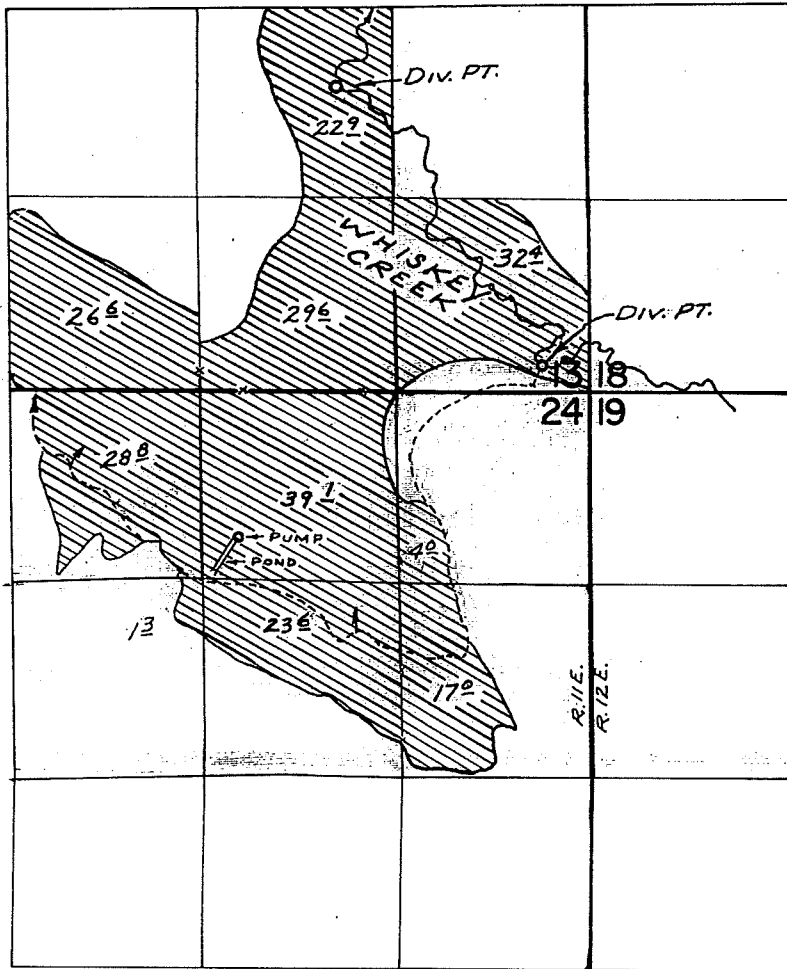

DIV. PT. LOC: 180' N. & 2340' E. FROM S 1/4 COR. SEC. 13
 2080' N & 930' E. FROM S 1/4 COR. SEC. 13

FINAL PROOF SURVEY
 UNDER

Application No. 42,541 Permit No. 31,725
 IN NAME OF

BRUCE S. & VIRGINIA A. TOPHAM

Surveyed OCT. 28, 1974, by R. MUCKEN
APR. 12, 1978 D.E. KNAUER

Claim # 117
 L. Juul
 10-27-98

00117 00032

WIP FILE PAGE