


TOWNSHIP 16 SOUTH, RANGE 22 EAST, W.M.

RECEIVED BY OWRD

JUL 09 2015

SALEM, OR

Well #6

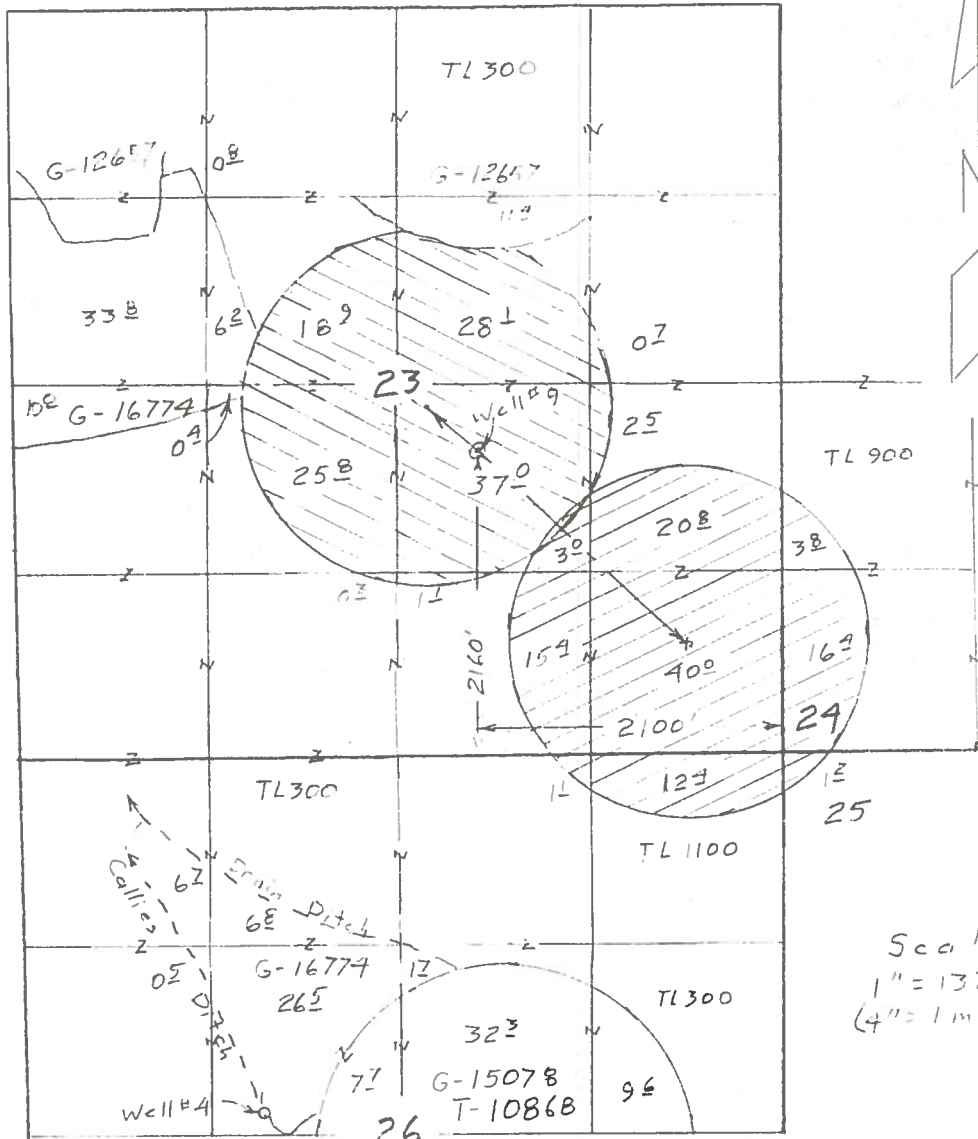


Scale
1" = 1320'
(4" = 1 mile)

App G-17607

- ⊙ SR#1 114 $\frac{1}{2}$ acres
- ⊙ SR#2 114 $\frac{1}{2}$ acres

Application Map
for
Gutierrez Cattle Co.

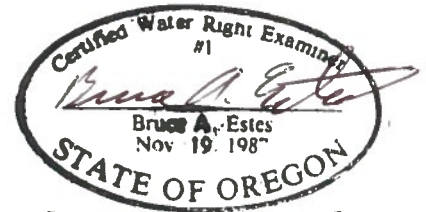

Renewal Dec 31, 2015

Sheet 2 of 2


ESTES SURVEYS, LLC
 PO Box 17510 60382 Arnold Rd.
 Salem, OR 97305-7510 Bend, OR 97702
 (503) 585-7503 (541) 382-7331

This map is for the purpose of locating a water right only and has no intent to provide legal dimensions or the location of property lines.

Amended March 7, 2014 & July 4, 2015

G-17607

TOWNSHIP 16 SOUTH, RANGES 22 & 23 EAST, W.M.

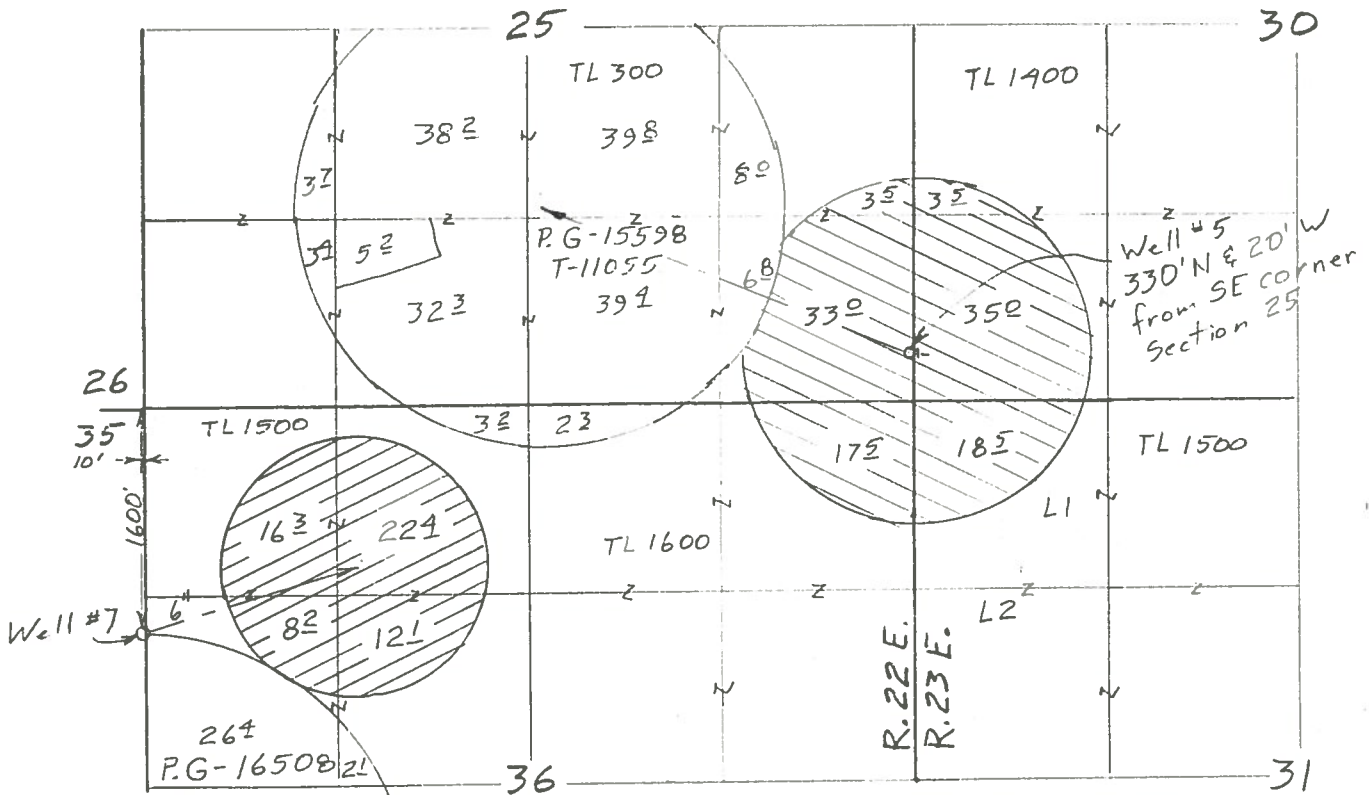

- ⊘ Well #5 111⁰ acres
- ⊘ Well #7 59⁰ acres




Scale 1" = 1320'
(4" = 1 mile)

App G-17607
RECEIVED BY OWRD

APR 07 2014

Application Map
for
Gutierrez Cattle Co.

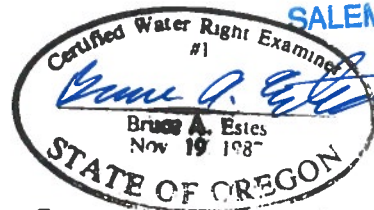

Renewal Dec 31, 2013


Sheet 1 of 2

This map is for the purpose of locating a water right only and has no intent to provide legal dimensions or the location of property lines.

ESTES SURVEYS, LLC
 PO Box 17516 Salem, OR 97305-7516 (503) 585-7595
 60382 Arnold Rd Bend, OR 97702 (541) 382-7391

SUPERCEDED BY
JULY 9,
2015
map

TOWNSHIP 16 SOUTH, RANGE 22 EAST, W.M.

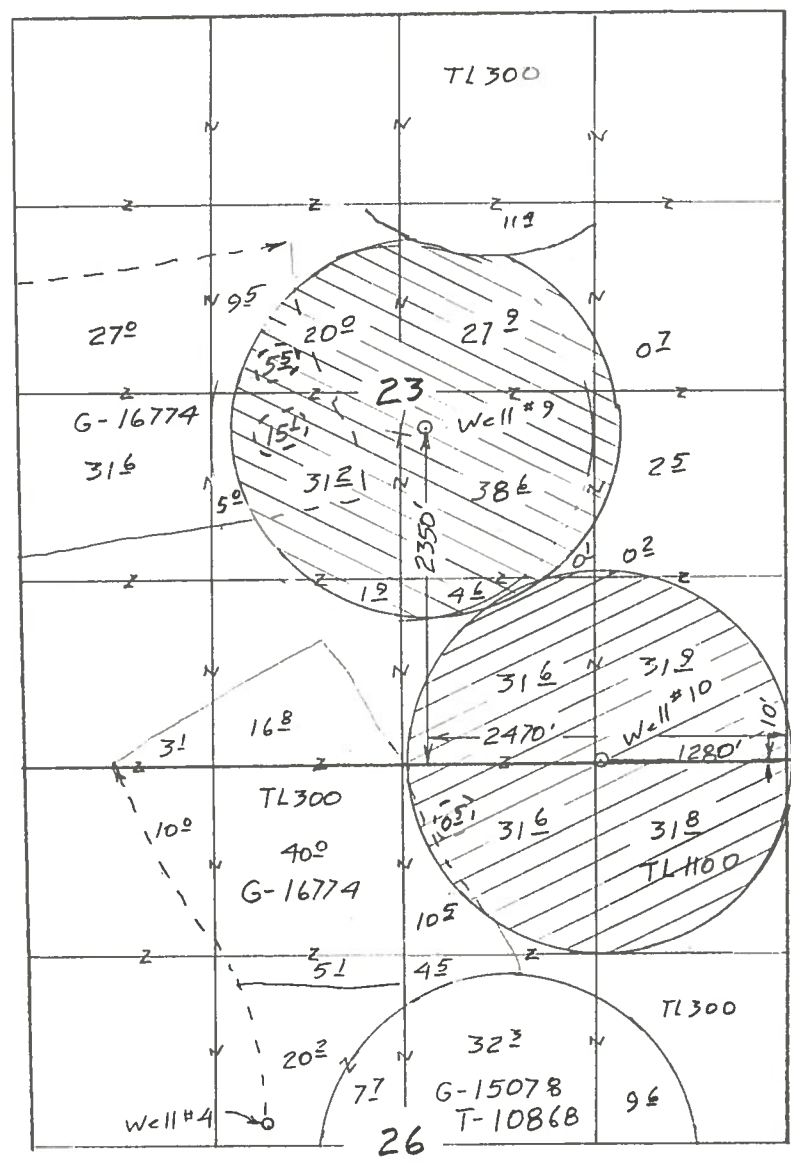

Scale 1" = 1320'
(4" = 1 mile)

Well #6


RECEIVED BY OWRD

- (-) Delete 2 1/2 acres from PG-16774
- ⊙ Well #9 127 1/2
- ⊙ Well #10 127 1/2

App G-17607 APR 07 2014

SALEM, OR

Application Map
for
Gutierrez Cattle Co.

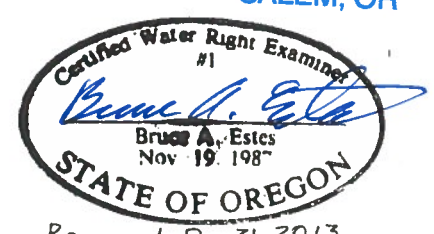

Renewal Dec 31, 2013
Sheet 2 of 2


ESTES SURVEYS, LLC
 PO-Box 47519-60382 Arnold Rd.
 Salem, OR 97306-7640 Bend, OR 97702
 (503) 585-7503 (541) 382-7331

This map is for the purpose of locating a water right only and has no intent to provide legal dimensions or the location of property lines.

amended March 7, 2014

Superseded by
JULY 9, 2015
map

TOWNSHIP 16 SOUTH, RANGE 22 EAST, W.M.

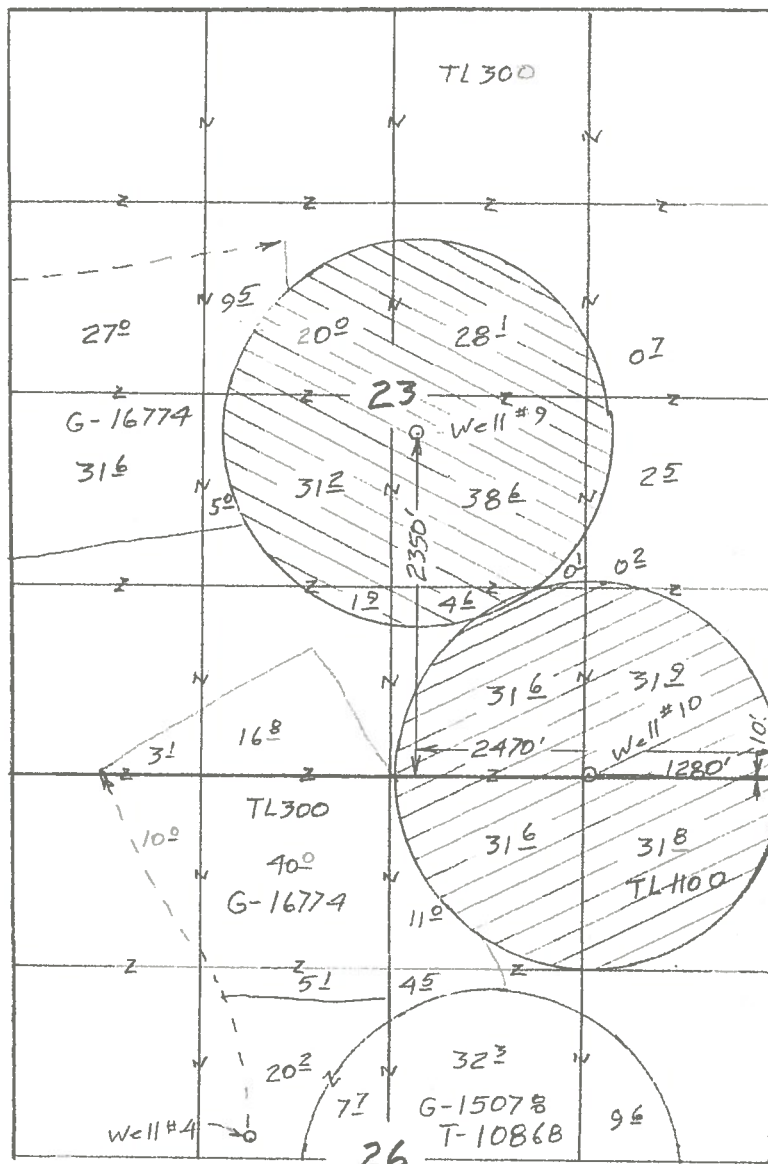

Scale 1" = 1320'
(4" = 1 mile)

Well #6 ○

RECEIVED BY OWR.

DEC 14 2012

SALEM, OR

RECEIVED BY OWRD

- ⊗ Well #9 127.6
- ⊗ Well #10 127.6

Application Map for Gutierrez Cattle Co.


Application states 425
acres for irrigation.
Maps indicates 425.2
acres for irrigation.

This map is for the purpose of
locating a water right only
and has no intent to provide
legal dimensions or the location
of property lines.

(541) 382-7331

Superseded by
 APRIL 7,
 2014
 Map

TOWNSHIP 16 SOUTH, RANGES 22 & 23 EAST, W.M.

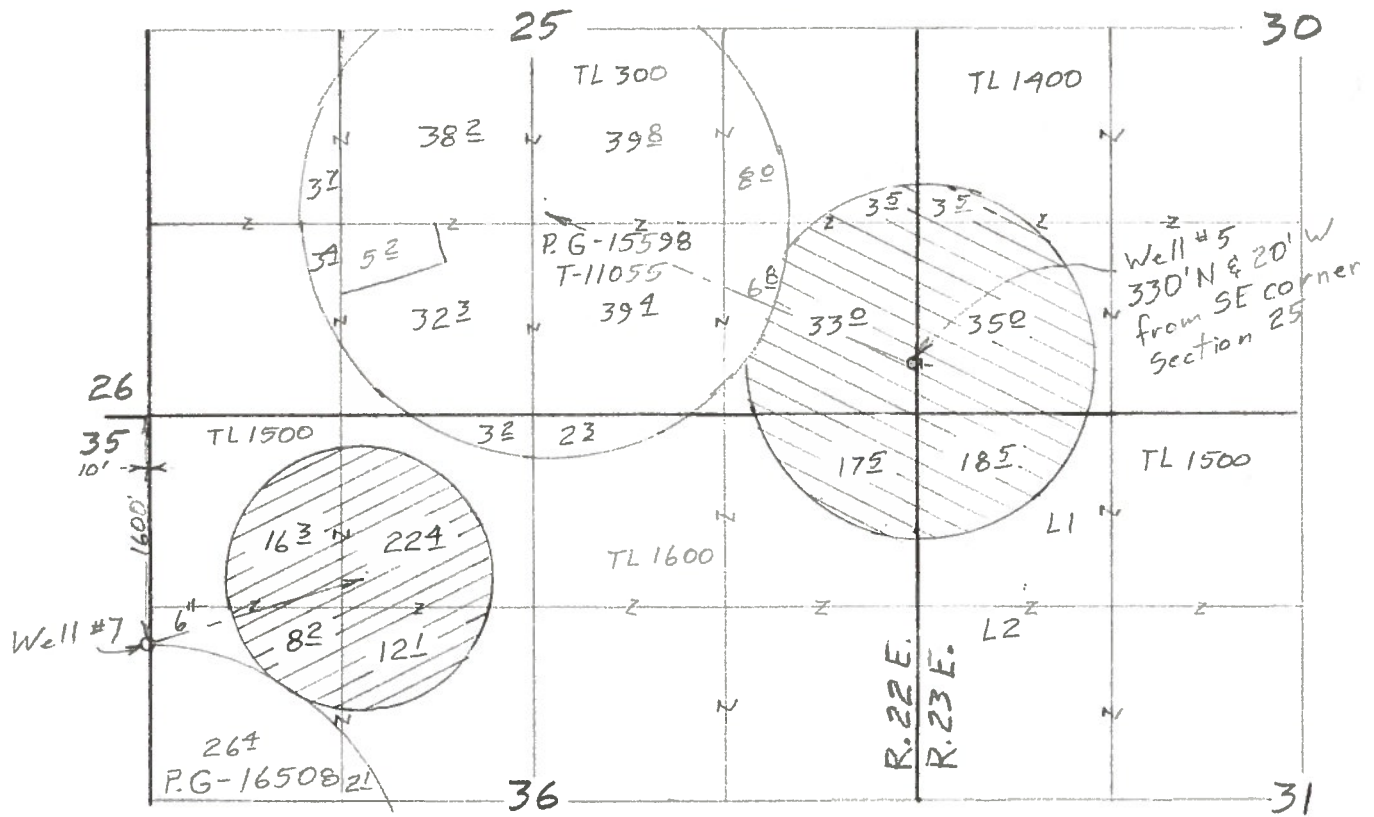

- ⊙ Well #5 111⁰ acres
- ⊙ Well #7 59⁰ acres

RECEIVED BY OWRD

DEC 14 2012

SALEM, OR


Scale 1" = 1320'
 (4" = 1 mile)

RECEIVED BY OWRD

DEC 03 2012

SALEM, OR

Application Map
 for
 Gutierrez Cattle Co.

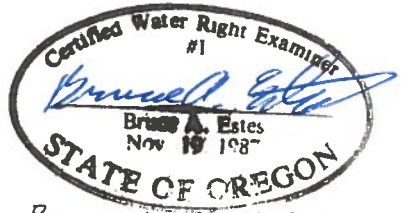

Renewal Dec 31, 2013

Sheet 1 of 2

This map is for the purpose of locating a water right only and has no intent to provide legal dimensions or the location of property lines.

ESTES SURVEYS, LLC
 PO Box 17510 60382 Arnoka Rd
 Salem, OR 97305-7510 Bend, OR 97702
 (503) 686-7593 (541) 382-7391