


TOWNSHIP 30 SOUTH, RANGE 10 E, W.M.

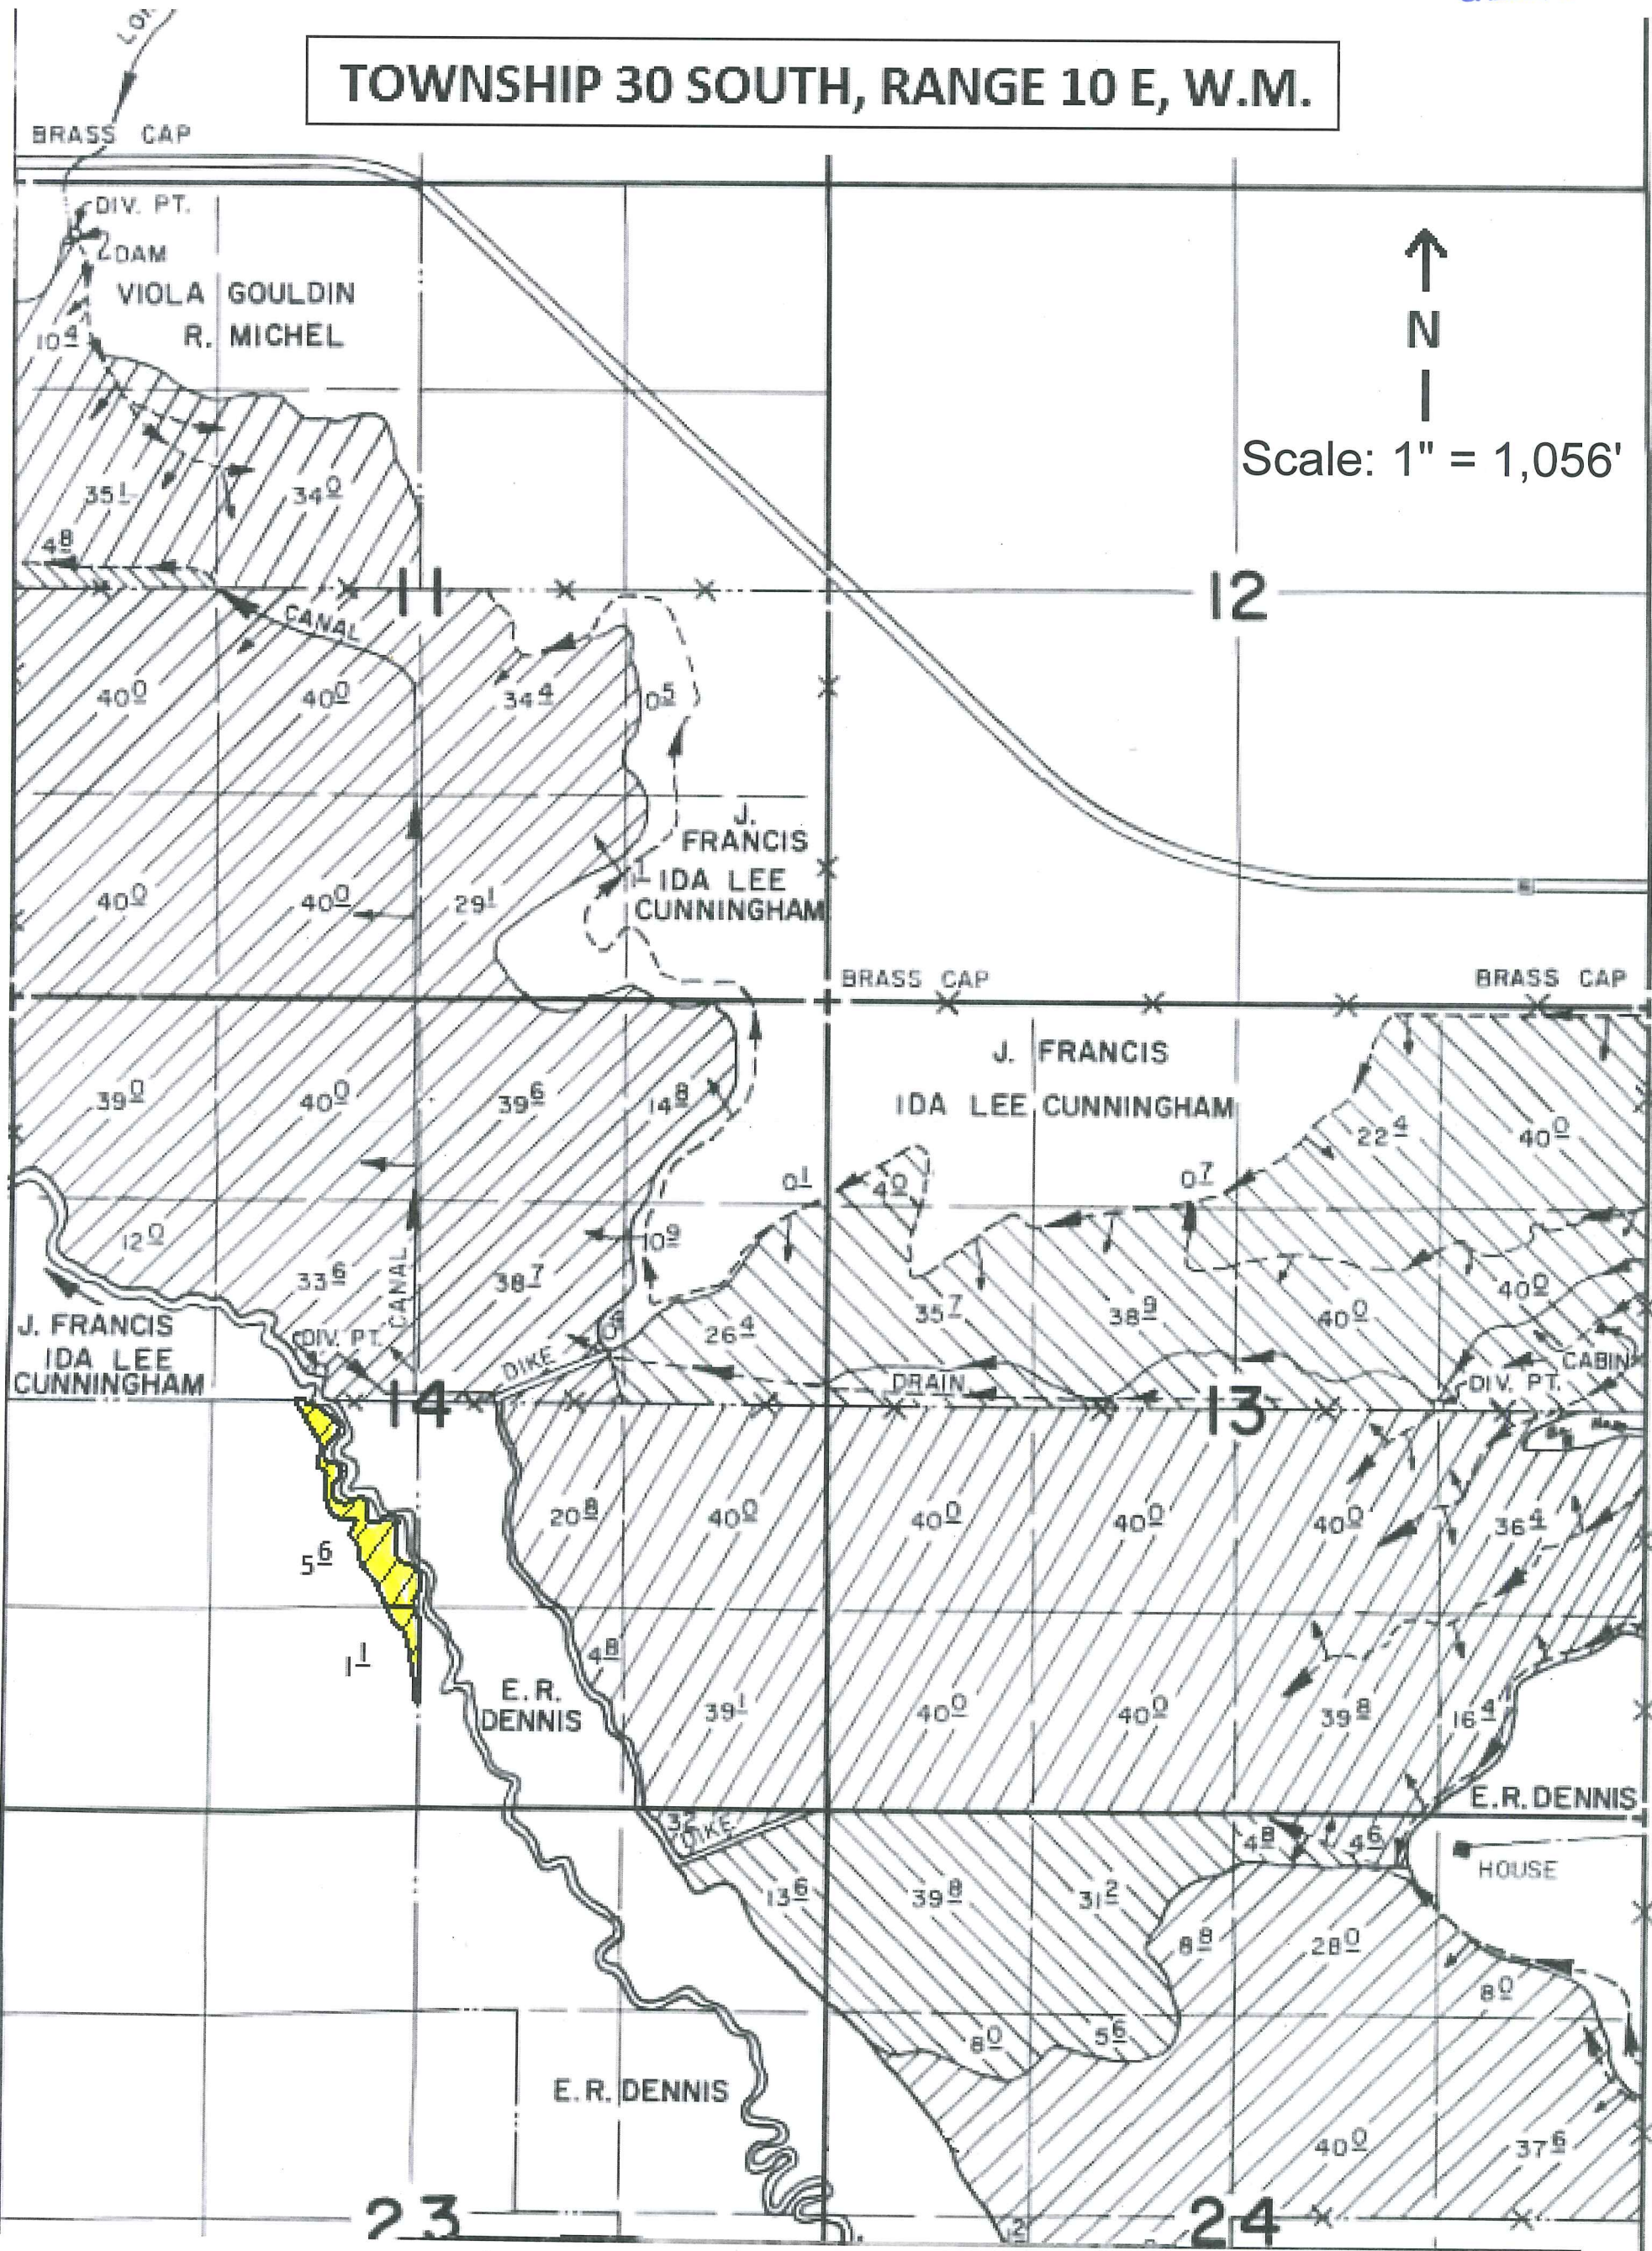

↑
N
↓
Scale: 1" = 1,056'

SEE ALSO T. 30 S., R. 11 E.