


2N 10W Sec 9

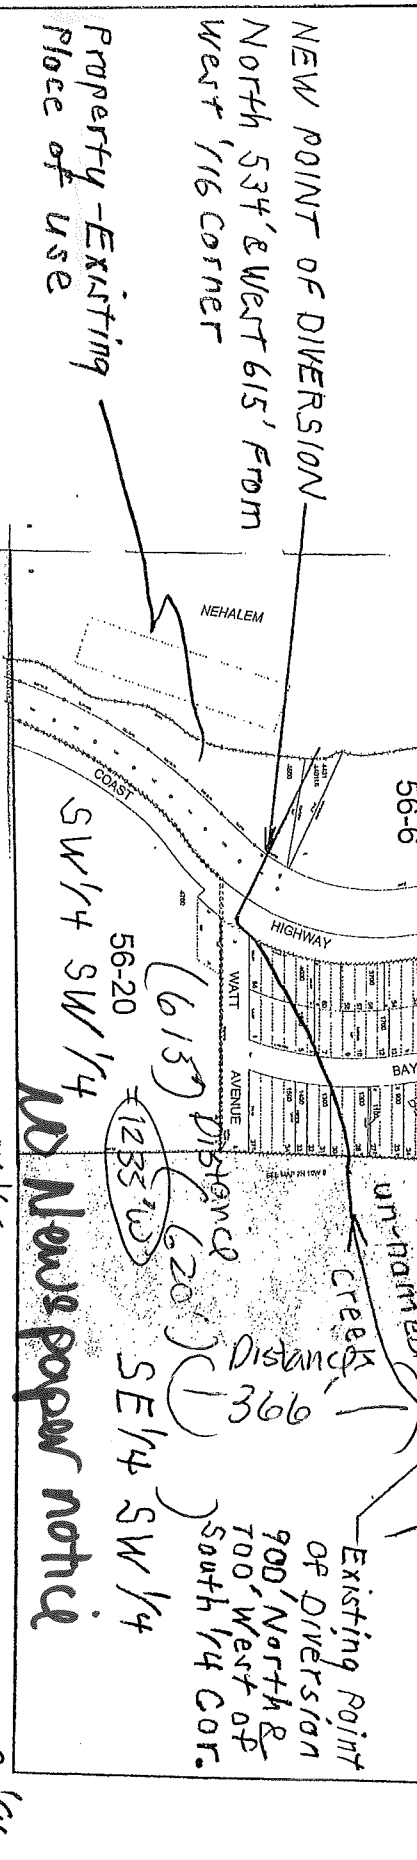

SCALE 1"=400'




NOTES

THIS MAP DOES NOT CONSTITUTE A BOUNDARY SURVEY. FOR BOUNDARY INFORMATION SEE MAP B-989 AND A-4129, TILLAMOOK COUNTY SURVEY RECORDS.

THE PURPOSE OF THIS MAP IS TO SHOW THE LOCATION OF THE NEW POINT OF DIVERSION FOR THE WATER RIGHTS TRANSFER.

APPLICATION S 21876, PERMIT S 17904 AND CERTIFICATE # 23644

USES ARE AS FOLLOWS:
ONE HOUSE AND 40.5 ACRE IS BEING IRRIGATED.

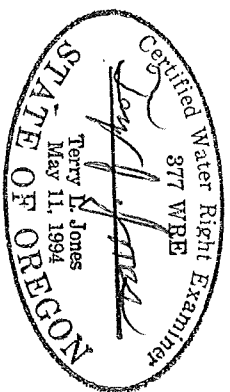

DATE AUG. 17, 2010		EQUIPMENT TOPCON GPT-3003W TDS NOMAD		FIELD TLJ/DWE		DRAWN JDM		CHECKED TLJ		JOB NO.	
SURVEY BY: BAYSIDE SURVEYING 11765 HWY 101 SOUTH TILLAMOOK, OR. 97141 (503) 842-5551						WATER RIGHTS MAP FOR: RON AGRESTI LANDS DESCRIBED IN DEED INSTRUMENT NUMBER 2010-3868 TILLAMOOK COUNTY DEED RECORDS SW 1/4, SW 1/4, SECTION 9, T.2N., R.10W., W.M. TILLAMOOK COUNTY, OREGON					
RECEIVED SEP 10 2010 WATER RESOURCES DEPT SALEM, OREGON											

111131

2N 10W Sec 9

BASIS OF BEARING

THE LINE BETWEEN THE FOUND MONUMENTS ① AND ③ AS SHOWN HEREON, BEARS NORTH 64° 56' 56" WEST THE RECORD VALUE PER MAP B-989.

MONUMENT NOTES

- ① FOUND 2" IRON PIPE, 0.7' BELOW SURFACE, HELD.
- ③ FOUND 5/8" REBAR WITH YELLOW PLASTIC CAP MARKED "PLS 1205", 0.6' BELOW SURFACE, HELD, SEE MAP B-989.
- ④ FOUND 3" USGS BRASS DISK IN CONCRETE, ELEVATION = 23.46' (NGVD 1929) STAMPED "1 1933"
- ⑤ FOUND 5/8" REBAR WITH YELLOW PLASTIC CAP MARKED "PLS 1098", SMASHED, SEE MAP A-4129.



TOP OF JETTY

EDGE OF ROCK PARKING AREA

N64°56'56"W PER MAP B-989
270.17'

TAX LOT 2N 10
9CC 4401

CULVERT = CREEK

TAX LOT 2N 10
9CC 4500

GRAVEL PARKING

BOAT BASIN

CONCRETE WALL

GRASS

RV PARKING
17 SPACES

HOUSE

NEW POINT OF DIVERSION

NORTH 534 FEET AND WEST 615 FEET
FROM WEST 1/16 CORNER ON THE
SOUTH LINE OF SECTION 9, TOWNSHIP
2 NORTH, RANGE 10 WEST, W.M.

PUMP HOUSE

CULVERT = CREEK

COAST HIGHWAY 101

PROPERTY LINE

SHOWER HOUSE

SHOP

FISH CLEANING STATION

CONCRETE WALL

OFFICE BUILDING

RESTROOM

NOTES

THIS MAP DOES NOT CONSTITUTE A BOUNDARY SURVEY.
FOR BOUNDARY INFORMATION SEE MAP B-989 AND
A-4129, TILLAMOOK COUNTY SURVEY RECORDS.

THE PURPOSE OF THIS MAP IS TO SHOW THE LOCATION
OF THE NEW POINT OF DIVERSION FOR THE WATER
RIGHTS TRANSFER.

THE BOUNDARY SHOW WAS DRAWN AS PER RECORD
VALUES FROM MAP B-989.

APPLICATION S 21876, PERMIT S 17904 AND CERTIFICATE
23644

USES ARE AS FOLLOWS:
ONE HOUSE AND ±0.5 ACRE IS BEING IRRIGATED.

RECEIVED

SEP 10 2010

WATER RESOURCES DEPT
SALEM, OREGON

DETAIL MAP TO ACCOMPANY

WATER RIGHTS MAP FOR:

RON AGRESTI

LANDS DESCRIBED IN DEED

INSTRUMENT NUMBER 2010-3868

TILLAMOOK COUNTY DEED RECORDS

SW 1/4, SW 1/4, SECTION 9, T.2N., R.10W., W.M.

TILLAMOOK COUNTY, OREGON

SITE/AGRESTI.DWG
AGRESTI.CR5

SURVEY BY:

BAYSIDE SURVEYING

11765 HWY 101 SOUTH
TILLAMOOK, OR. 97141
(503) 842-5551

DATE

AUG. 17, 2010

EQUIPMENT

TOPCON GPT-3003W
TDS NOMAD

FIELD

TLJ/DWE

DRAWN

JDM

CHECKED

TLJ


JOB NO.

① Verify if the
rights are actually
here.
② Verify ownership

T 11/31

S.W. 1/4 S.W. 1/4 SEC. 9 T. 2N. R. 10W. W.M.
Tillamook County
1" = 100'

02N10W09CC
BRIGHTON BEACH

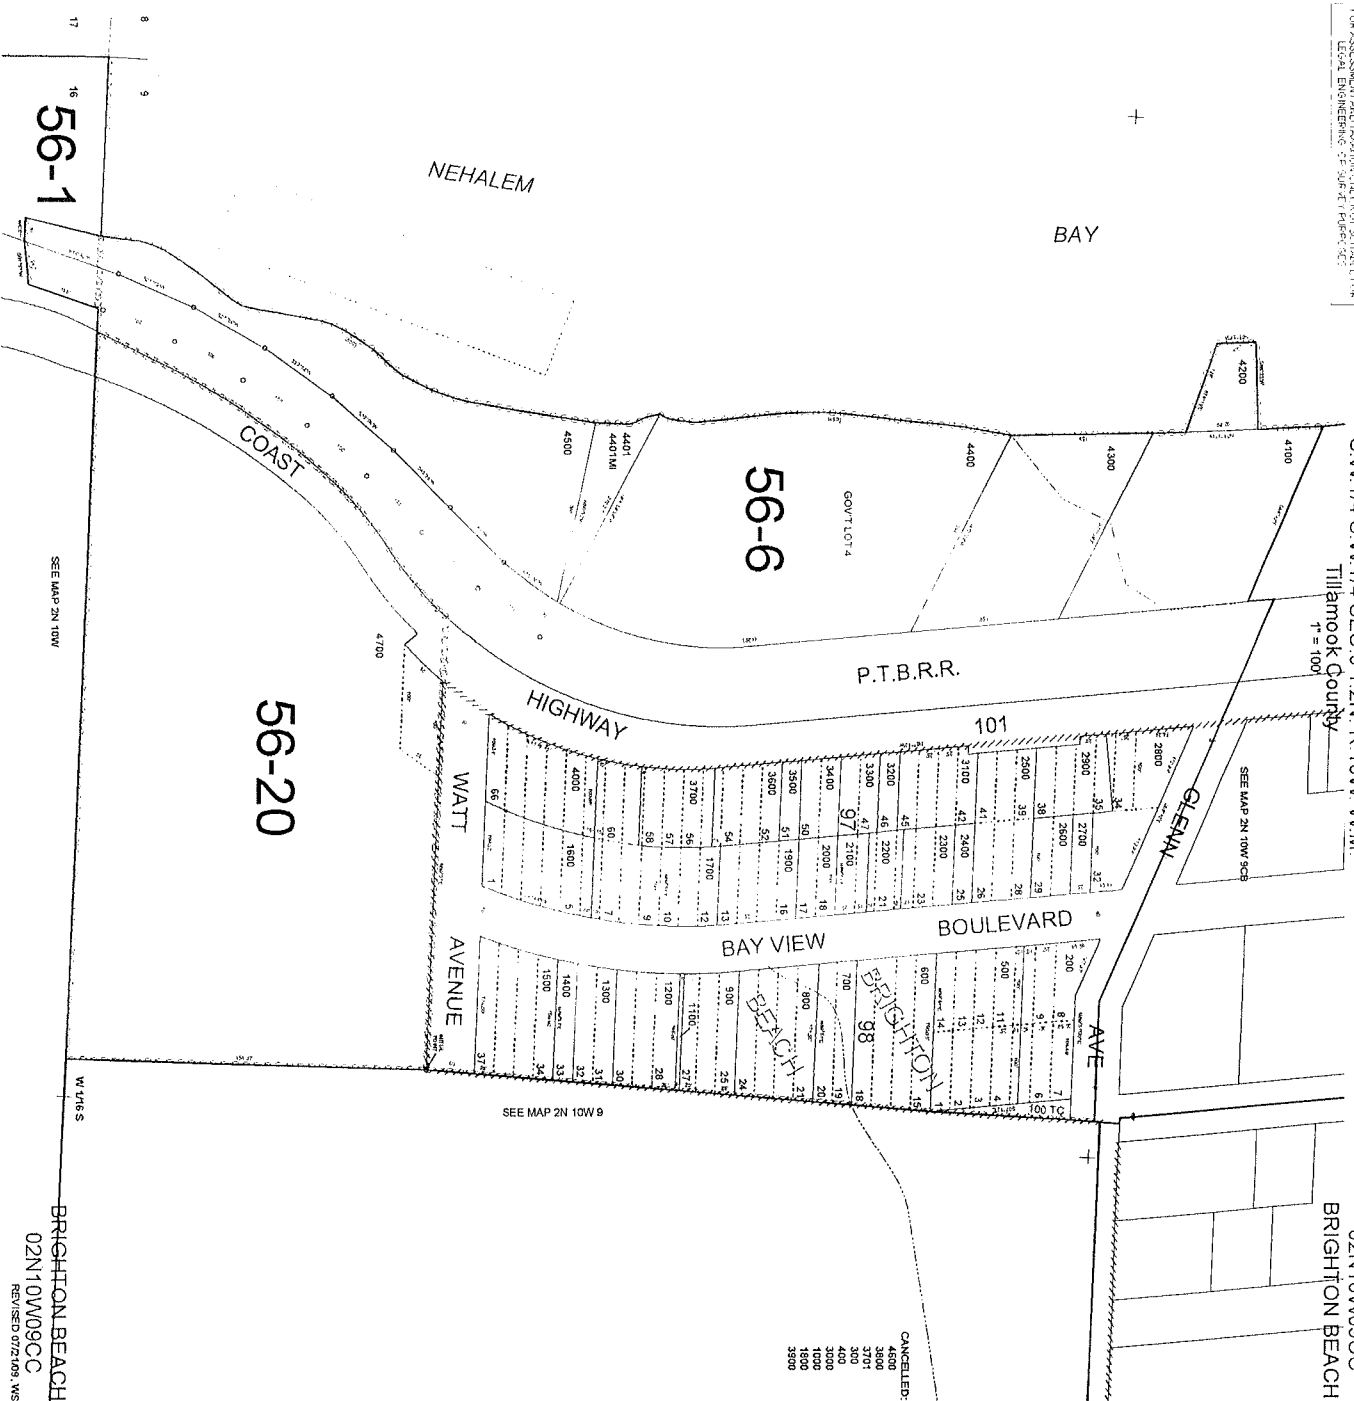


CANCELED:
4800
3701
300
400
1000
1800
3800

SEE MAP 2N 10W
BRIGTON BEACH
02N10W09CC
REVISED 07/2/09, WS

THIS MAP WAS PREPARED FOR
ASSESSMENT PURPOSE ONLY

SECTION 9 1.2N. R.10W. W.M.
TILLAMOOK COUNTY
1" = 400'

2N 10 9
& INDEX

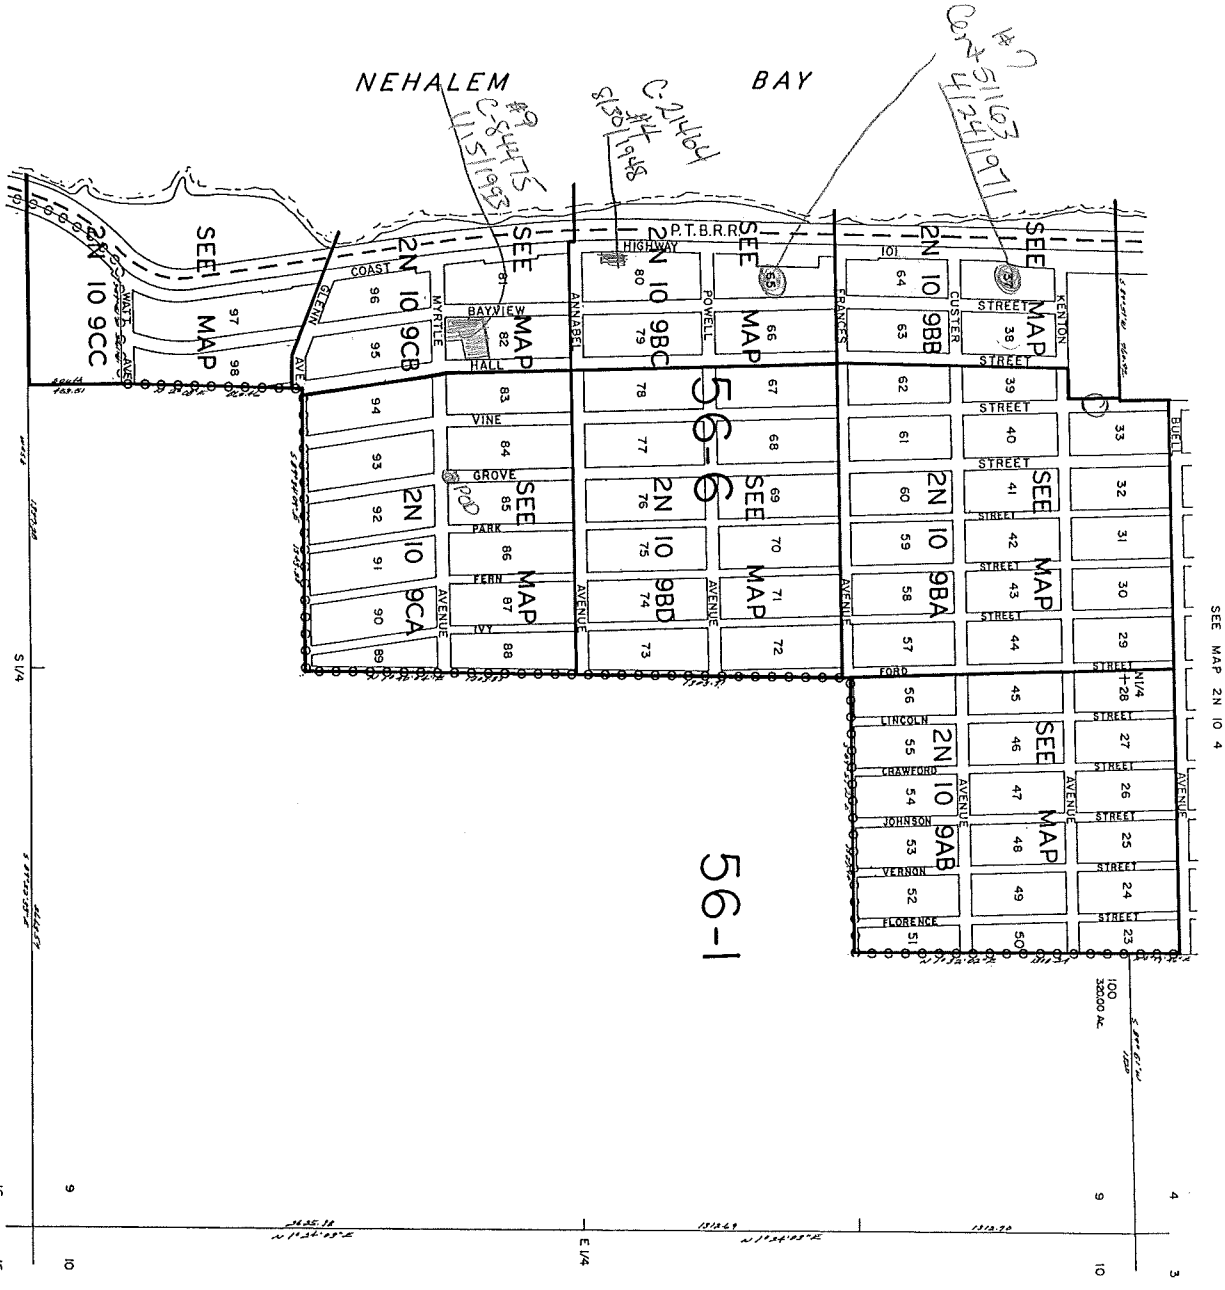

SEE MAP 2N 10

SEE MAP 2N 10


2N 10 9
REVISED 3-3-99, BPH

THIS MAP WAS PREPARED FOR
ASSESSMENT PURPOSE ONLY

NW1/4 SW1/4 SEC. 9 T.2N. R.10W. W.M.
TILLAMOOK COUNTY
1" = 100'

2N 10 9CB
BRIGHTON
BEACH

SEE MAP 2N 10 9BC

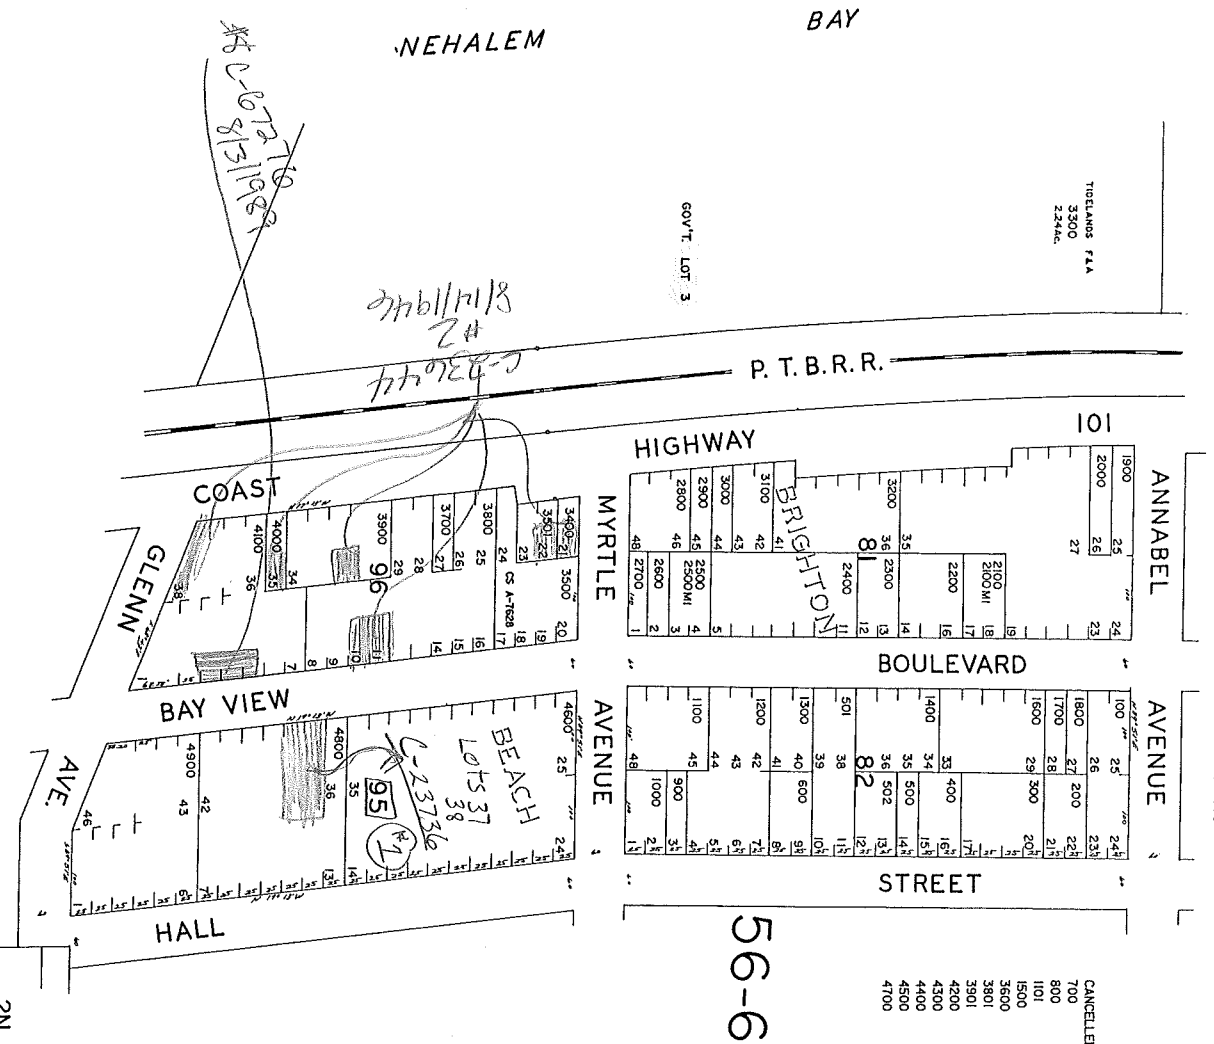

SEE MAP 2N 10 9CA

SEE MAP 2N 10 9CC

2N 10 9CB
REVISED 04/02/01, KA

