
UPDATED SUPPLEMENTAL MAP FOR CLAIM 317

DENOTING IRRIGATED LANDS




IN THE NAME OF: US FISH AND WILDLIFE SERVICE
TULE LAKE NATIONAL WILDLIFE REFUGE

 

1 INCH = 1320 FEET JANUARY 10, 2013



Machine

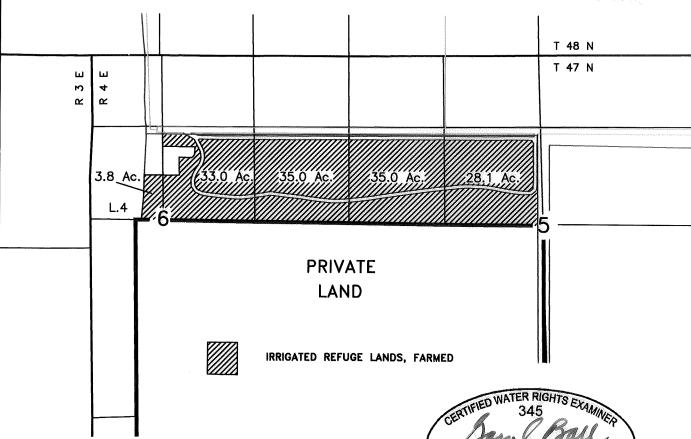

Amendment to the OWRD adjudication maps depicting the current limits of water use

Acreages shown are only for those quarter/quarter subdivisions or lots where a change in place of use has been made.

ADDITIONAL IRRIGATED REFUGE LANDS, FARMED ARE SHOWN ON OWRD MAPS FOR TOWNSHIPS T. 41 S. R. 8 E., T. 41 S. R. 9 E., AND T. 41 S. R. 10 E.

MAY 18, 1993 FOF OREGON

RENEWS: 12/31/2013

This map is based on previously submitted maps of record prepared by the USFWS and has been updated only to identify the lands as "Irrigated Refuge Lands, Farmed" and/or "Irrigated Refuge Lands, Non-Farmed."

This map is not intended to provide legal dimensions or locations of property lines.