

THIS MAP WAS PREPARED FOR
ASSESSMENT PURPOSE ONLY.


SEC. 25 T.23S. R.10W. W.M.
DOUGLAS COUNTY

REVISED ON
3-7-07

23 10 25

1" = 400'

SEE MAP 23 10 24

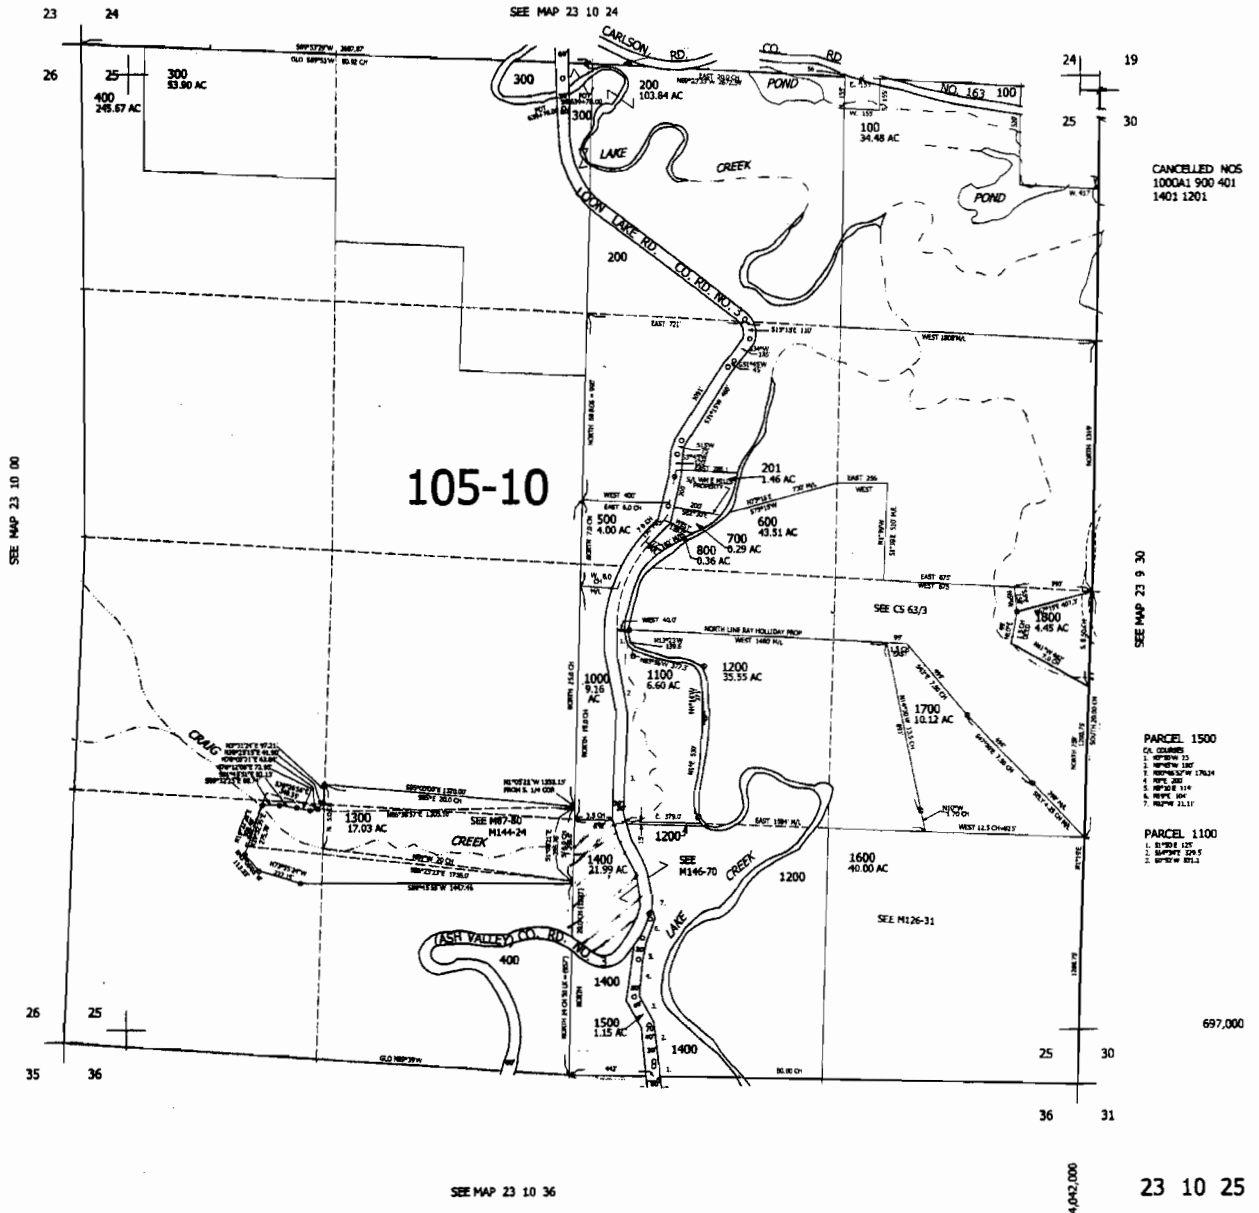

SEE MAP 23 10 36

4,042,000


23 10 25

RECEIVED BY OWRD

FEB 07 2013

SALEM, OR

T.23S.R.10W.W.M.

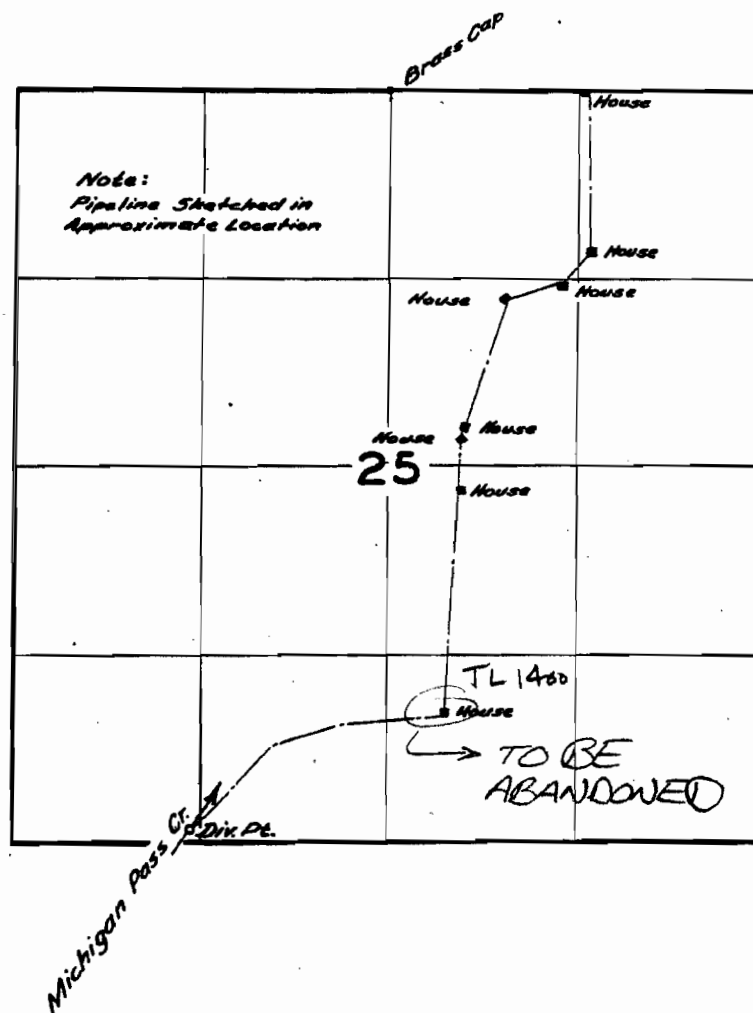

FINAL PROOF SURVEY
UNDER

Application No. 29442 Permit No. 23172
IN NAME OF

Helen M. Judy, et al

Surveyed June 22 1968, by C.D. Smith

RECEIVED BY OWRD

FEB 07 2013

SALEM, OR

$1'' = 400'$

SEE MAP 23 10 24

SEE MAP 23 10 00

CANCELLED NOS
1000A1 900 401
1401 1201

SEE MAP 23 9 30

PARCEL 1500
CA. COUSINGS


697,000

SEE MAP 23 10 36

4,042,000

23 10 25

RECEIVED BY OWRD
FEB 07 2013
SALEM, OR