


T24S, R30E,
T24S, R31E,

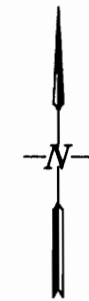

W1 - 2640 FT N AND 2640 W OF THE SE CORNER OF SECTION 1, T25S R30E
W2 - 2640 FT N OF THE SE CORNER OF SECTION 1, T25S R30E
W3 - 2640 FT N AND 2640 FT E OF THE SE CORNER OF SECTION 6, T25S R31E
W4 - 1320 FT N AND 2640 FT E OF THE SE CORNER OF SECTION 6, T25S R31E
W5 - 1320 FT E OF THE SE CORNER OF SECTION 6, T25S R31E

WATER RESOURCES DEPT
SALEM, OREGON