


T. 24 S. R. 32 E. W. M.

APPROX LOCATION of WELL from
NE CORNER of SECTION 5
1660 ft SOUTH
& 750 ft WEST

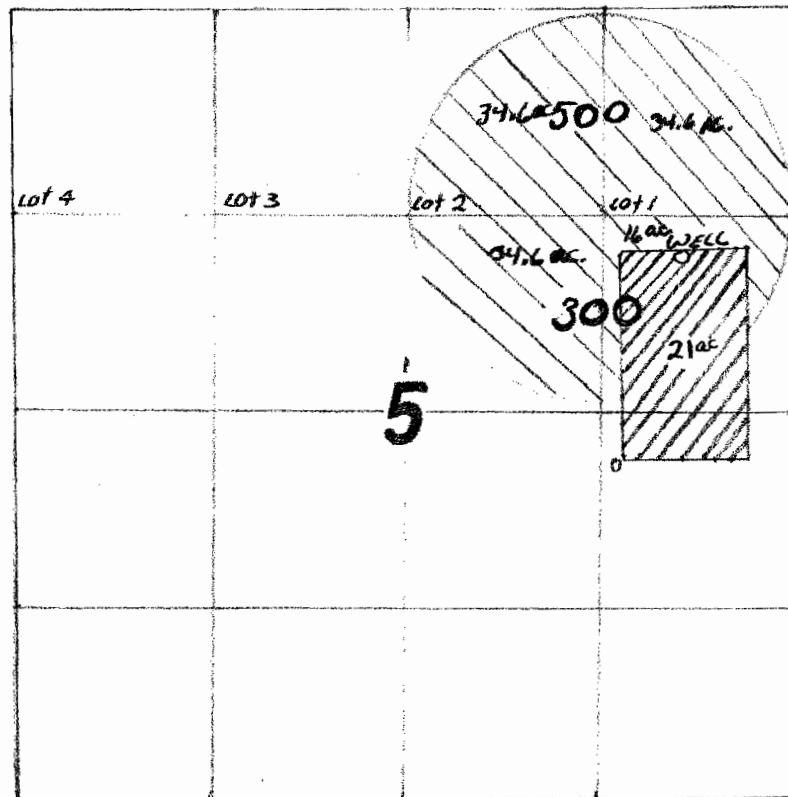

ACRES ADD TO
119.8 ACRES

KENT & DARLA SCOTT

1"=1320'

RECEIVED

NOV 20 2006

WATER RESOURCES DEPT
SALEM, OREGON