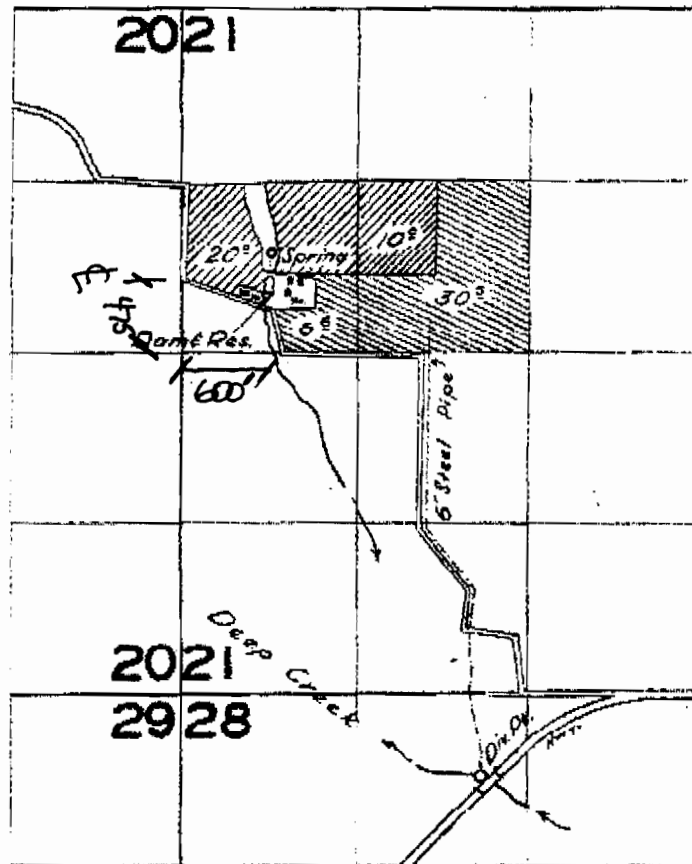


T.2S.R.4E.W.W.

TAX LOT # 00600

NORTH
↑

FINAL PROOF SURVEY

UNDER

23140

18233

25284

20503

R-25283

R-1195

Application No. 26930 Permit No. 81651

IN NAME OF

SHIGEMARI NAGAE
NAGAE BROS.Surveyed 22 June 1956, by *[Signature]*

RECEIVED

FEB 25 2013

WATER RESOURCES DEPT
SALEM, OREGON

DFK-4D-16

App R-87872

SEE MAP 2 4E 16

<u>YL</u>	<u>ADD</u>
102	34061
106	34081
108	34121
110	34141
1101	14540
1300	19960




SEE MAP 2 4E 20

TBR

SEE MAP
2 4E 2ICA

R.R.F.F.-8

EFU

46-19

TBR

46-21

46-04

18500

CANCELLED T.L'S
900
1303
104
2107

2 19500

20500

2 4E 21

BOOK 22

SEE MAP 2 4E 28

