


T-3745

T. 22 S. R. 4 W.

25 30  
36 31

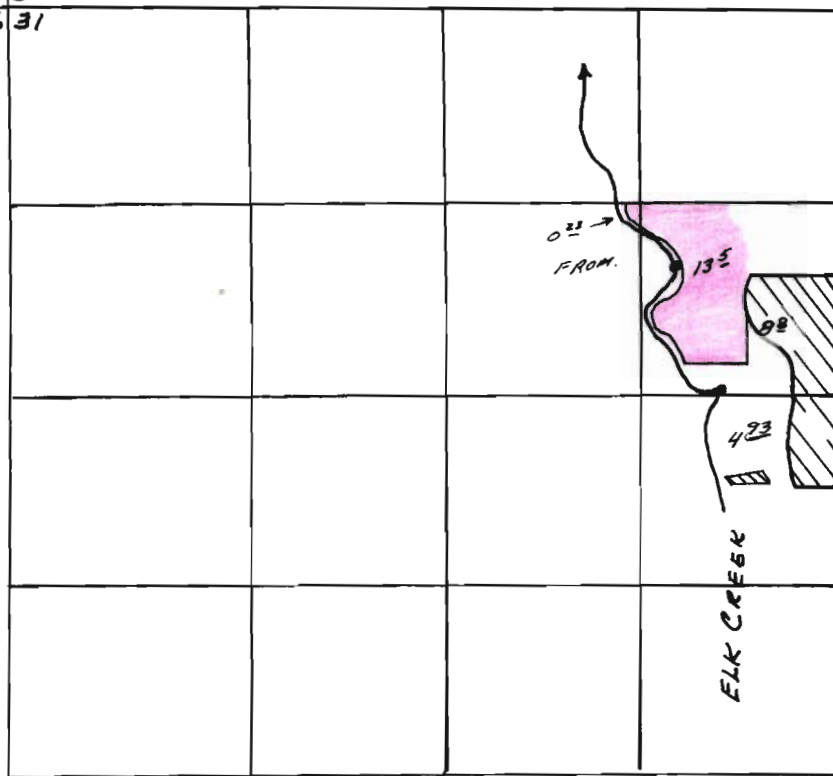

RECEIVED  
JUN - 5 1977  
WATER RESOURCES DEPT  
SALEM, OREGON

To  
15AC.

N.

1" = 1320'

THIS MAP PREPARED BY:  
Elaine M. Youngquist  
FROM INFORMATION FURNISHED BY  
THE APPLICANT.

T-3745


T. 22 S. R. 4 W.

RECEIVED

AUG - 5 1977

WATER RESOURCES DEPT  
SALEM, OREGON

25 30  
36 31

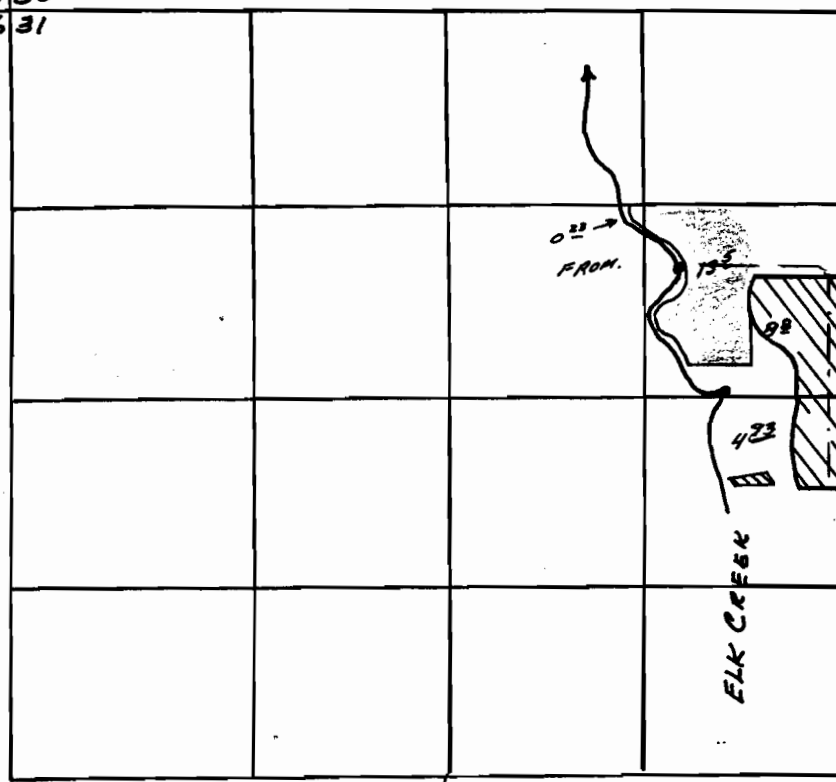

A# 17814, P# 13488

JOHNSON


1" = 1320'

THIS MAP PREPARED BY:

Elaine M. Youngquist

FROM INFORMATION FURNISHED BY  
THE APPLICANT.

T. 22 S., R. 4 W. W.M.

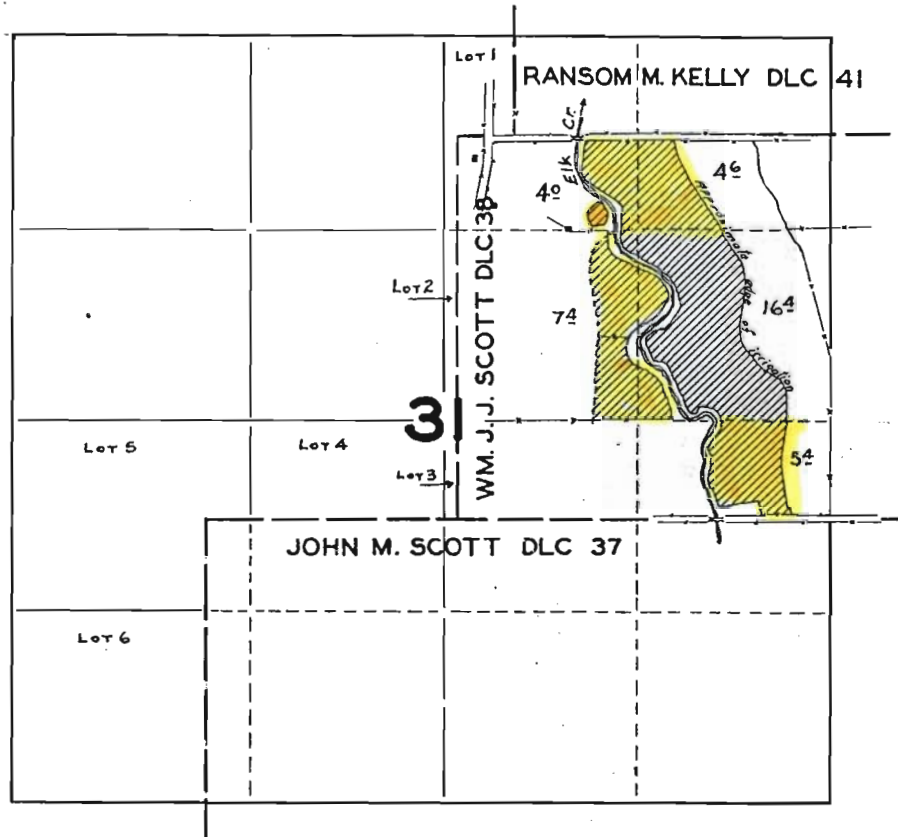

FINAL PROOF SURVEY

UNDER

T-3745

Application No. 17814 Permit No. 13488

IN NAME OF


Gerald Johnson

Surveyed Sept. 14, 1943, by Geo. Maderman

file copy of original prior  
to corrections.  
DL 2/27/2006

T. 22 S., R. 4 W., W. M.

SECTION 31

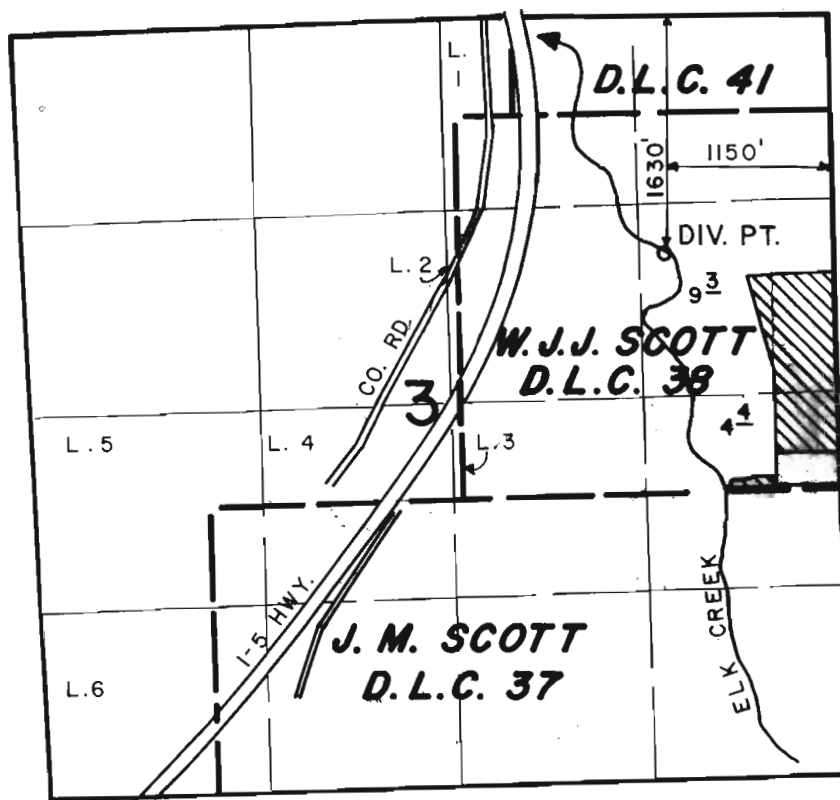

SCALE: 4" = 1 MILE

**FINAL PROOF SURVEY**  
UNDER

TRANSFER NUMBER 3745

IN NAME OF

**ROGER E. JOHNSTON**

Surveyed AUG. 11, 1988, by J.M. SCHMORDE