


T. 38 S., R. 4 W., W.M.

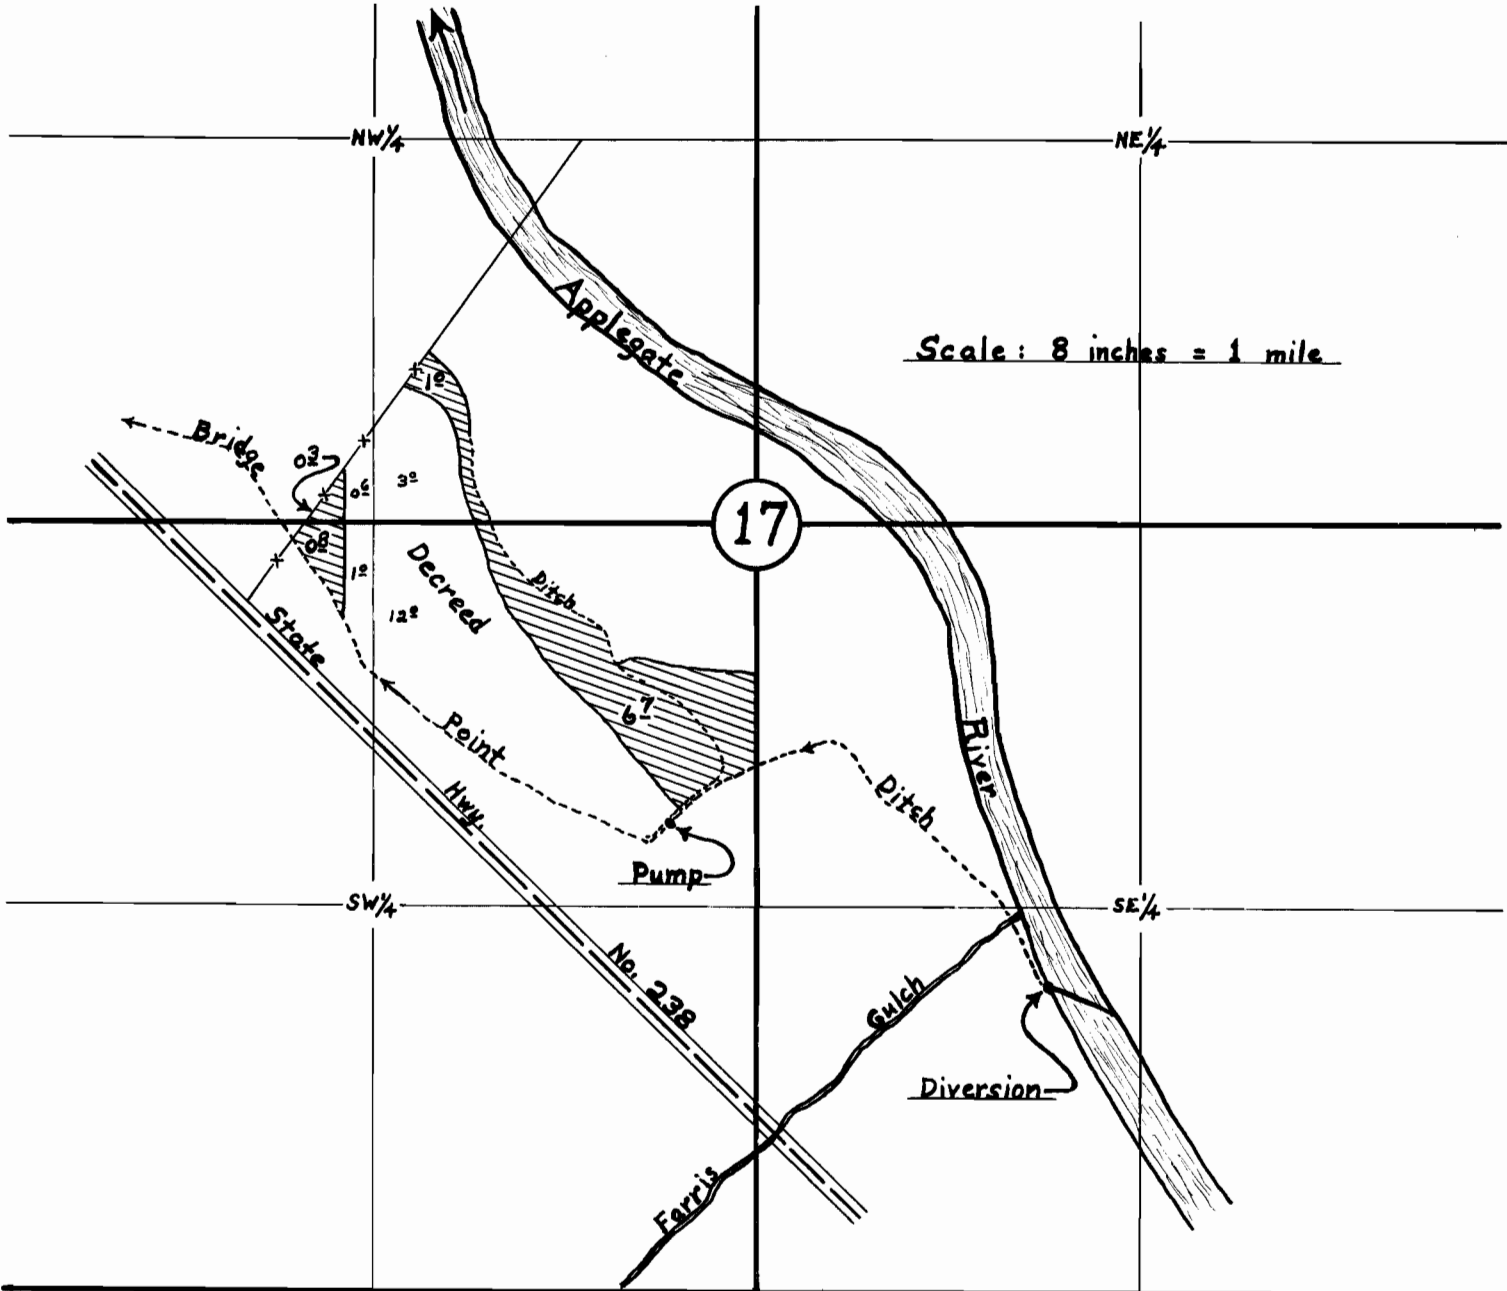

**FINAL PROOF SURVEY**  
UNDER

Application No. 29962... Permit No. 23603  
IN NAME OF

James W. & Dara E. Moss

Surveyed Dec. 17, 1957, by D.C. Hendrix, W.M.