


SECTION

Section 34


Tax Lot 201

1" = 1320

TOWNSHIP 9^{South}, RANGE 5^{West}, W. M.

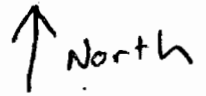

North

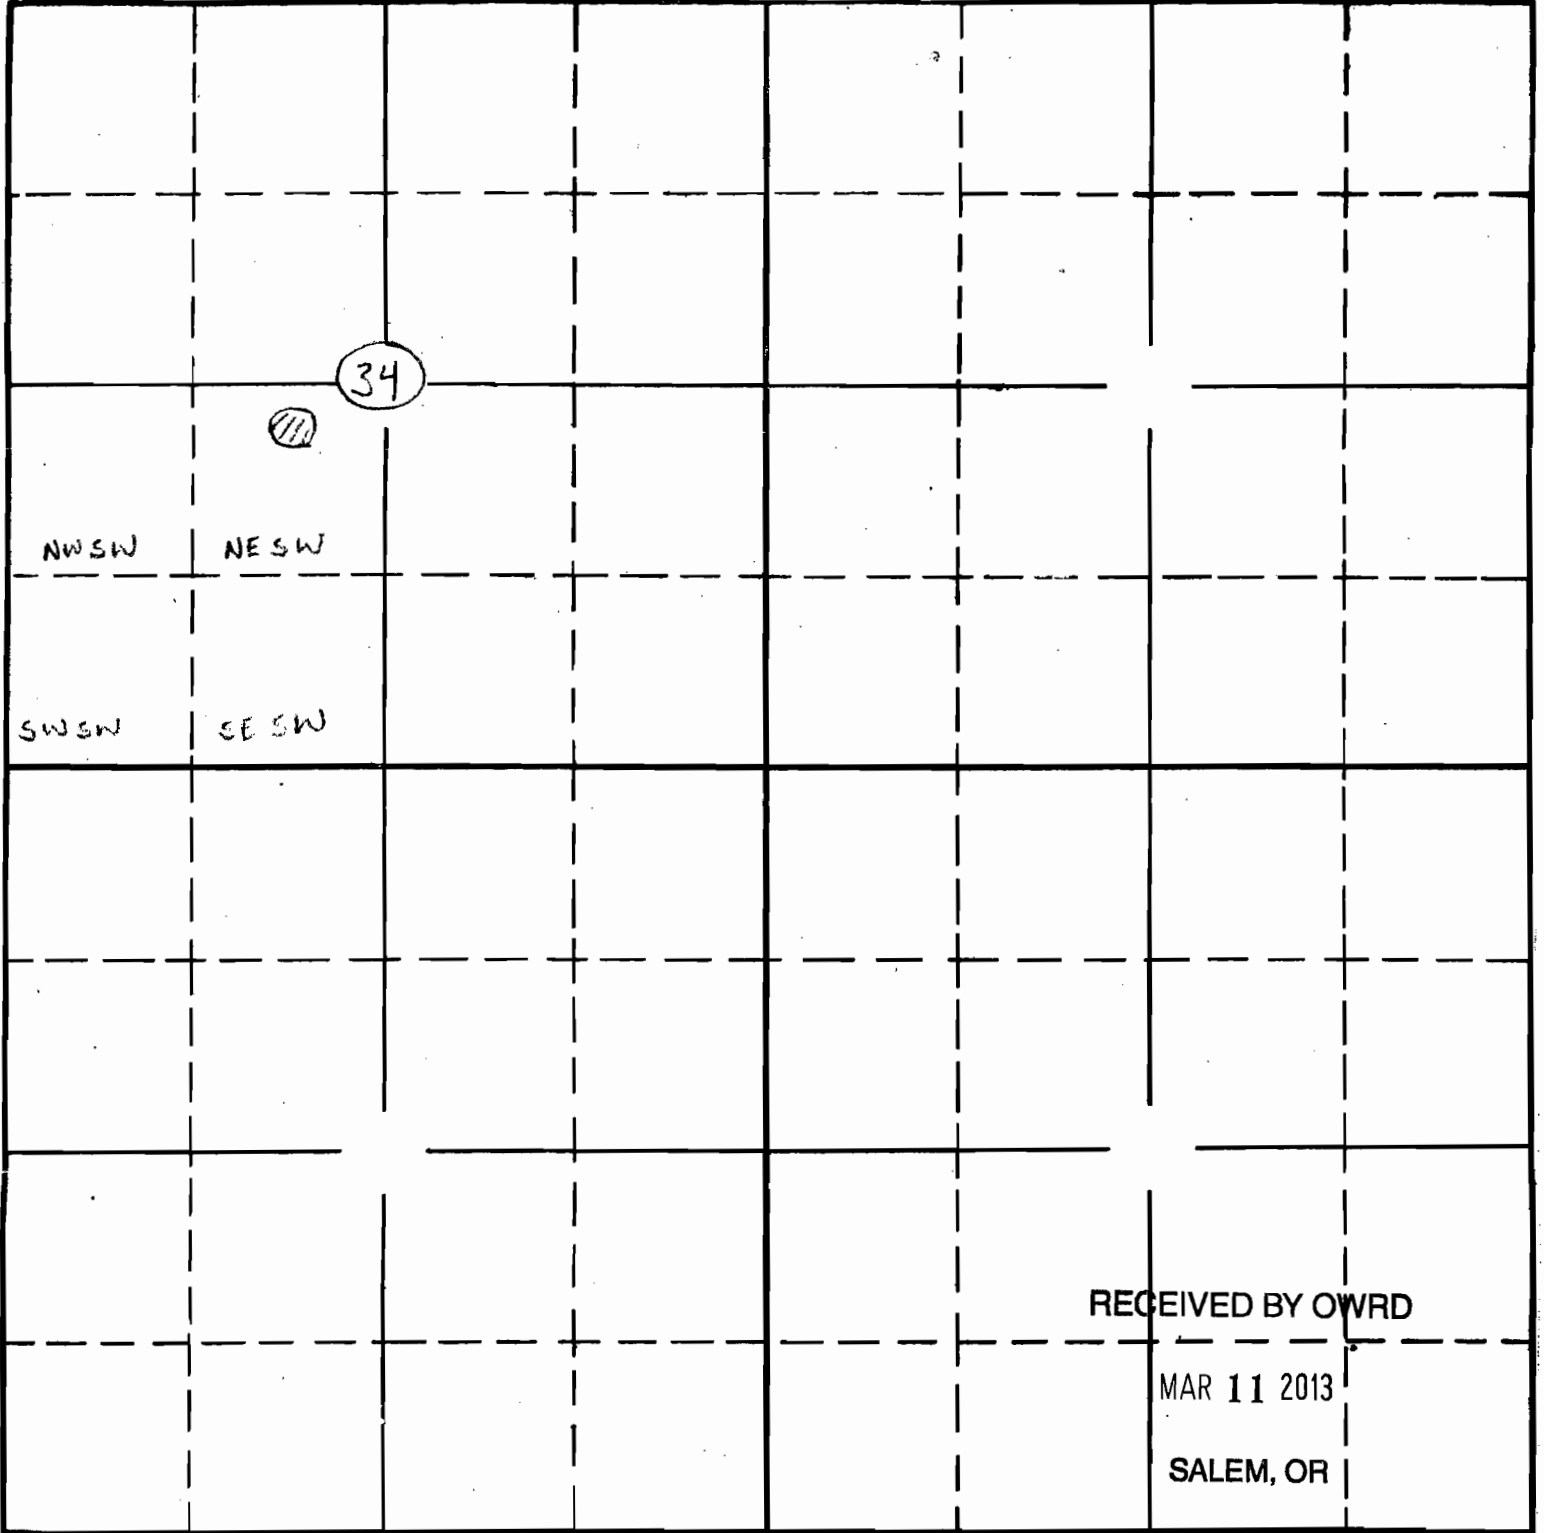

East

South

Dam Loc; 170 feet South 770 feet West
from Center of Section 34

APPLICATION No.
PERMIT No.

Marcus Wood 3-6-13
Jerry Wood 3-6-13