


Township 5 North, Range 32 East, W.M.

RECEIVED BY OWRD

APR 10 2013

SALEM, OR

SE ¼ of NW ¼ of Section 16
NE ¼ of SW ¼ of Section 16 NW ¼ of SE ¼ of Section 16
SE ¼ of SW ¼ of Section 16 SW ¼ of SE ¼ of Section 16

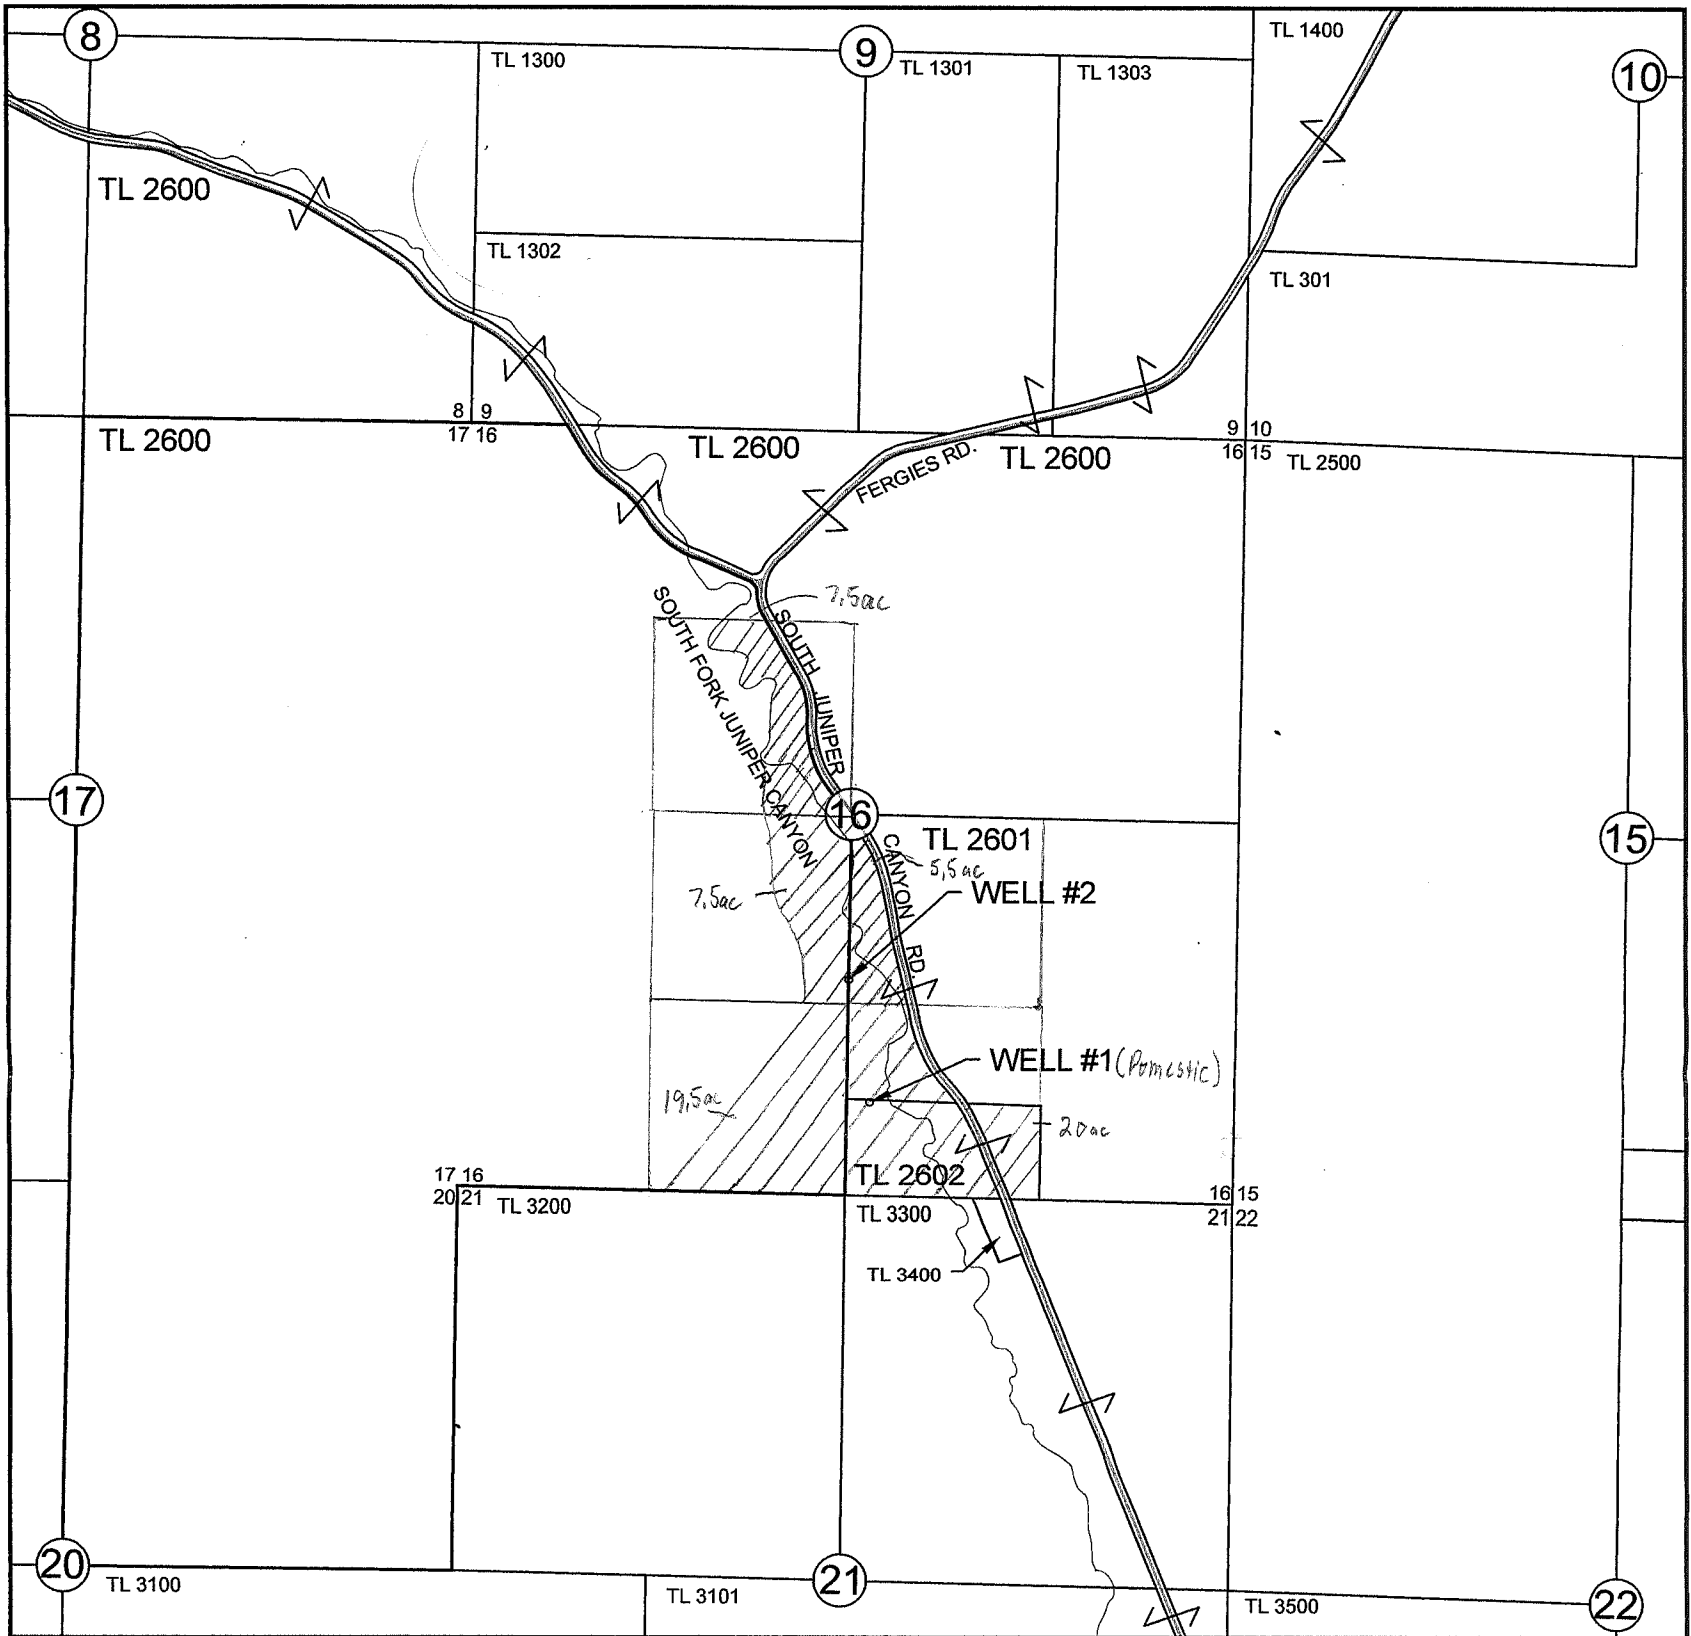

WELL #1 LOC 650' N & 160' E OF THE S 1/4 CORNER OF SECTION 16
WELL #2 LOC 1490' N & 0' E OF THE S 1/4 CORNER OF SECTION 16



GROUNDWATER WATER RIGHT APPLICATION MAP


in names of
JEFFREY & SHARILYN NEWTSON
AND ROBERT NEWTSON

THIS MAP WAS PREPARED FOR THE PURPOSE OF
IDENTIFYING THE LOCATION OF A WATER RIGHT
ONLY AND IS NOT INTENDED TO PROVIDE LEGAL
DIMENSIONS OR LOCATION OF PROPERTY
OWNERSHIP LINES.

G-17645

SALEM, OR

SEE MAP 64-53

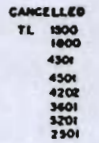

23 May 2005

G-17645