


If the diversion involves a dam, use this space for sketches of the diversion (e.g. cross-section of the dam with its dimensions, dimension and placement of outlet pipe, means of passing live flow outside of the authorized storage season, and means for providing fish passage).

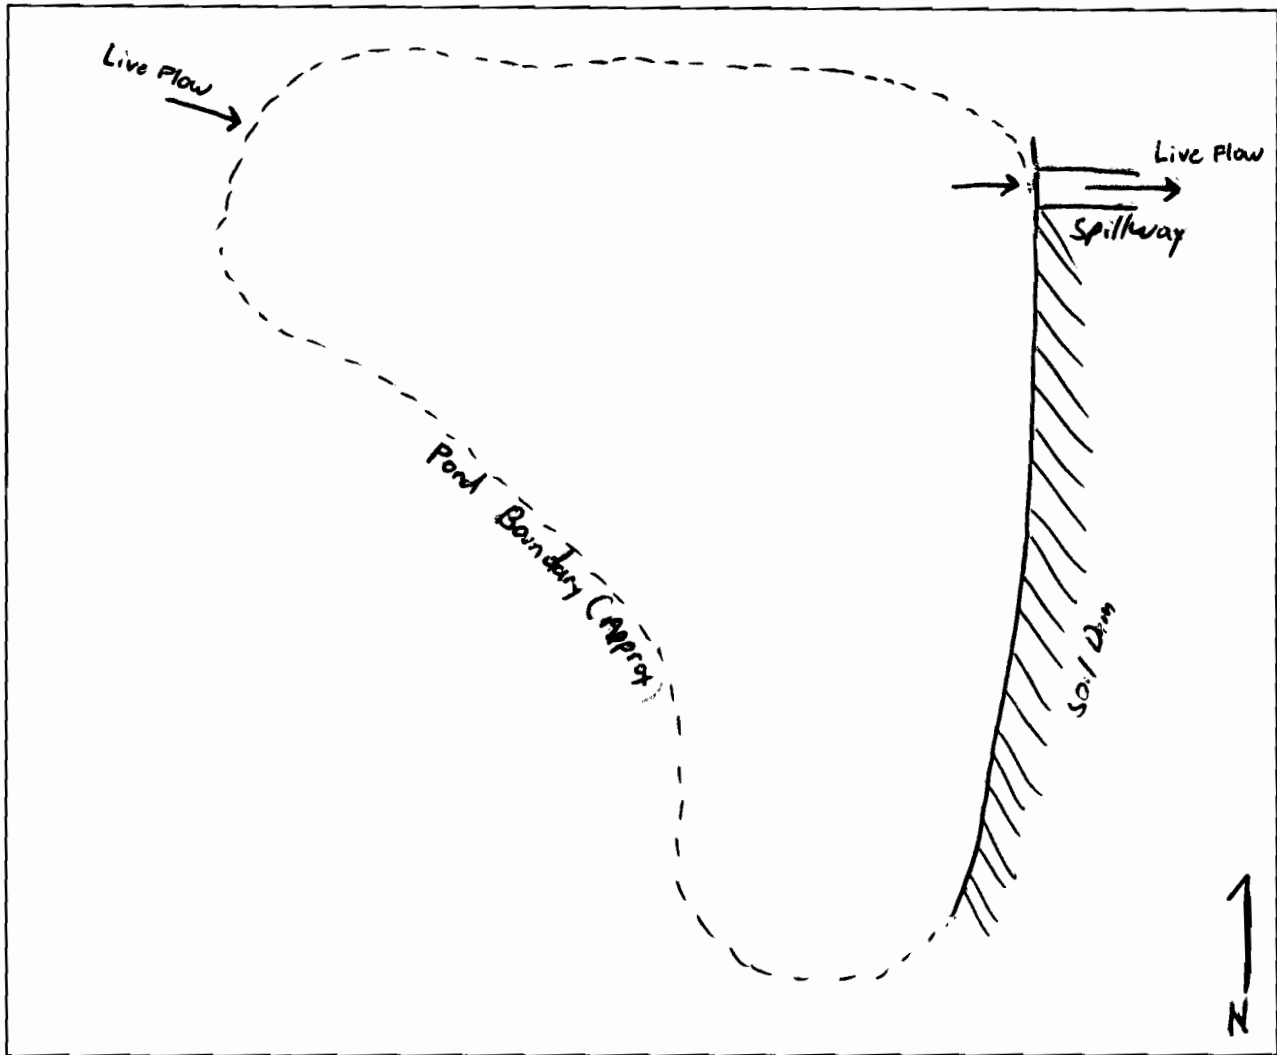

9. SIGNATURE

I swear that all statements made and information provided in this application are true and correct to the best of my knowledge.

Paul Butcher
 Landowner Signature

8/20/2012
 Date

RECEIVED

APR 04 2013

WATER RESOURCES DEPT
 SALEM, OREGON

Before you submit your application be sure you have:

- Answered each question completely.
- Included a legible map that includes Township, Range, Section, quarter-quarter and tax lot number.
- The map must meet map requirements to be accepted.
- Included a land use form or receipt stub signed by a local planning official.
- Included a check payable to Oregon Water Resources Department for the appropriate amount.

FEE STRUCTURE: The fee is based on the number of acre-feet proposed to be stored. The base fee is \$300. In addition, there is a fee of \$25 per acre-foot or fraction thereof. Example: 0.3 AF= \$325; 1.5 AF= \$350; 20.0 AF= \$800; 30.0 AF= \$1050. Plus a permit recording fee of \$400 (this fee is refunded if no permit is issued).

R-07084

SCALE 1" = 500' APPROX.

IMPORTANT
This Map for Assessment
and Taxation Purposes
ONLY

NW1/4 SEC. 5 T8S R5W WM
POLK COUNTY.

Scale 1" = 200'


8.5.5B

See Map 7.5.32CC

See Map 9.5.32B

SW OAKDALE ROAD

OAKDALE AVENUE

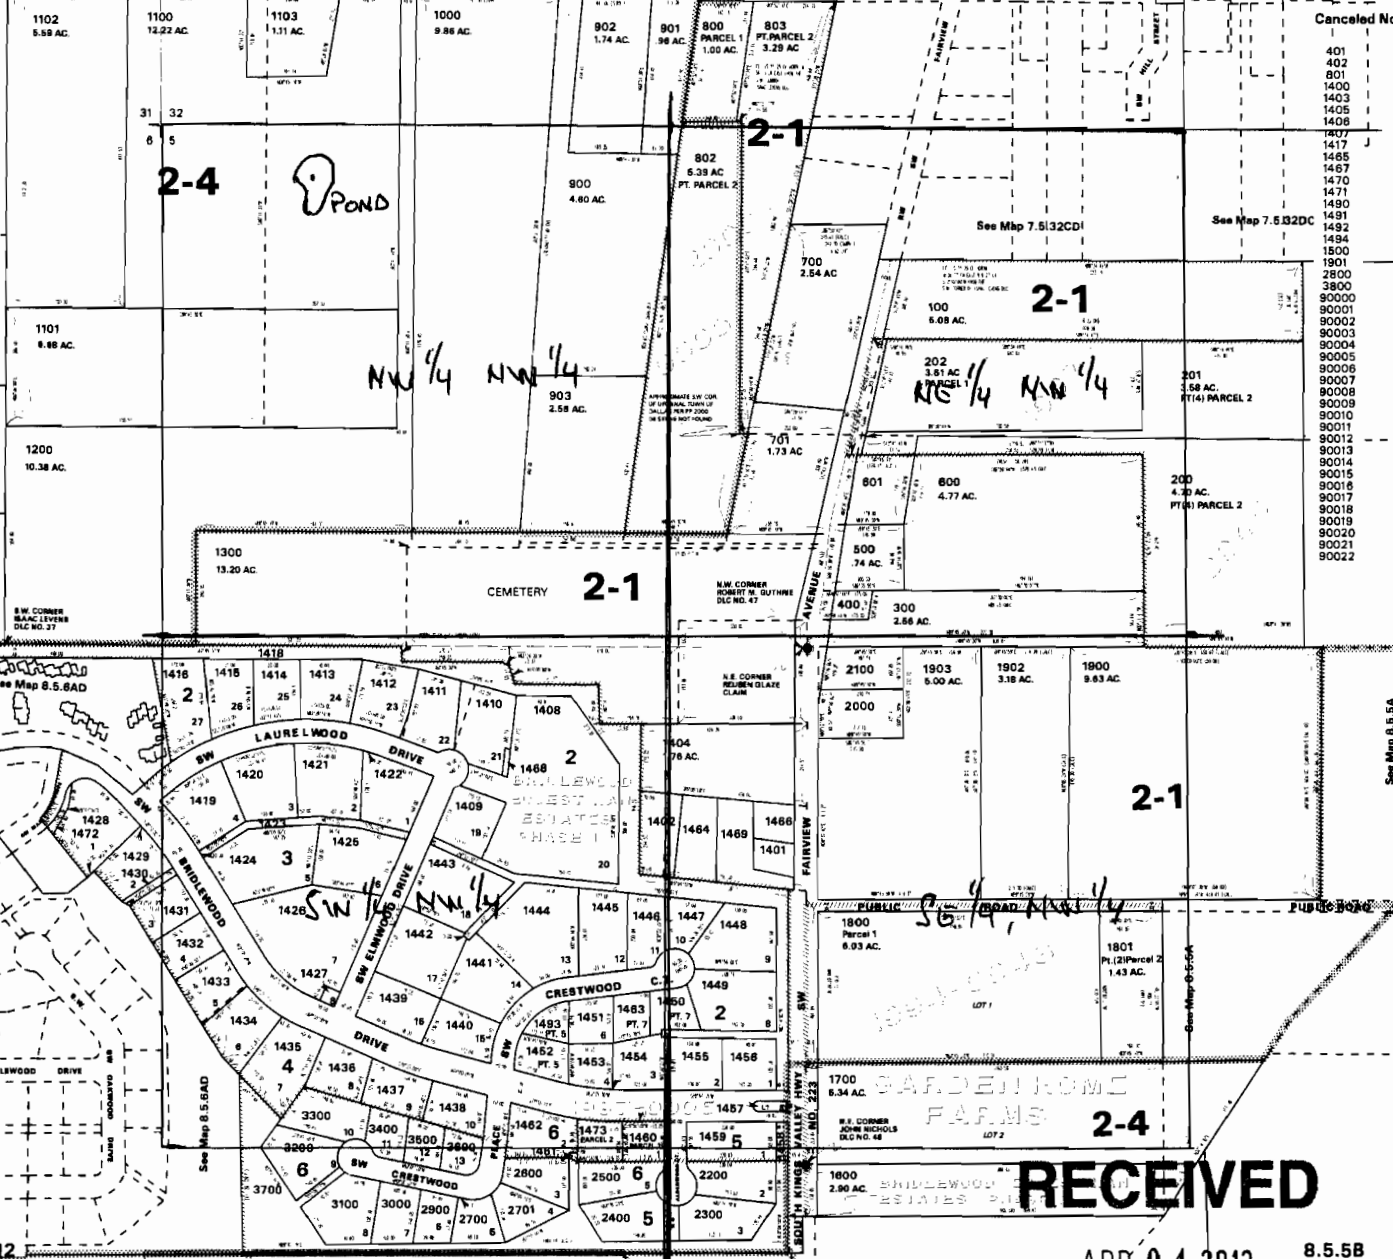

- Canceled No.
- 401
 - 402
 - 801
 - 1400
 - 1403
 - 1405
 - 1408
 - 1407
 - 1417
 - 1455
 - 1467
 - 1470
 - 1471
 - 1480
 - 1491
 - 1492
 - 1484
 - 1800
 - 1801
 - 2800
 - 3800
 - 9000
 - 90001
 - 90002
RECEIVED

APR 04 2013

8.5.5B

WATER RESOURCES DEPT
SALEM, OREGON

130' SOUTH
400' EAST FROM NW SECTION CORNER, SECTION 5

R-87864