

N
SCALE 1" = 100'

UNNAMED STREAM

FLOW

WATER
COLLECTION
NORTH 445'
EAST 75'
IN 10-27-300

HOBSONVILLE POINT RD

IN 10-34B-200
(HARPER)

1/4 CORNER
S 27
(27)
S 34

IN 10-34B-400
(HARPER)

CENTERLINE RAILROAD

1" POLY PIPE

TO TILLAMOOK BAY

6900
(GIBSON)

IN 10-34B-500

S-07887

RECEIVED BY OWRD

APR 10 2013

SALEM, OR

TILLAMOOK BAY

56-08

56-00

TIDE FLATS

PORT

HIGHWAY 101 R/W

///

11.

1

R/V

1

///

1

SEE MAP IN 10 34AC

CEN. SEC. 34

RECEIVED BY OWRD

APR 10 2013


SALEM, OR

32 1 55

IN 10 34B

REVISÉD 09/18/00. KA

LUC-13-01

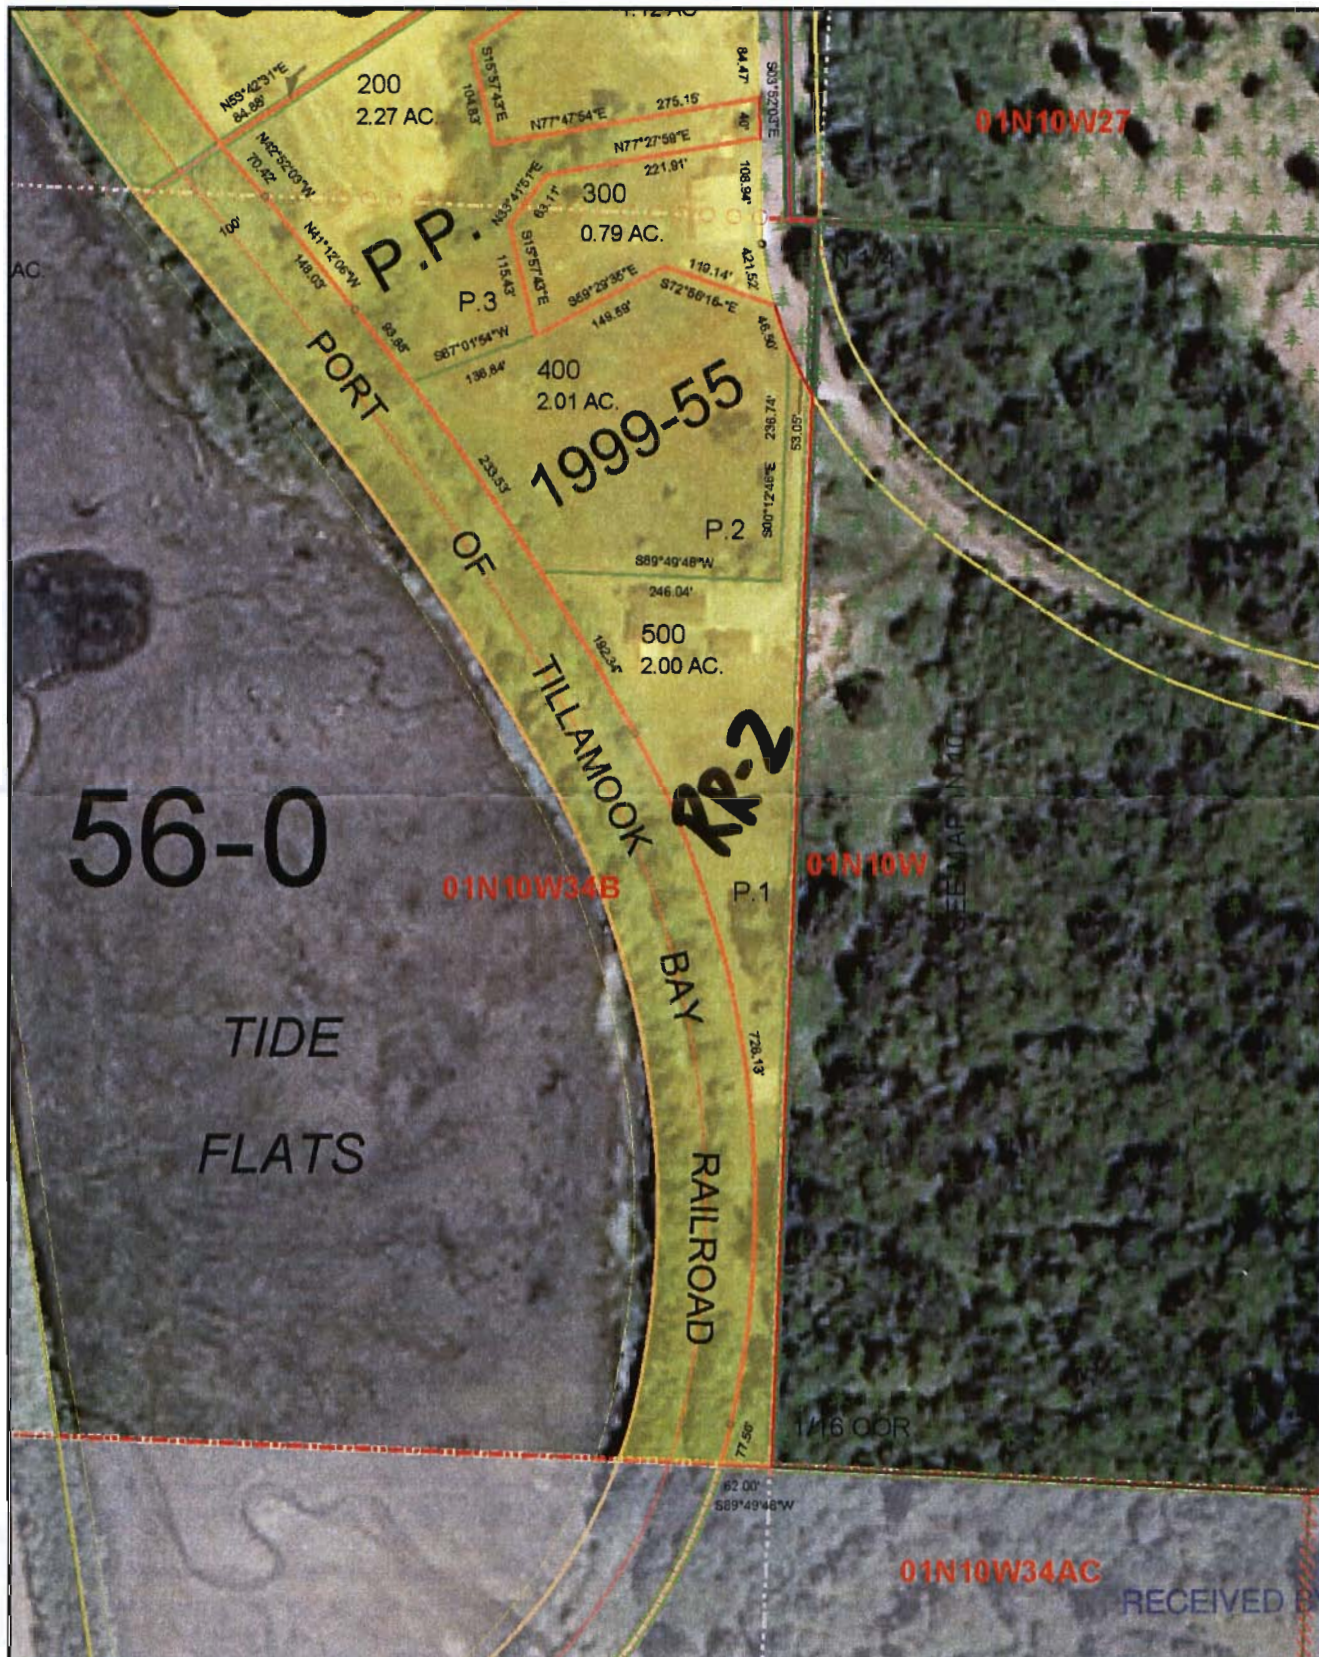

APR 10 2013