


# SECTION PLAT

Section 03 Township 23s Range 32 1/2 E  
 County of Harney State of Oregon

NORTH

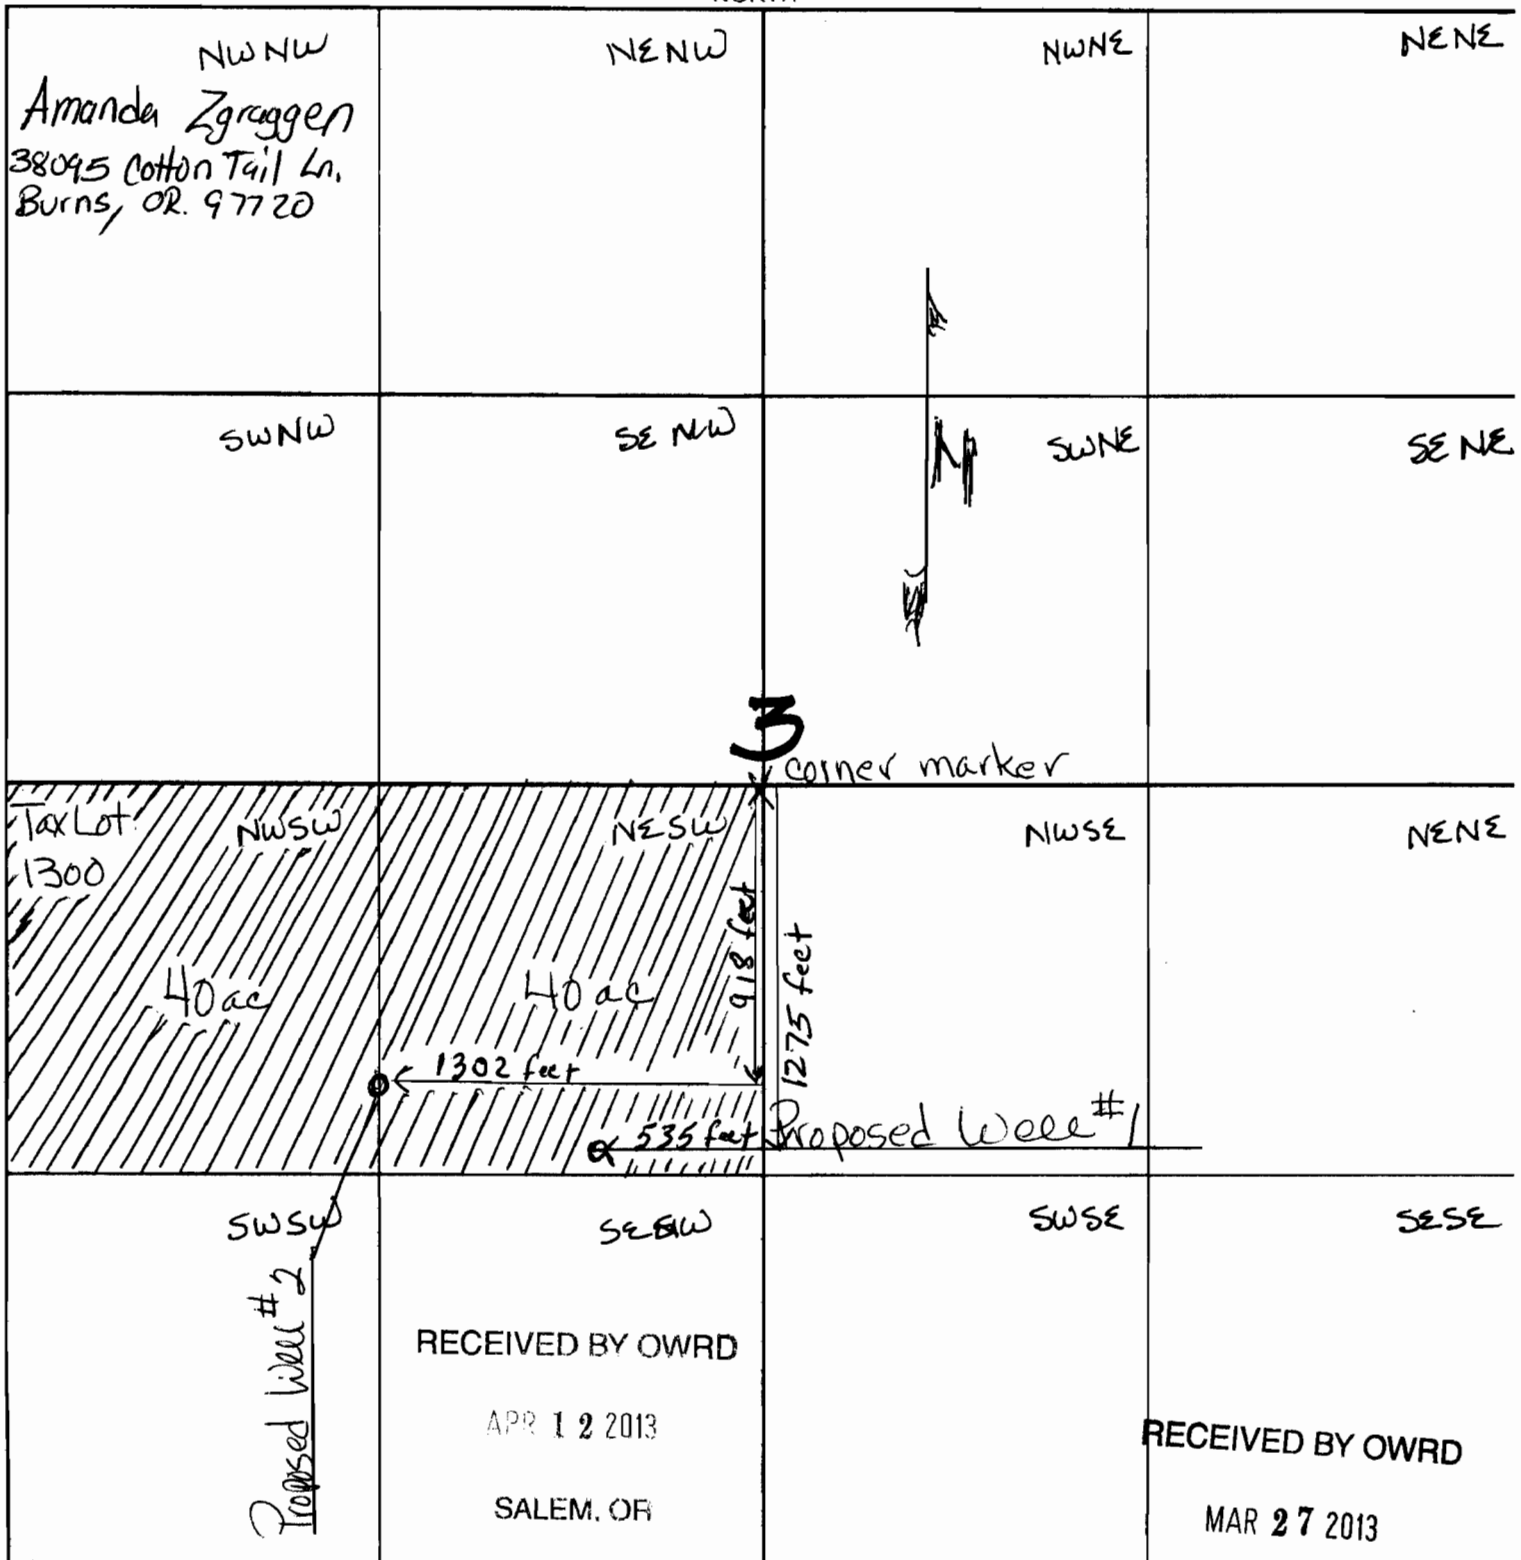

G-17646

4" = 1 mile  
8" = 1 mile

SALEM, OR