


3N 17E 0 2000

Pond is 1,800 ft East and 1,450 ft North
of the SW Corner, Sec 35, 3N 17E.

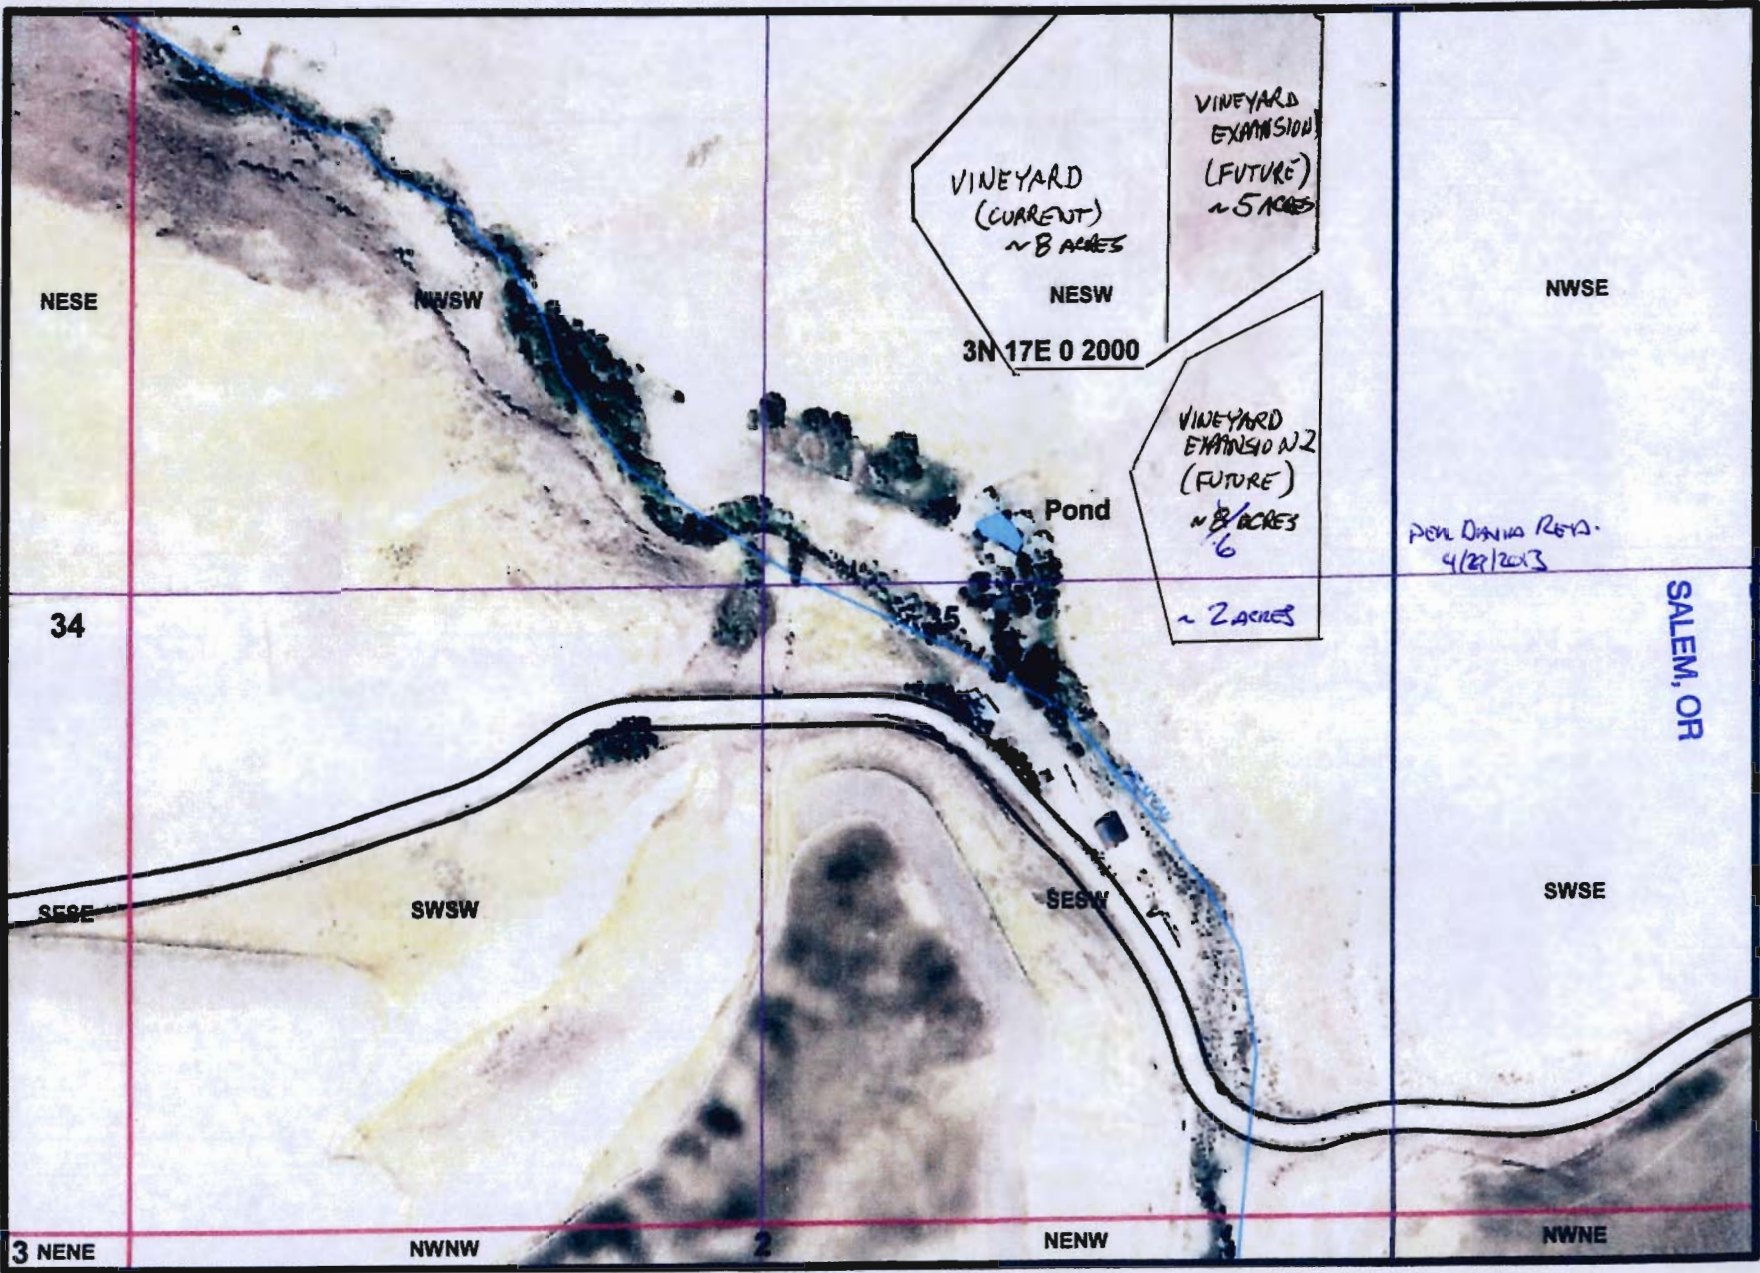

RECEIVED BY OWRD

APR 24 2013


FEB 11 2013

SALEM, OR

22078-5 RECEIVED BY OWRD

LEGAL: SW 1/4 OF SECTION 35, TOWNSHIP 3 N, RANGE 17 E

TAX LOT # 2000

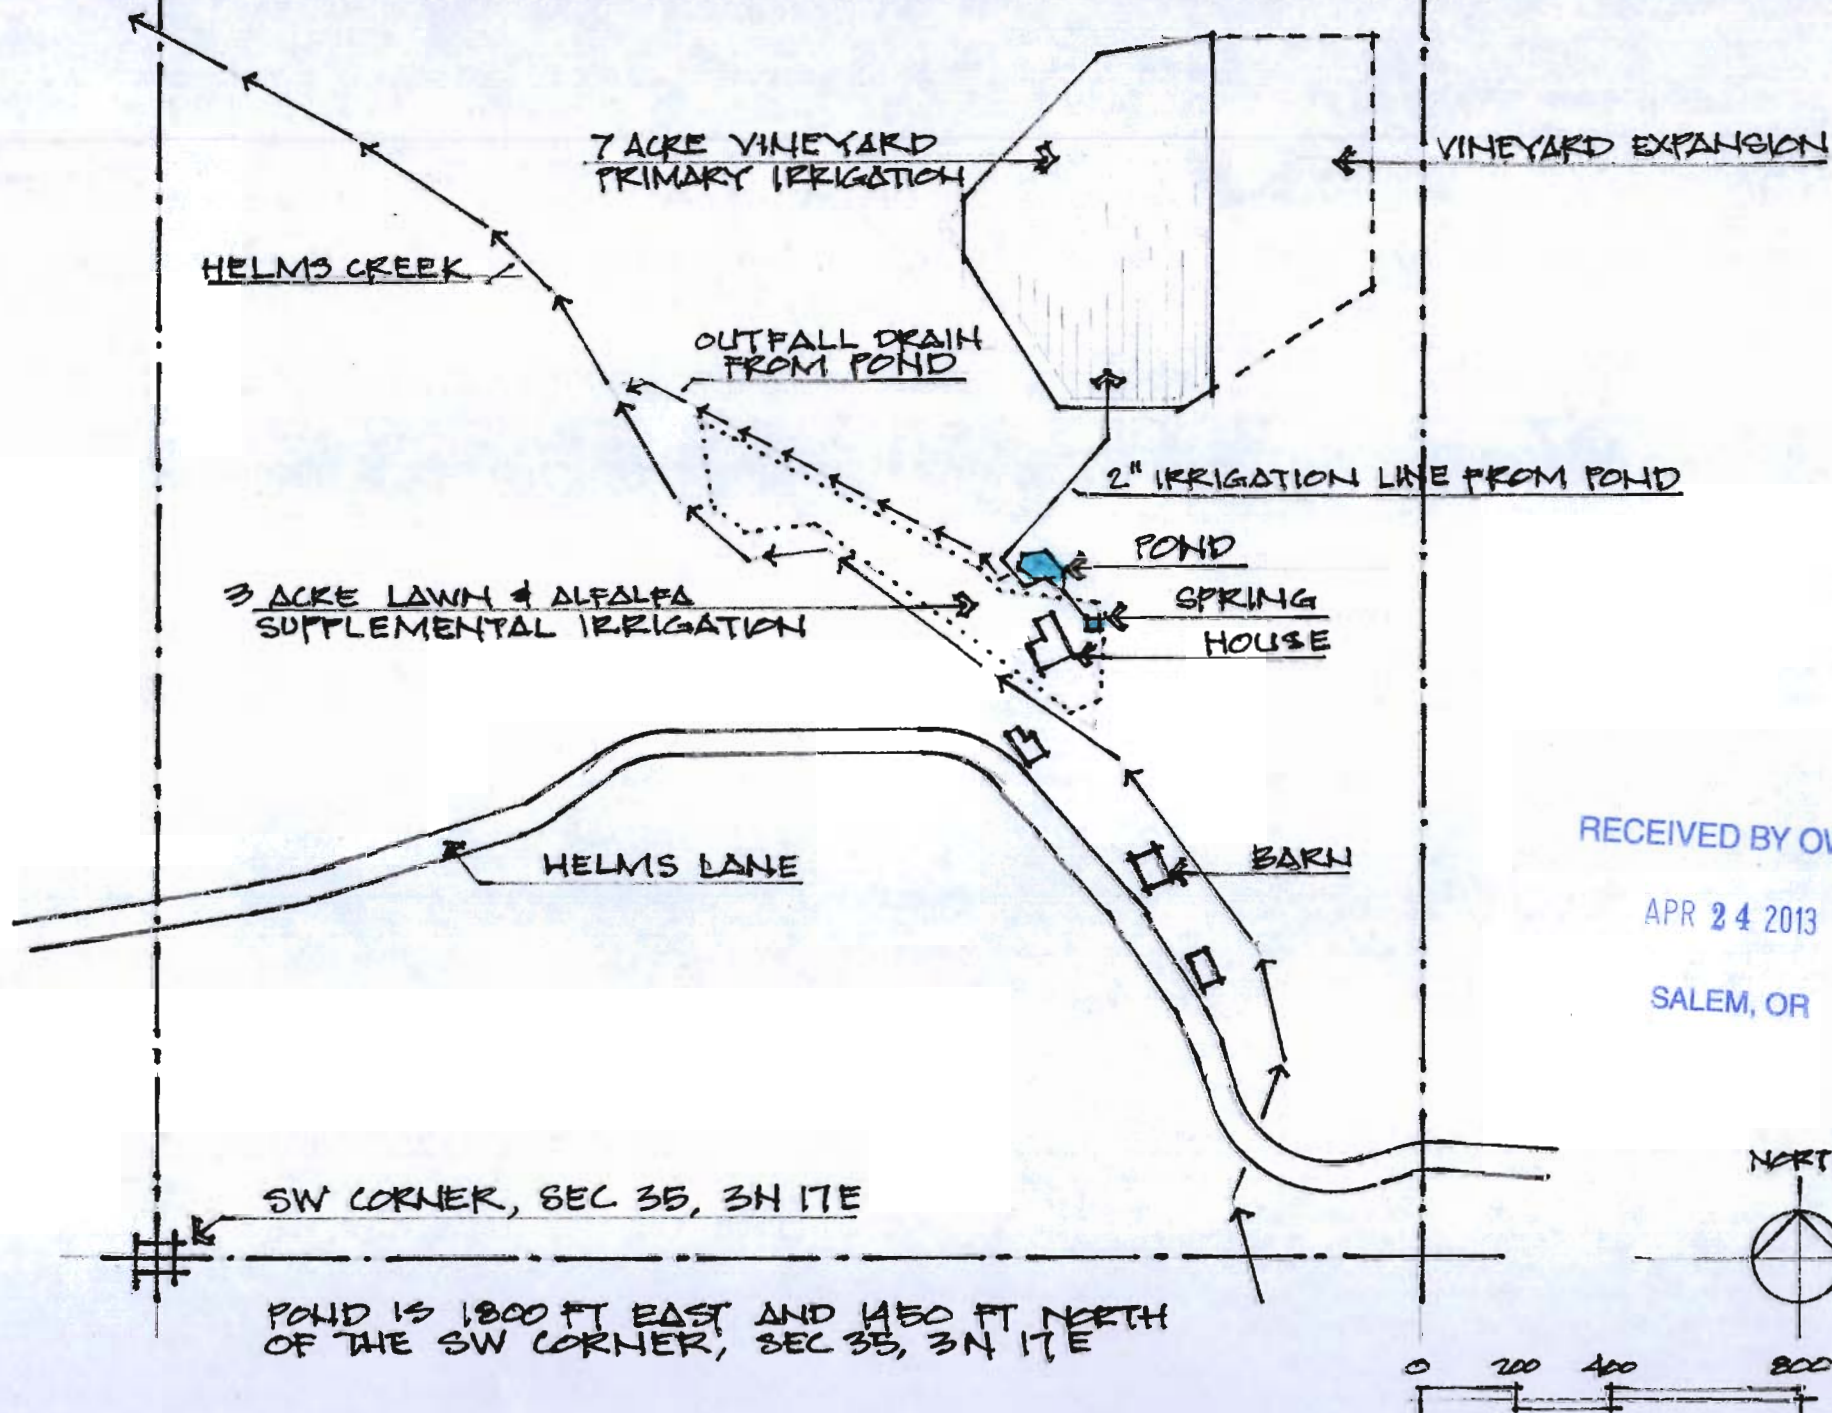

RECEIVED BY OWRD


APR 24 2013

SALEM, OR

5288.5

3N 17E 0 2000

Pond is 1,800 ft East and 1,450 ft North
of the SW Corner, Sec 35, 3N 17E.

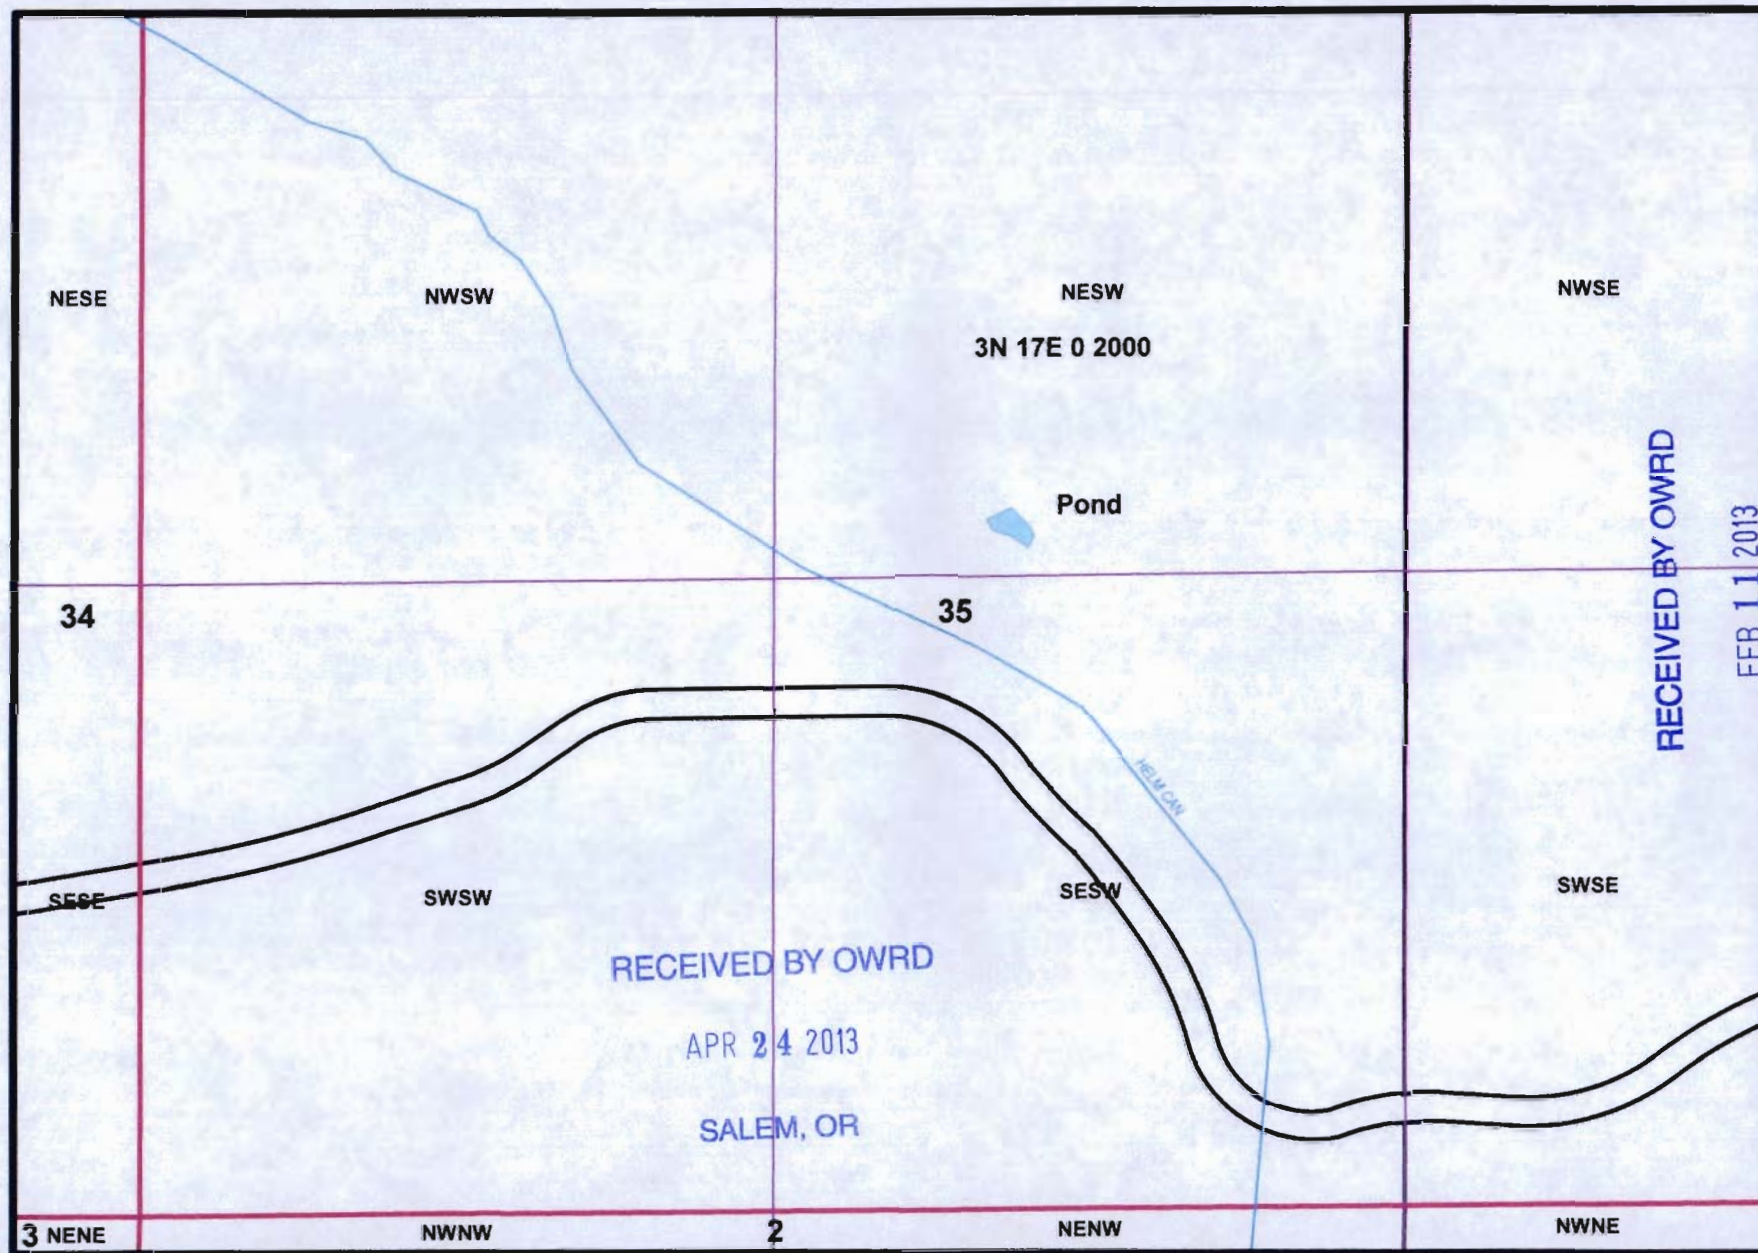

RECEIVED BY OWRD

APR 24 2013

SALEM, OR

RECEIVED BY OWRD

FEB 11 2013

SALEM, OR


5-87823



0 200 400 800 Feet

03N17E

CANCELLED
100
300
400
~~500~~
~~900~~
1300
1400
Z200U1
Z200U2

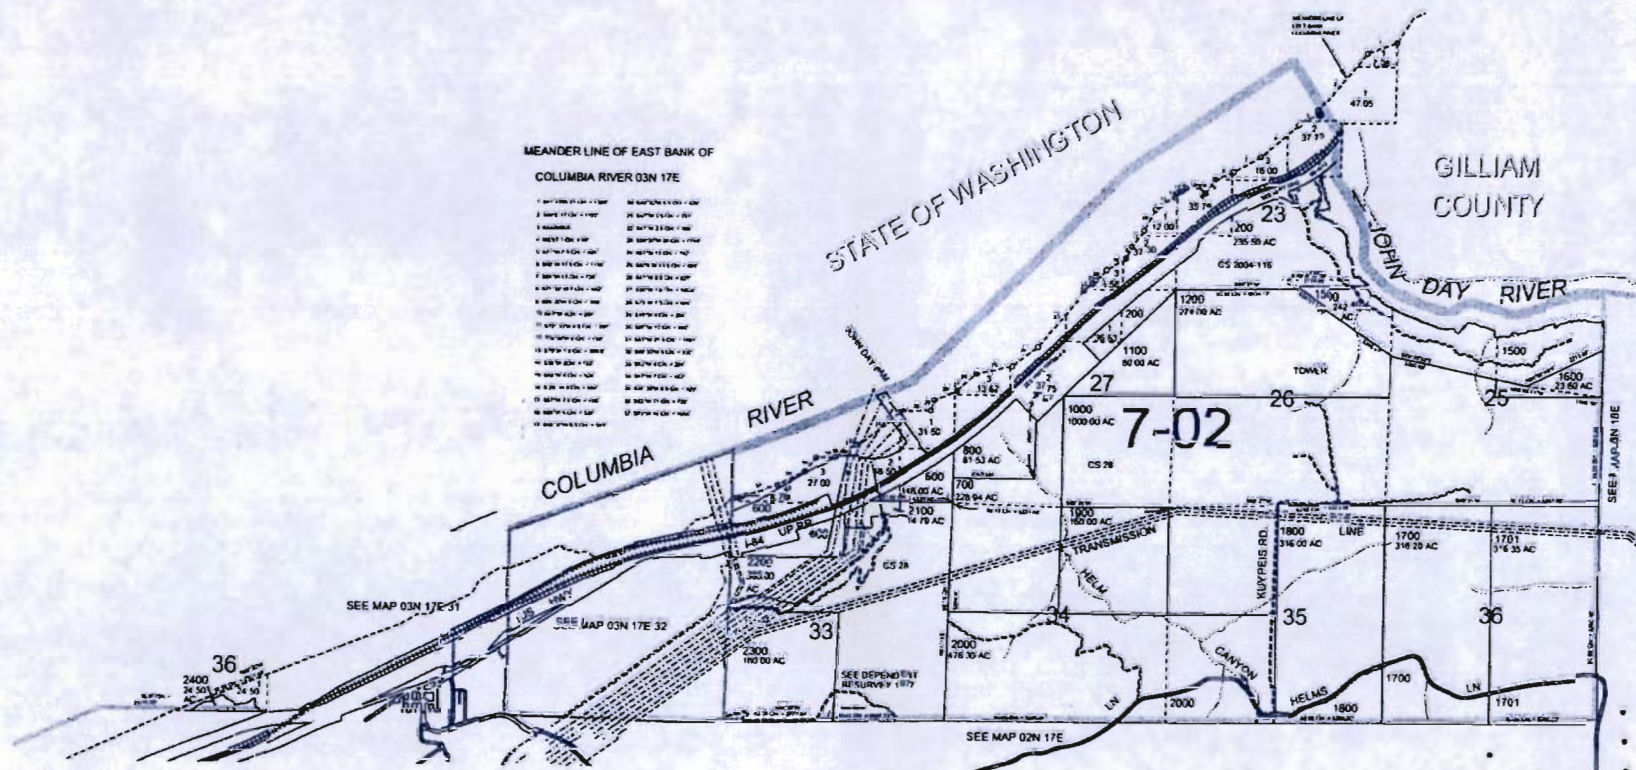

5-87823

RECEIVED BY OWRD

FEB 11 2013

SALEM, OR

RECEIVED BY OWRD

APR 24 2013

SALEM, OR

Revised SL
04/08/2008

03N17E