


Johnson Family Pond 2S 12E 0 2101 & 2102

R-87885

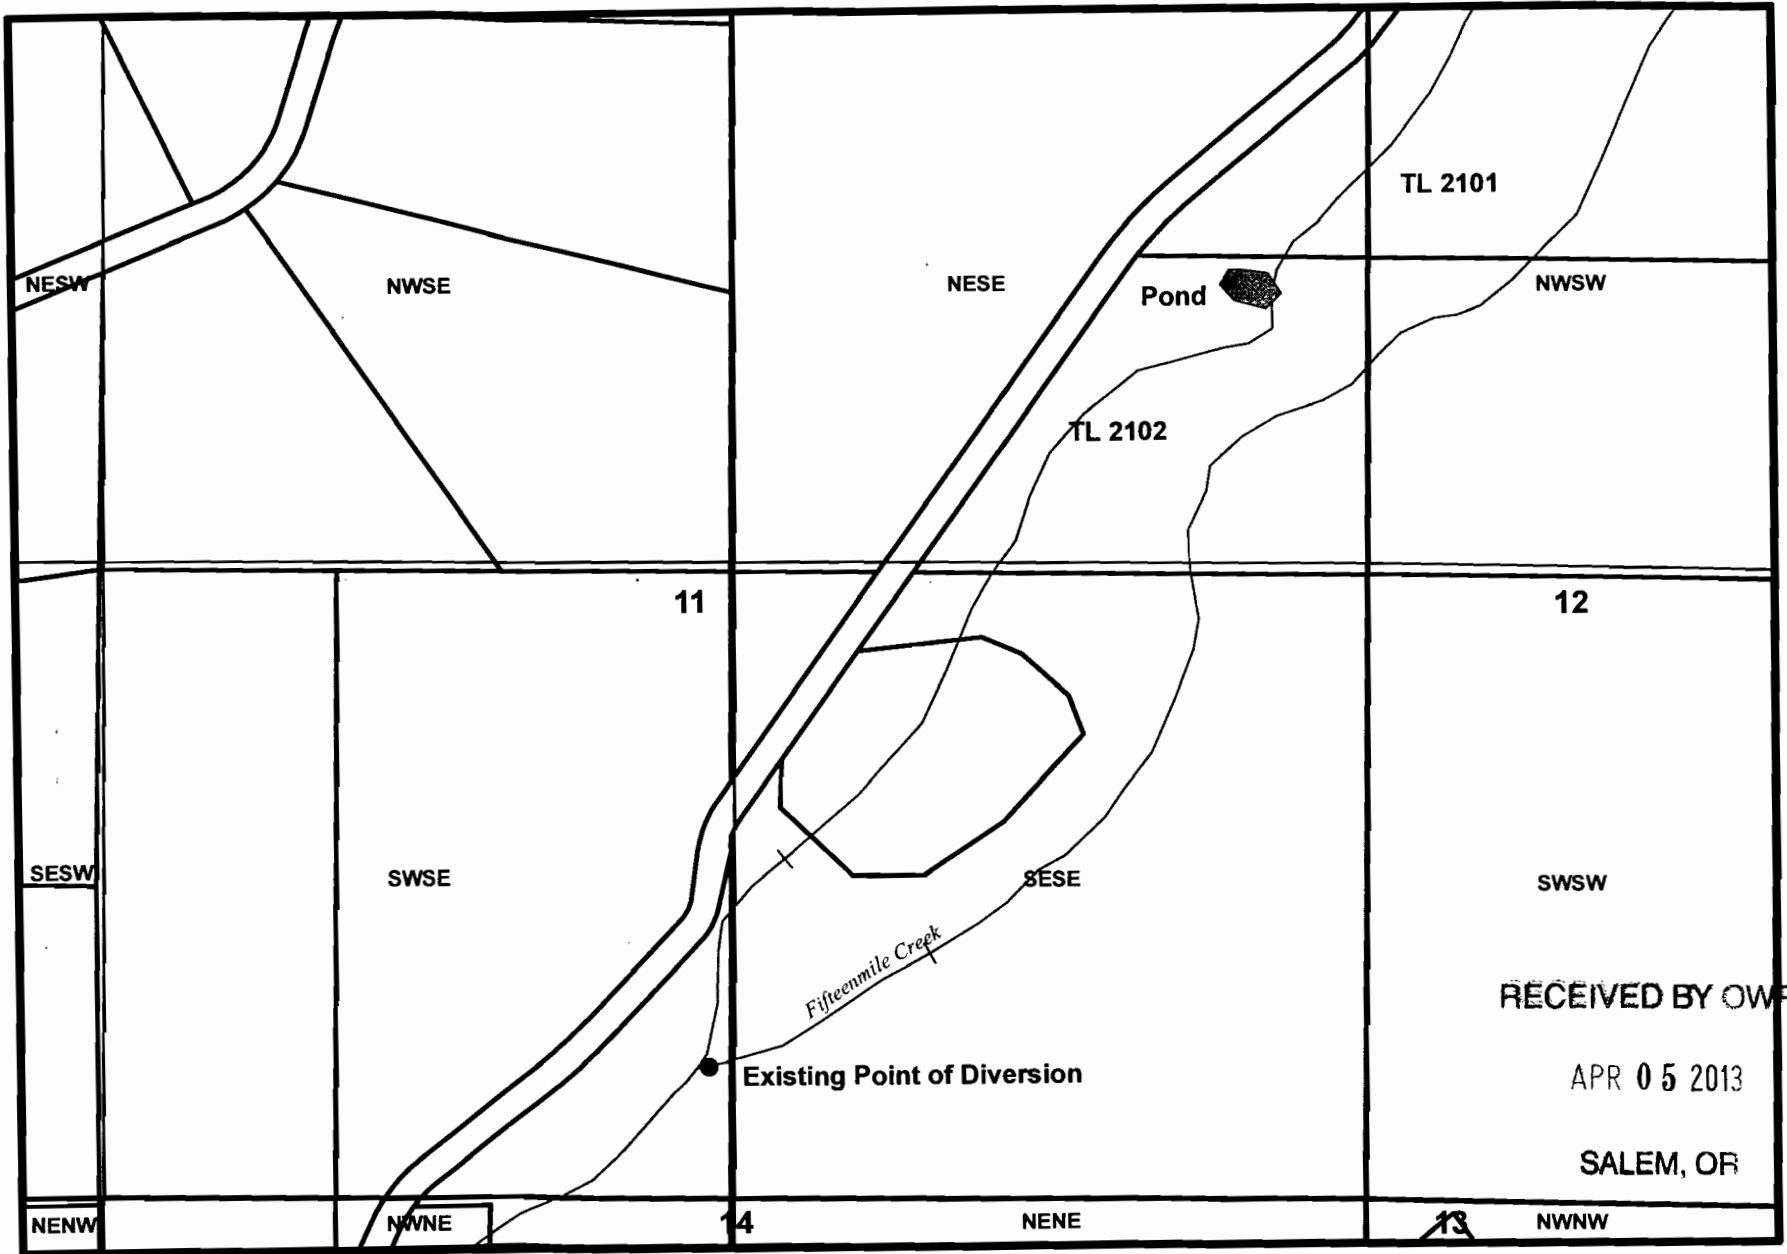

Little Ditch Diversion: The POD is 1,390 ft West and 273 ft North of the SE Corner, Section 11, being in the SW SE Section 11.

