


SECTION PLAT

Section 12 Township 24S Range 27E
County of Harney State of Oregon

NORTH

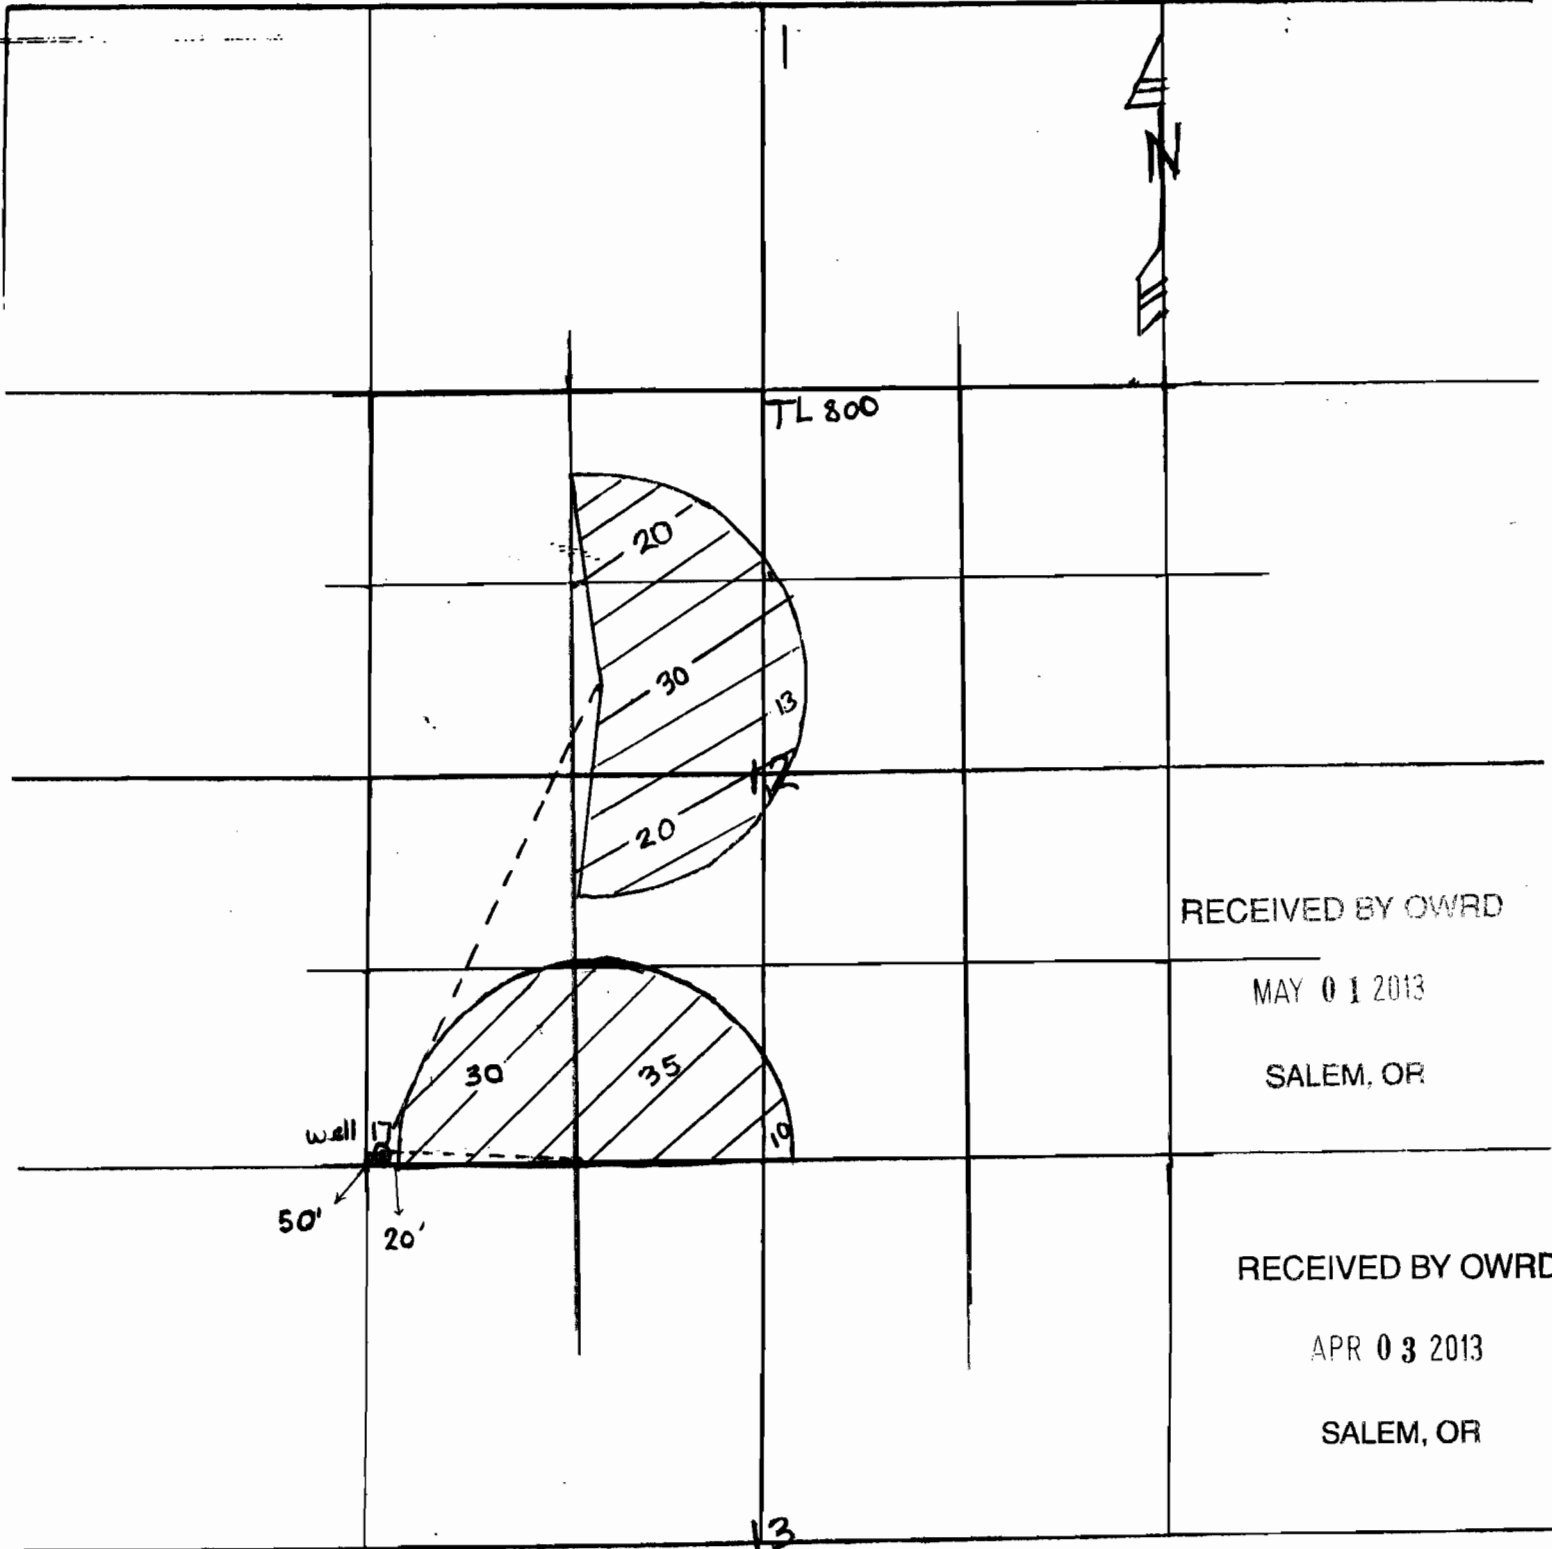

RECEIVED BY OWRD

MAY 01 2013

SALEM, OR

RECEIVED BY OWRD

APR 03 2013

SALEM, OR

G-17663