


T.5 S., R.2 E., W.M.

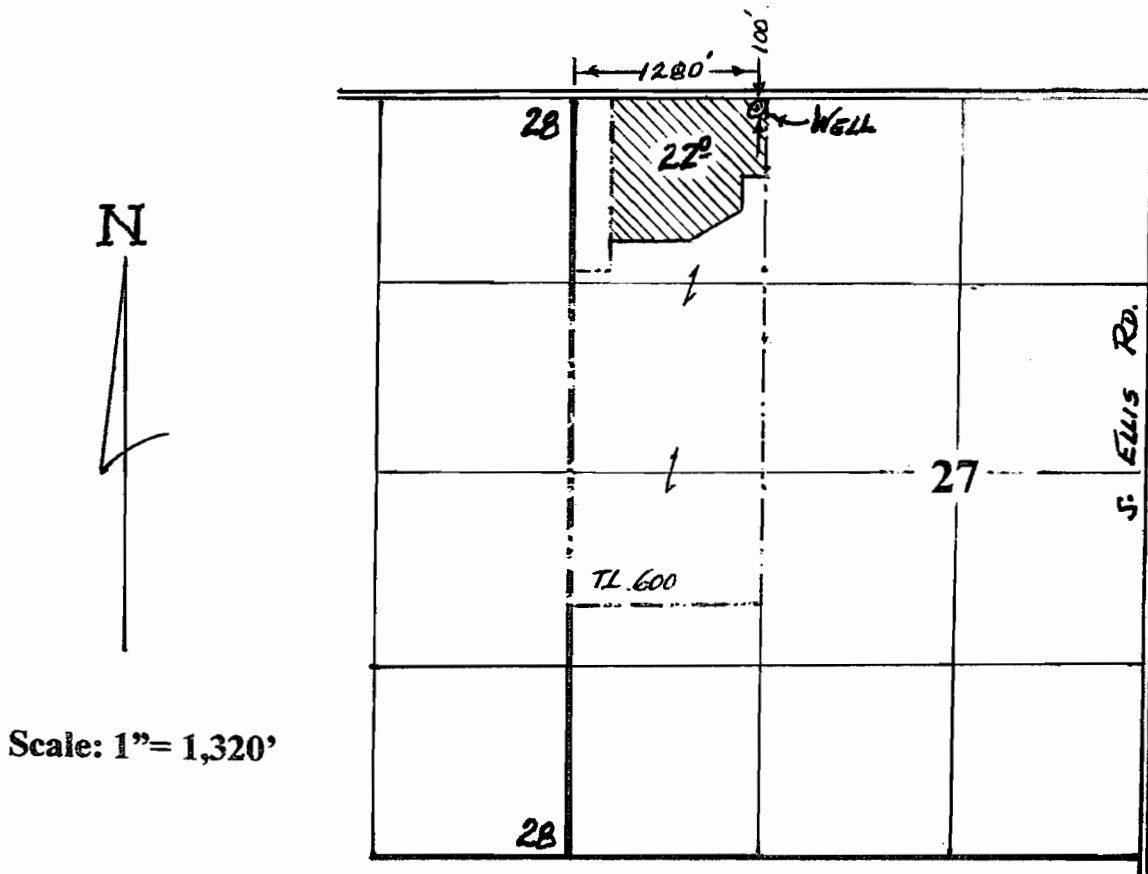

MAP TO ACCOMPANY
APPLICATION for PERMIT
In the Name of
Drizzlewood Farm. LLC

RECEIVED

MAY 13 2013

WATER RESOURCES DEPT
SALEM, OREGON

This map is for the purpose of identifying
the location of water rights only, and is not
intended to provide legal dimensions or
locations of property lines.

May, 2013 *AK*

G-17670