


T. 23 S. R. 31 E. W.M.

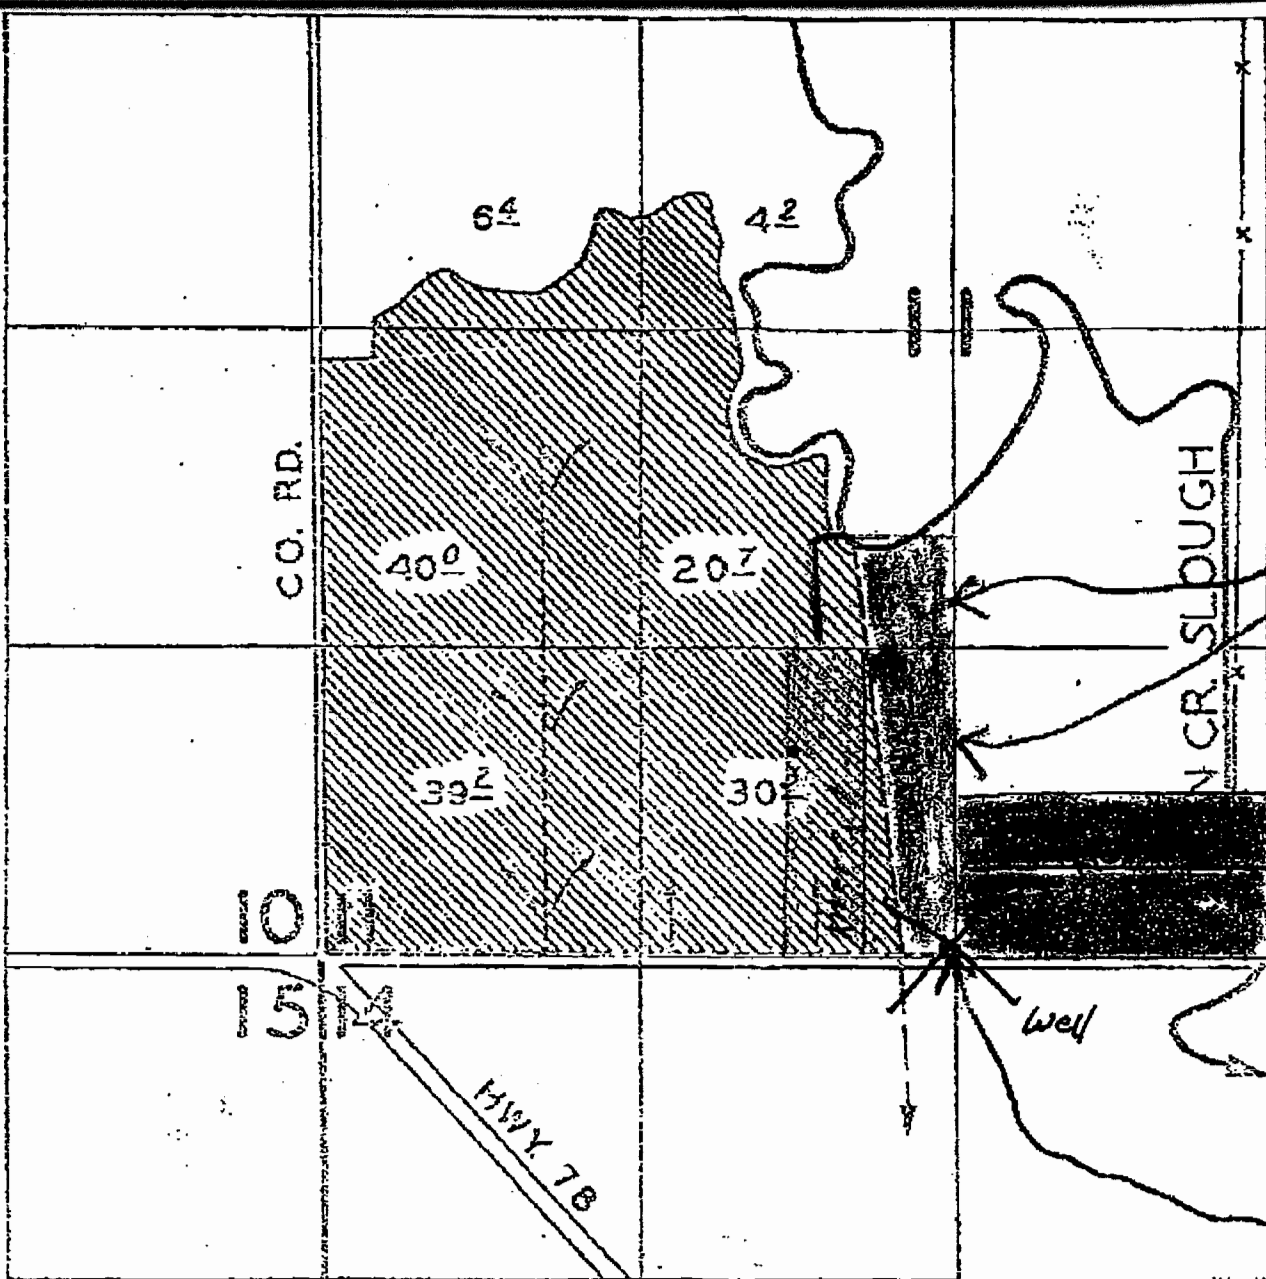

N
↑
WORK COPY

1200
→ Tax lot 1200
4.44 Acre
10.00 Acre
→ Tax lot 600
7.93 Acres
700
→ Tax lot 700
7.73 Acres

Well is on SE Corner of (18' North of Property line & 85W of Property line)
TAX lot 1200

WELL IS LOCATED DUE SOUTH from CENTER of SECTION 11
APPROX. 2580 FT. UTM

Scale - $1320' = \frac{1}{4}$ mile
APPROX REVISED UTM
CORRECTED SCALE
1" = 800 FEET

(4)