


Attachment (A)

T. 23S. R. 31E. WM.

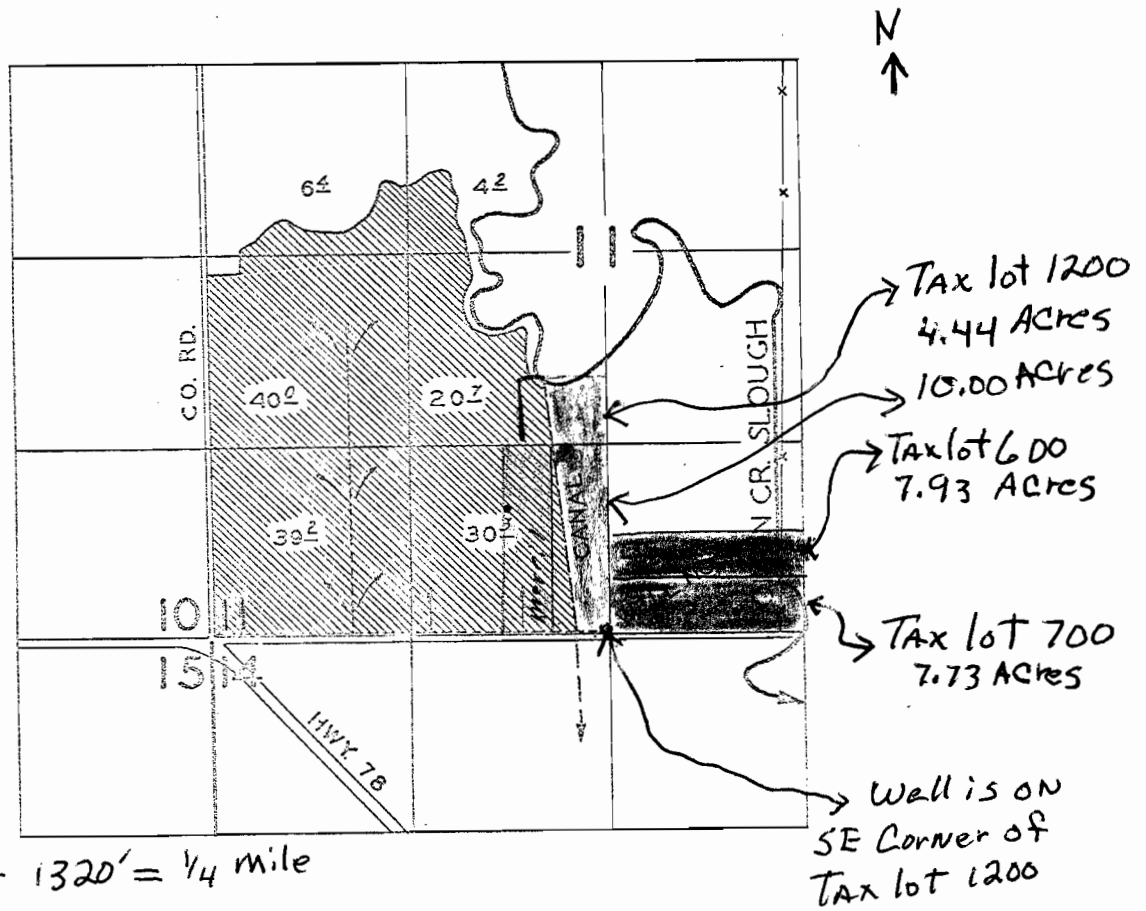

RECEIVED
 DEC 08 2006
 WATER RESOURCES DEPT
 SALEM, OREGON