

SECTION

sect 30


1" = 1320'

Tax lot 701

TOWNSHIP 3^{South}, RANGE 1^{West}, W. M.

↑ North

North

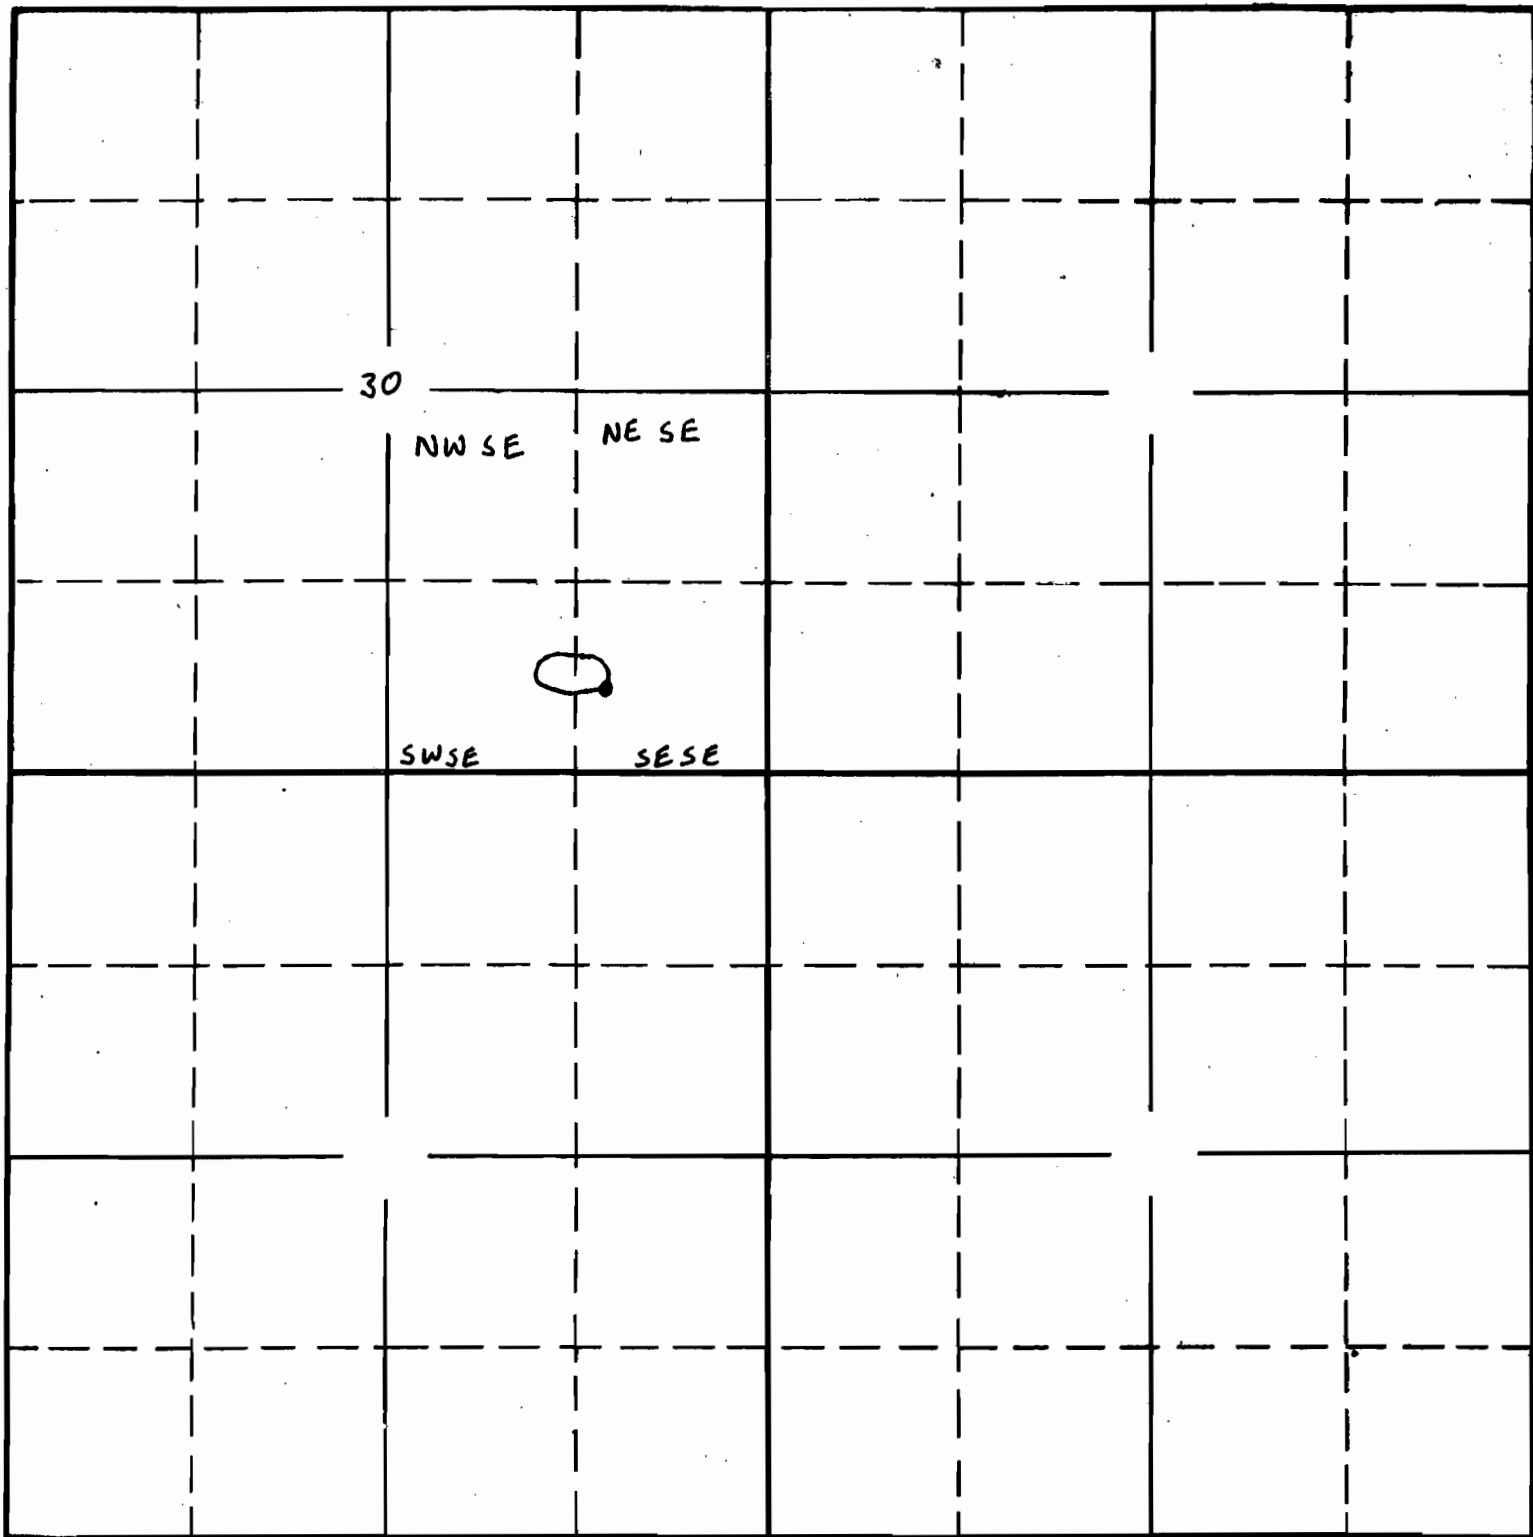

South

Dam Loc 675 feet North and 1200 feet
West from SE Corner Section 30


APPLICATION No.

PERMIT No.

R-8700

[Signature] 3/25/13

R-8769

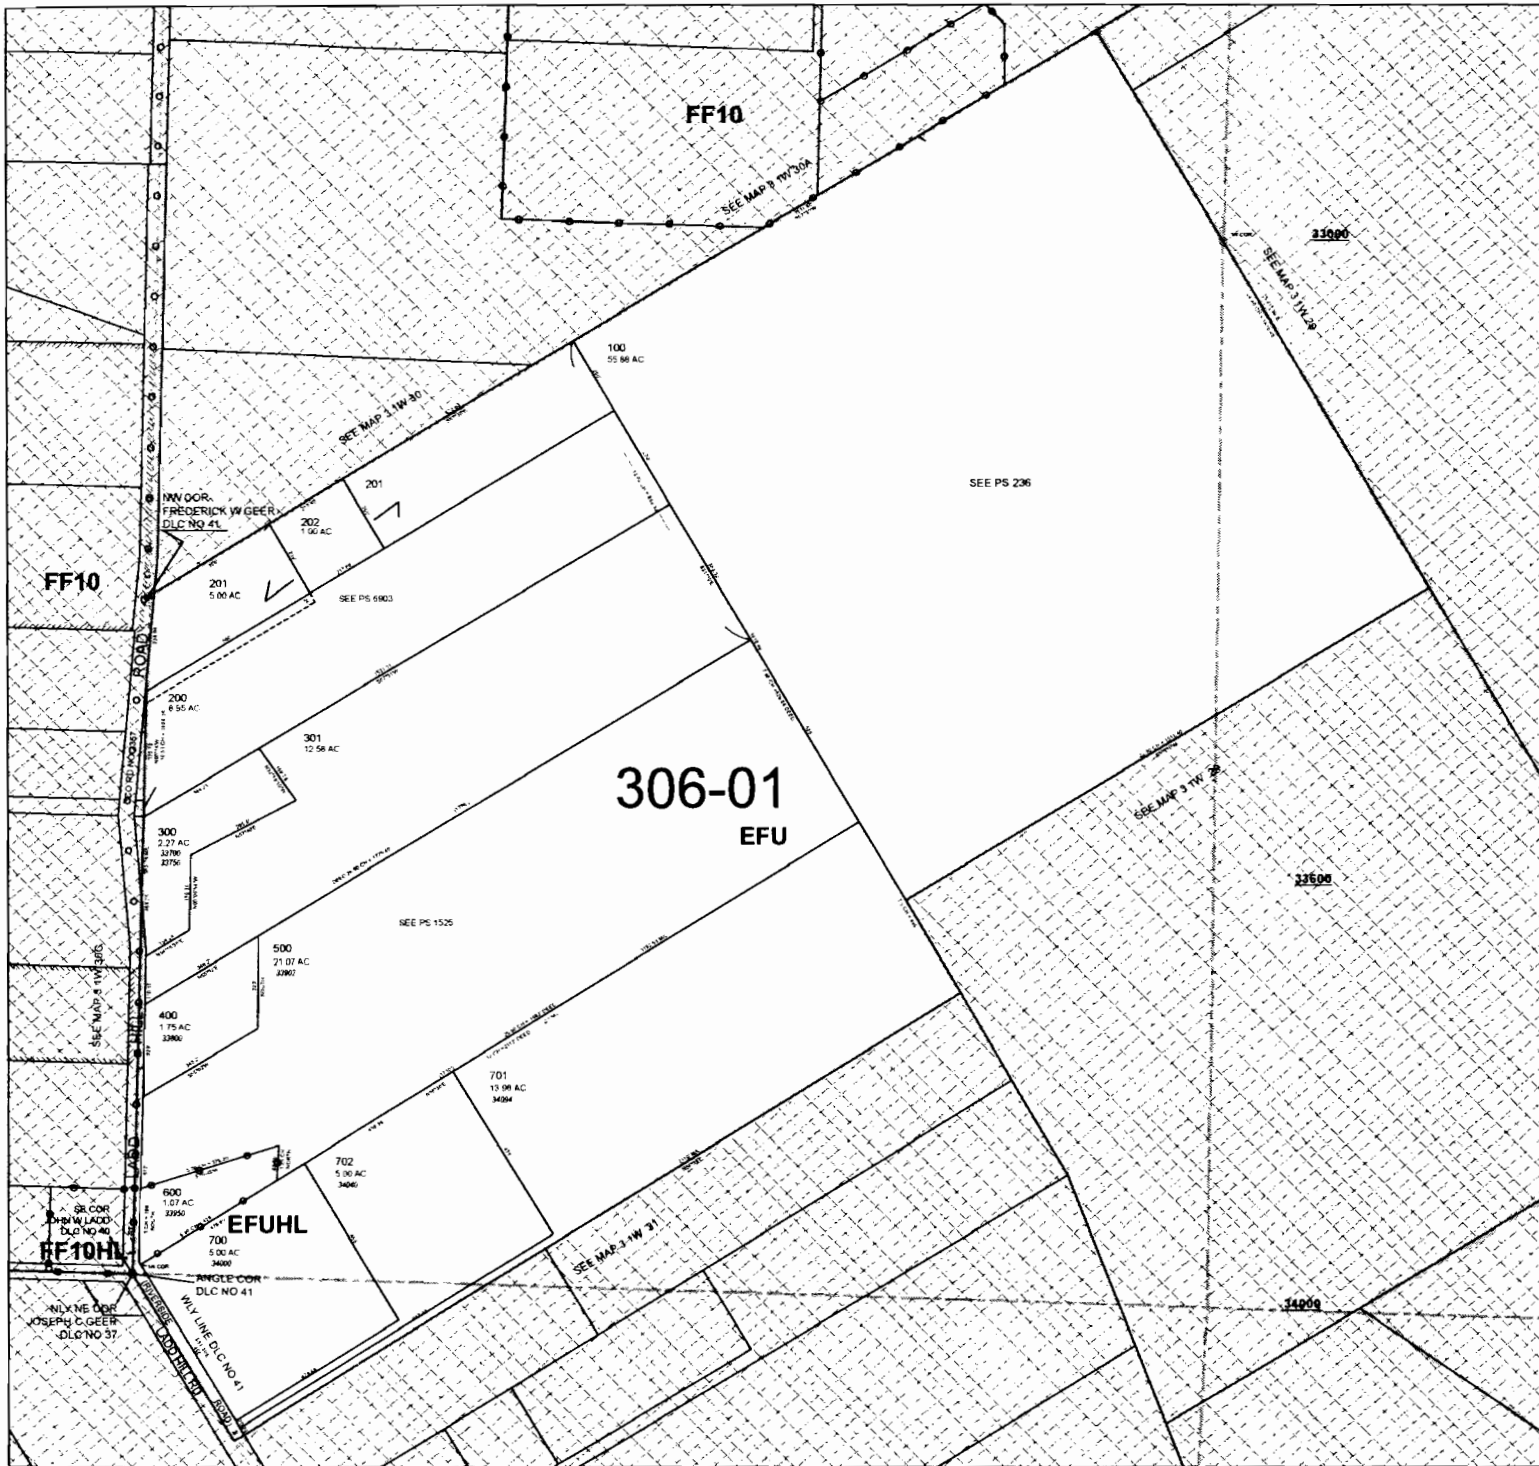

3 1 W 30 D

S.E.1/4 SEC.30 T.3S. R.1W. W.M.
Clackamas County
1" = 200'

D. L. C.

Cancelled Taxlots

Parcel Boundary
Private Road ROW
Historical Boundary
Railroad Centerline
TaxCode Lines
Map Index
Water Lines
Land Use Zoning
Plats
Water
Corner
Section Corner
1/16th Line
Govt Lot Line
DLC Line
Meander Line
PLSS Section Line
Historic Corridor 40'
Historic Corridor 20'

THIS MAP IS FOR ASSESSMENT PURPOSES ONLY

3 1 W 30 D