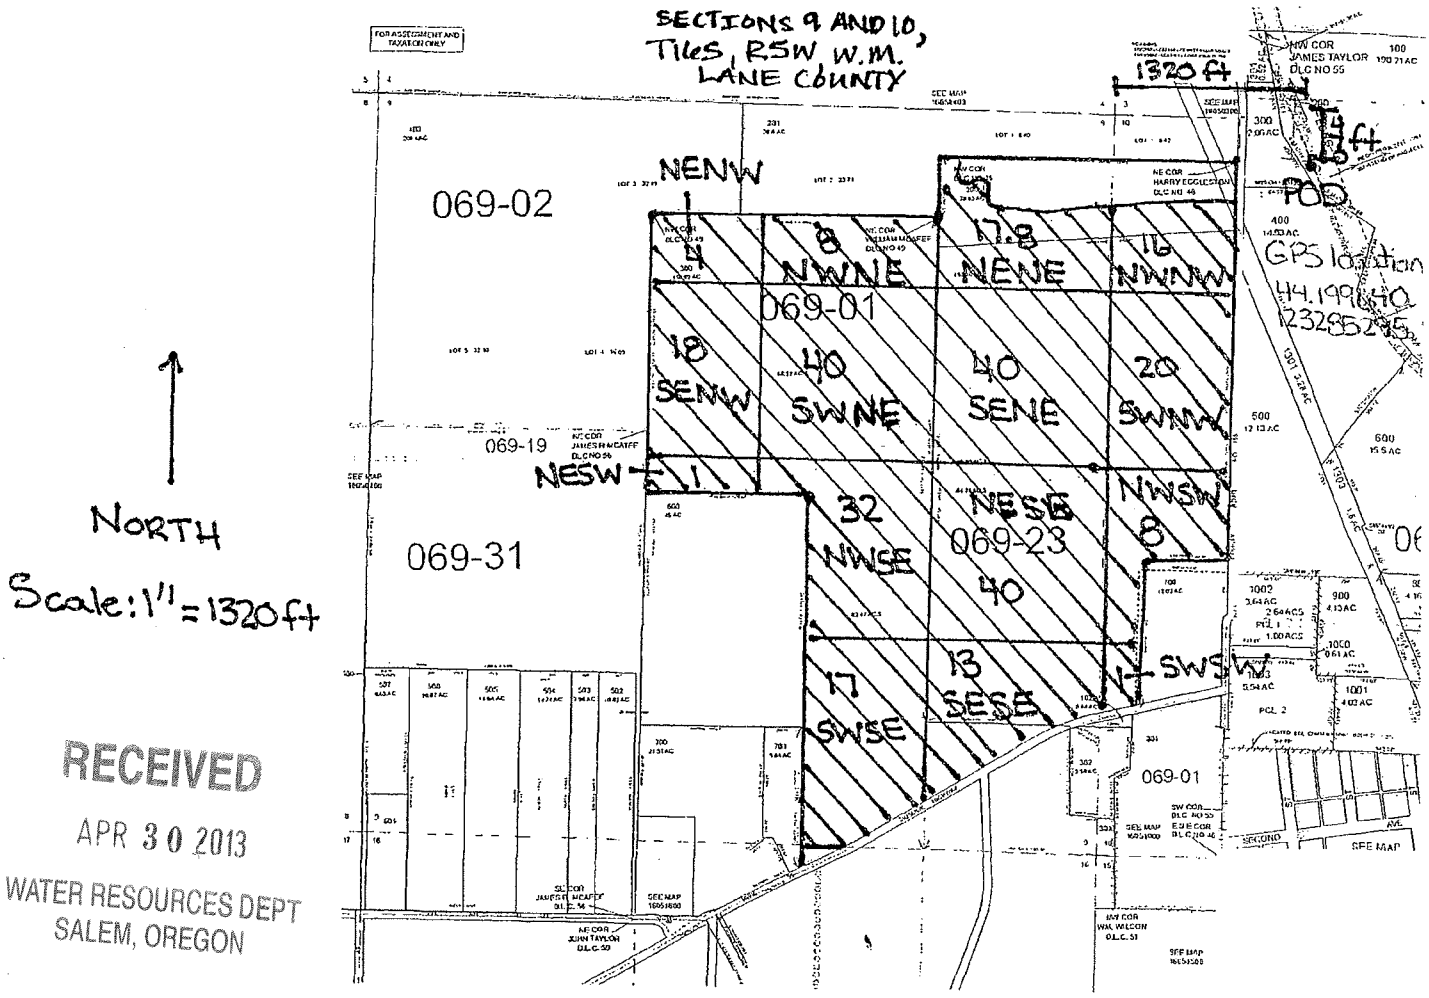

RECEIVED
APR 30 2013
WATER RESOURCES DEPT
SALEM, OREGON

App S-87774