


AMENDED KLAMATH FALLS CLAIM MAP
AMENDED
CLAIM #622



Scale = 1:24 000

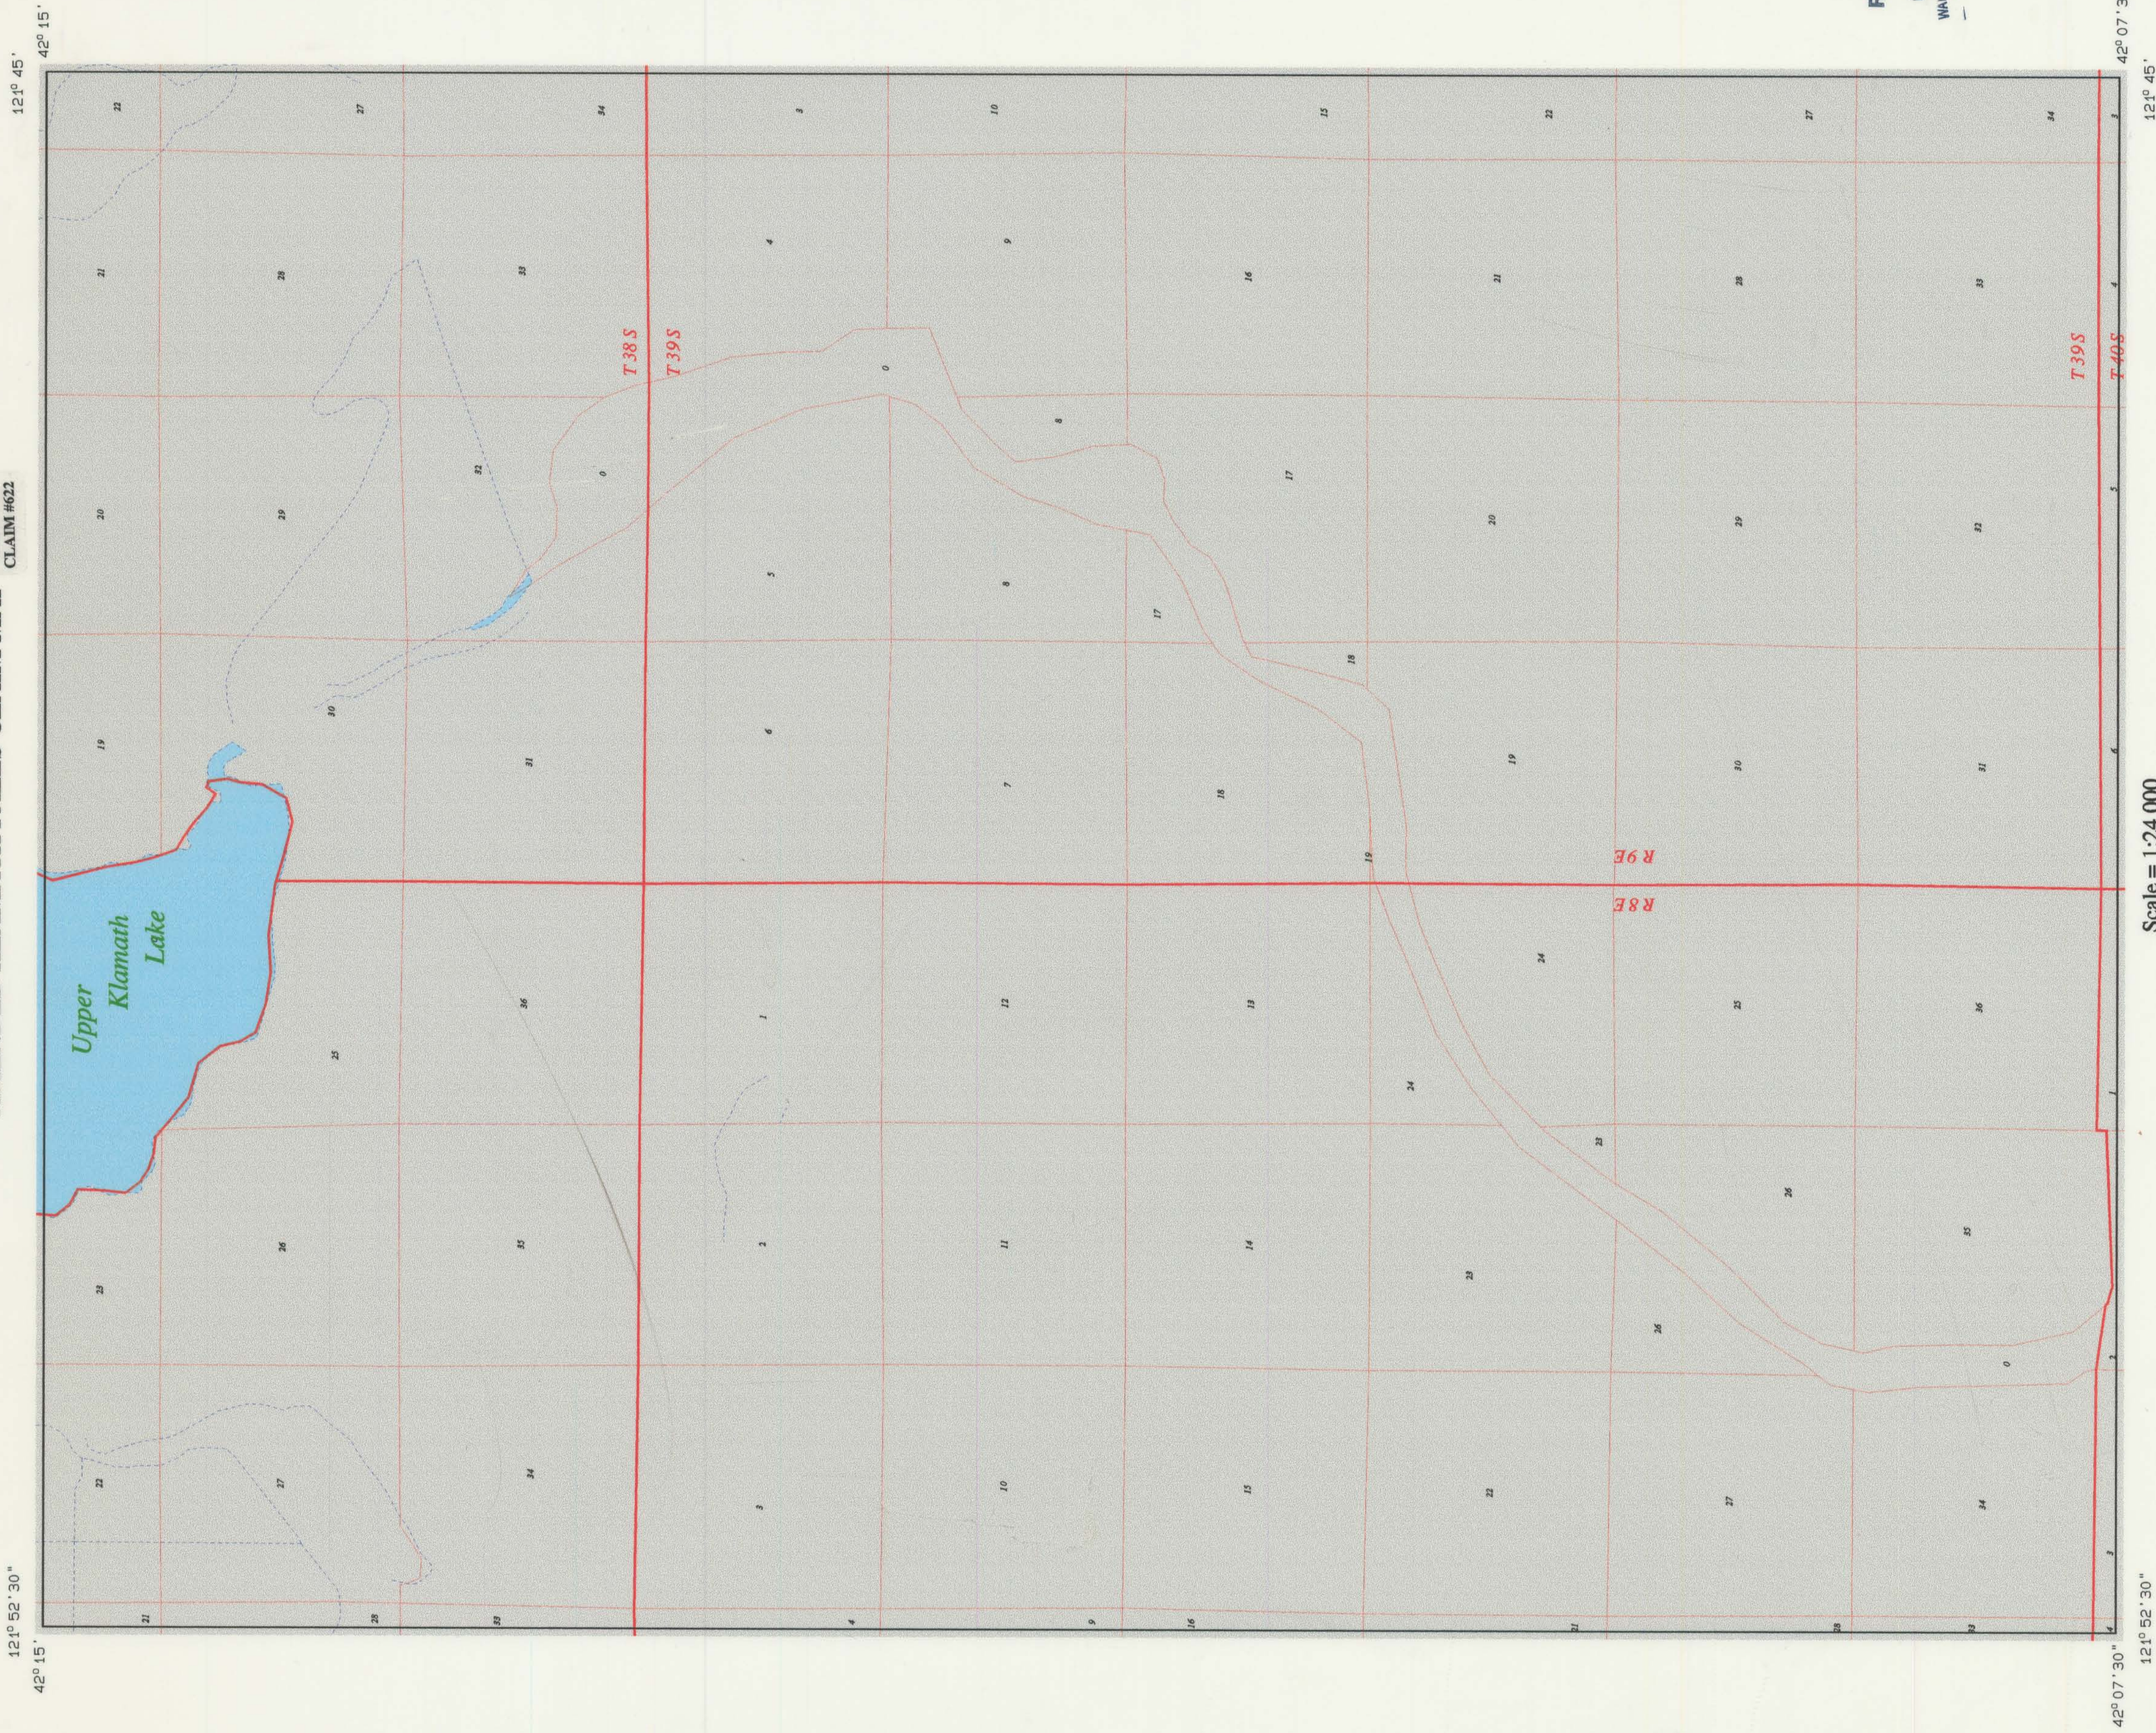

KLAMATH ADJUDICATION
CLAIM # 622 PAGE # 30

LEGEND

- Major River
- Minor stream/Tributary
- Lake, Pond or Marsh Boundary
- U.S. Highway
- State Highway
- Treaty boundary
- Major Road
- County Road
- NF Arterial Road
- Flow Gage

RECEIVED

OCT 01 1999
WATER RESOURCES DEPT
SALEM, OREGON