


Hermiston Irrigation District

Township 5 North Range 29 East W.M.

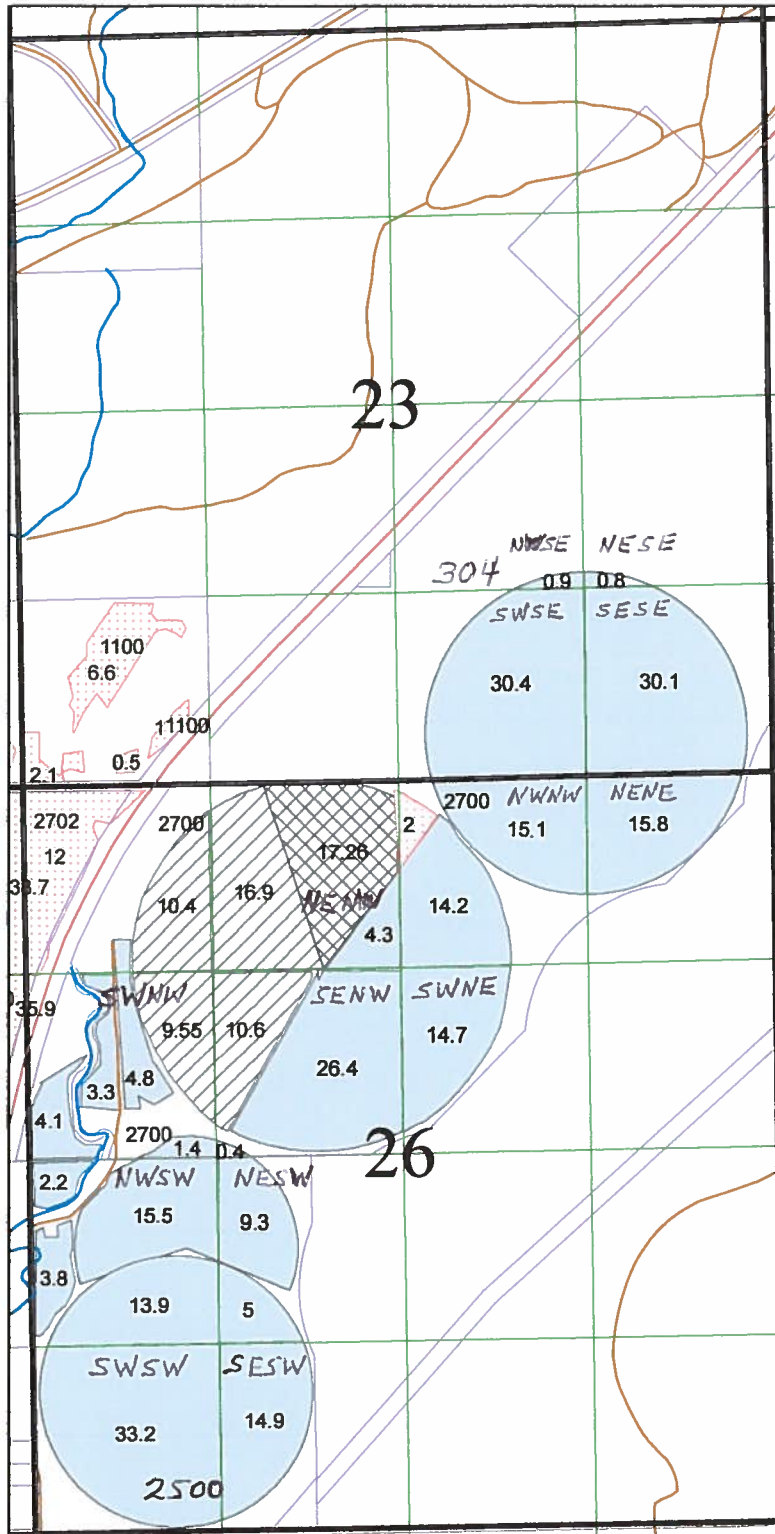

Legend

hd5n29e

USER, DUTY

- HID-A, 3
- HID-A, 6
- HID-M, 3
- HID-M, 6
- NEW, 3

1 in = 1,320 ft

RECEIVED BY OWRD

JUN 14 2013

SALEM, OR

S-87907

This map was prepared for Assessment & Taxation purposes only and has NOT been prepared for legal, engineering or surveying purposes.

SE1/4 T5N R29E WM UMATILLA COUNTY


475-07

5N 29E

AERIAL PHOTO NO. 1P 63-67 & 95-99

1" = 1000'

RECEIVED BY OWRD
JUN 14 2013
SALEM, OR

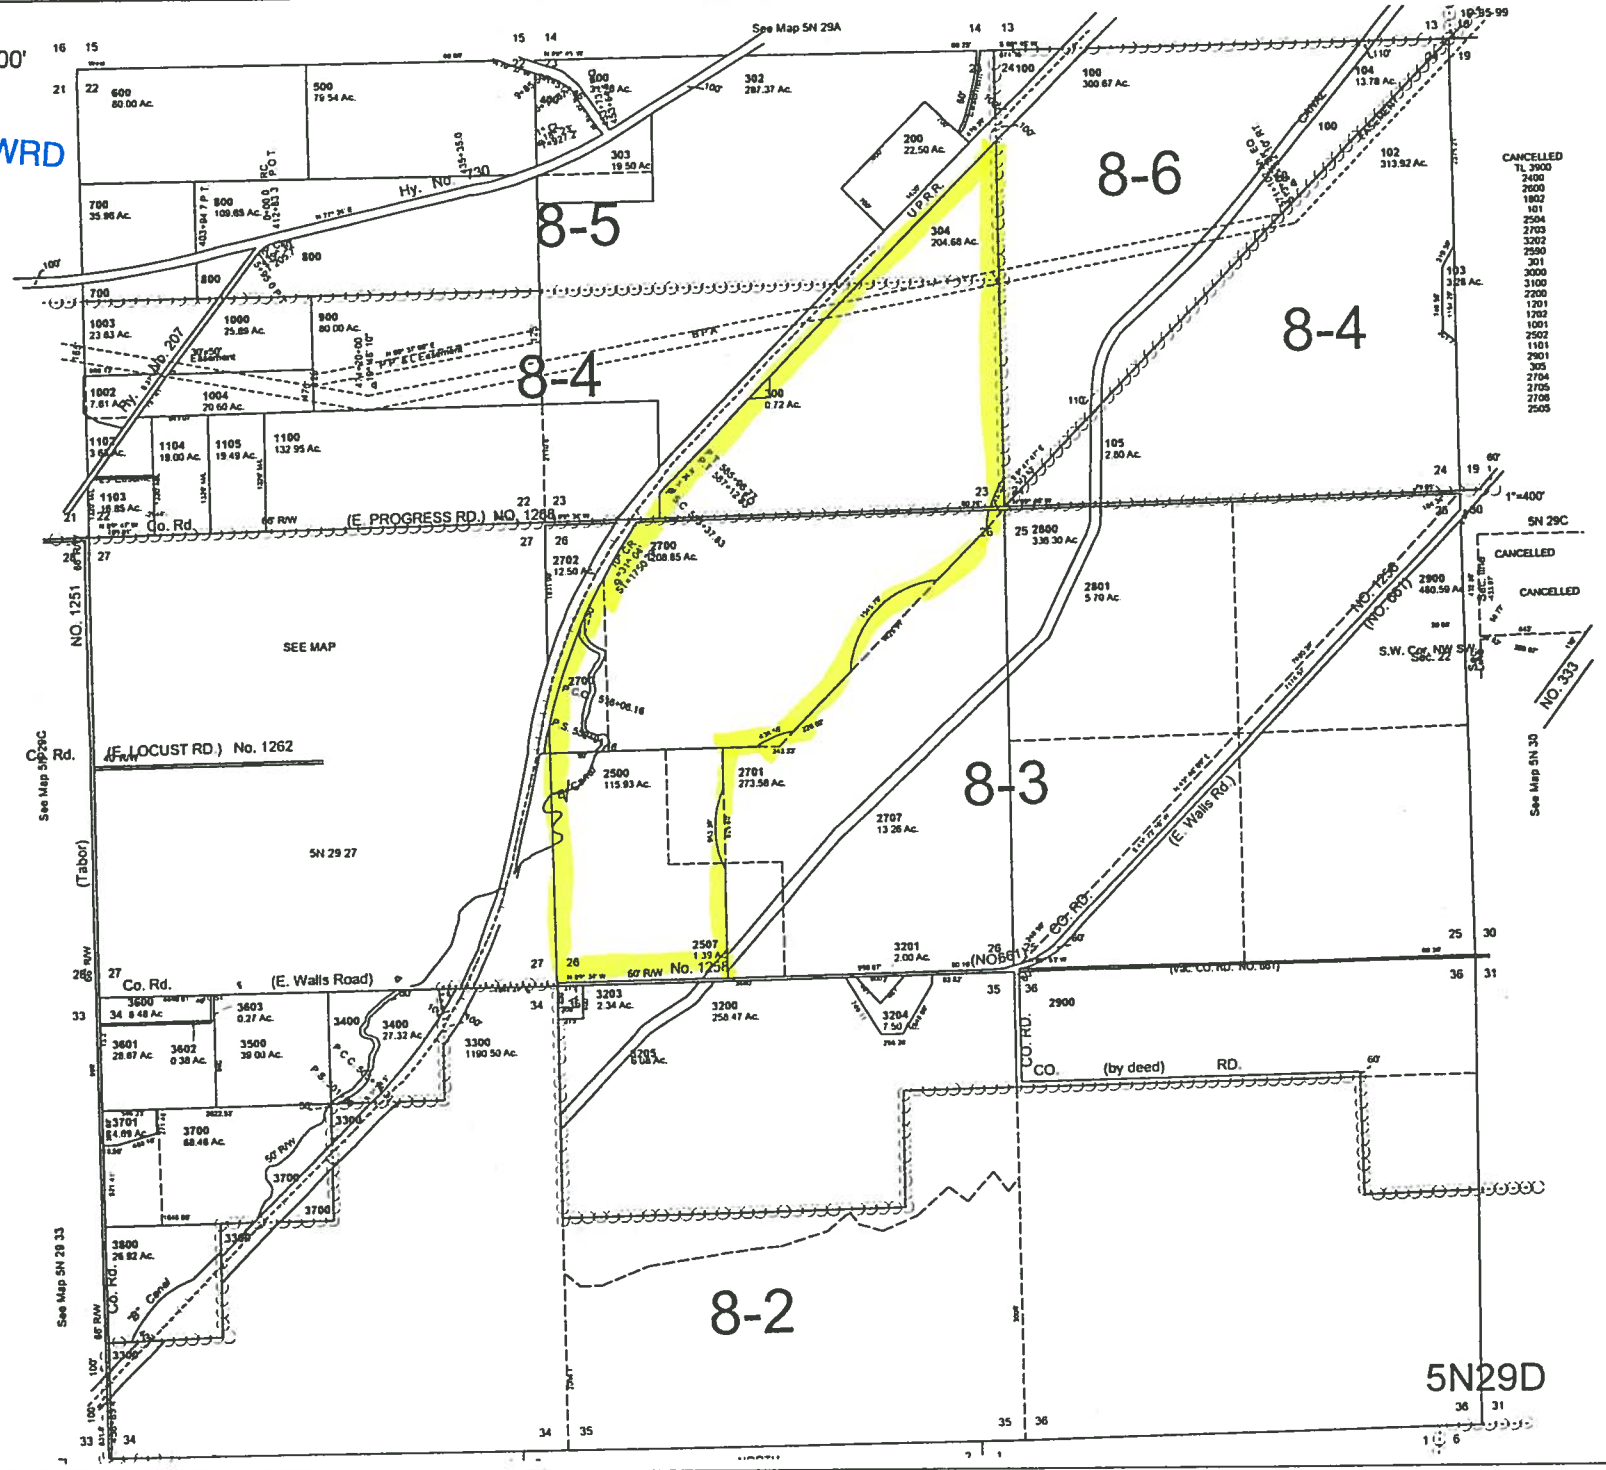


5-8797

- CANCELLED
- 2400
 - 2600
 - 1802
 - 101
 - 2504
 - 2103
 - 3202
 - 2590
 - 301
 - 3000
 - 3100
 - 2500
 - 1001
 - 1201
 - 1202
 - 2502
 - 2001
 - 1101
 - 2704
 - 305
 - 2704
 - 2705
 - 2705
 - 2505

- CANCELLED
- 2900
 - 480.50 AC.
 - NO. 851
 - NO. 353

Hermiston Irrigation District

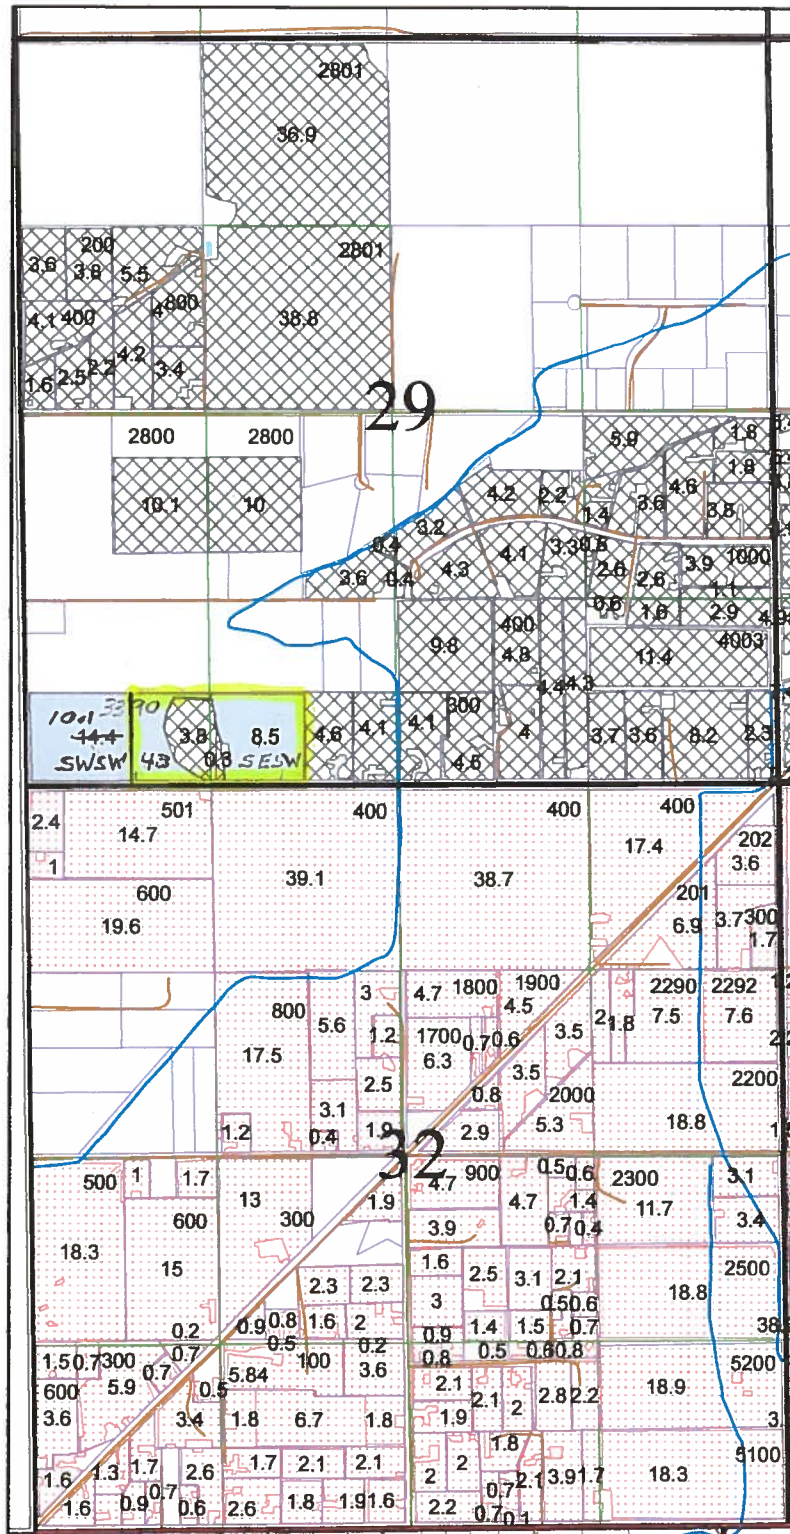

Township 5 North Range 29 East W.M.



Legend

hd5n29e

USER, DUTY

-  HID-A, 3
-  HID-A, 6
-  HID-M, 3
-  HID-M, 6
-  NEW, 3

1 in = 1,320 ft

RECEIVED BY OWRC


JUN 4 2013

SALEM, OR

S-87907

5N2908

5N 29C

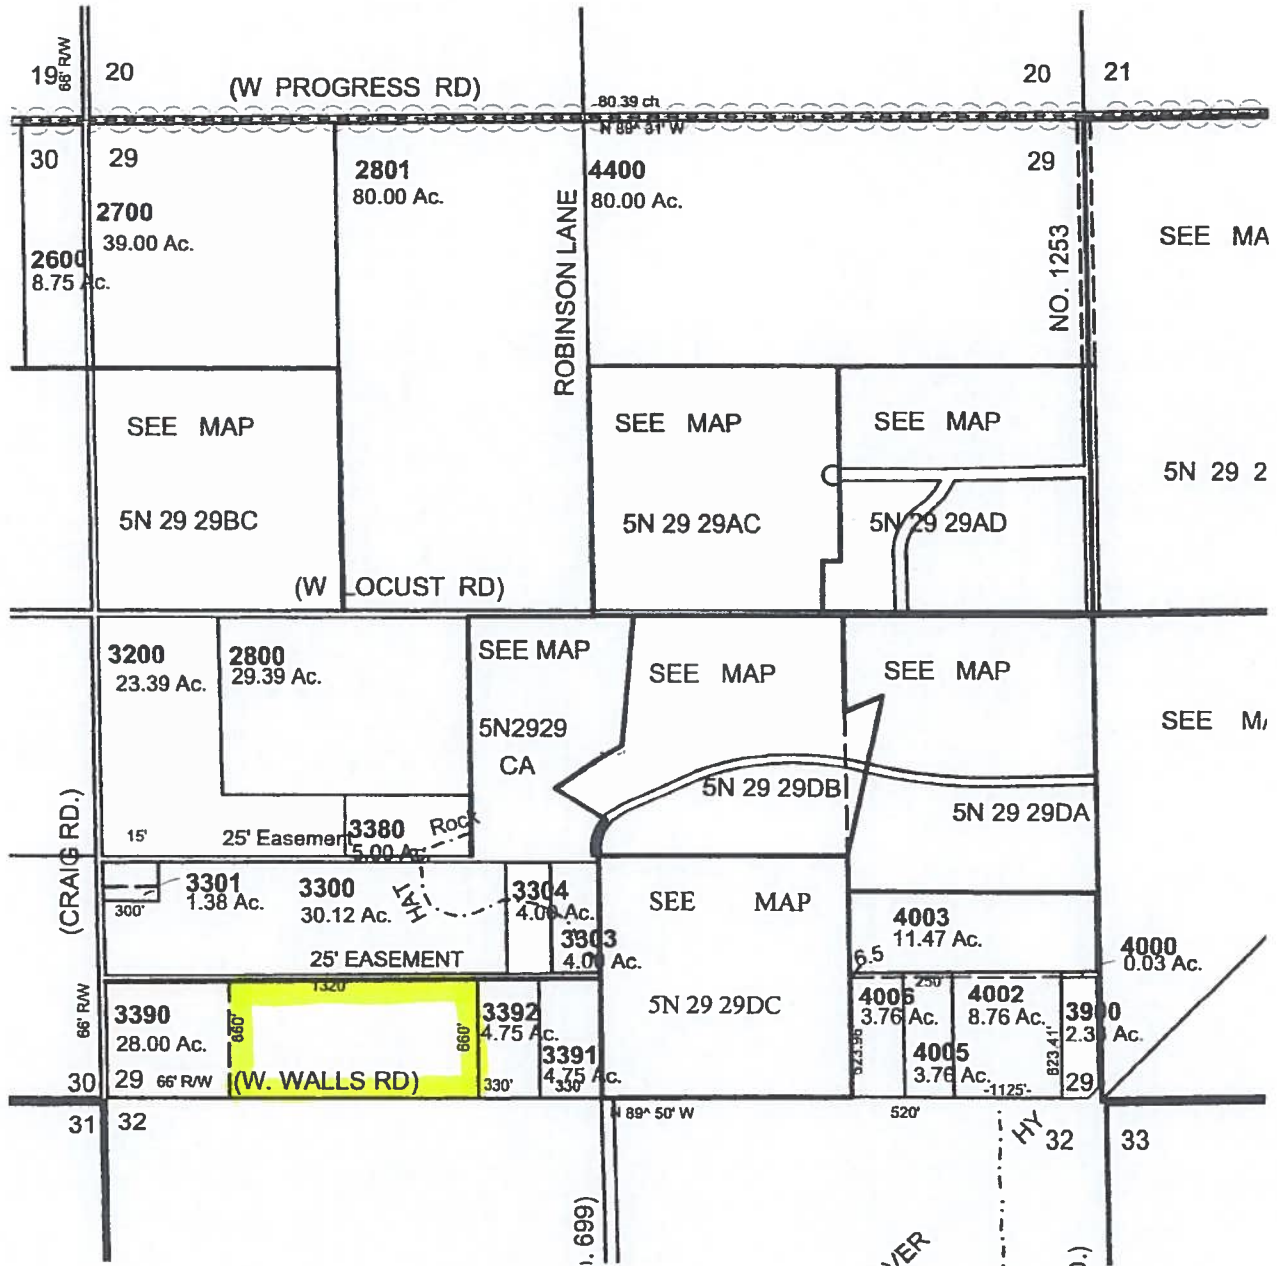

RECEIVED BY OWRD

JUN 14 2013


SALEM, OR

S-07907

RECEIVED BY OWRD

JUN 14 2013


SALEM, OR

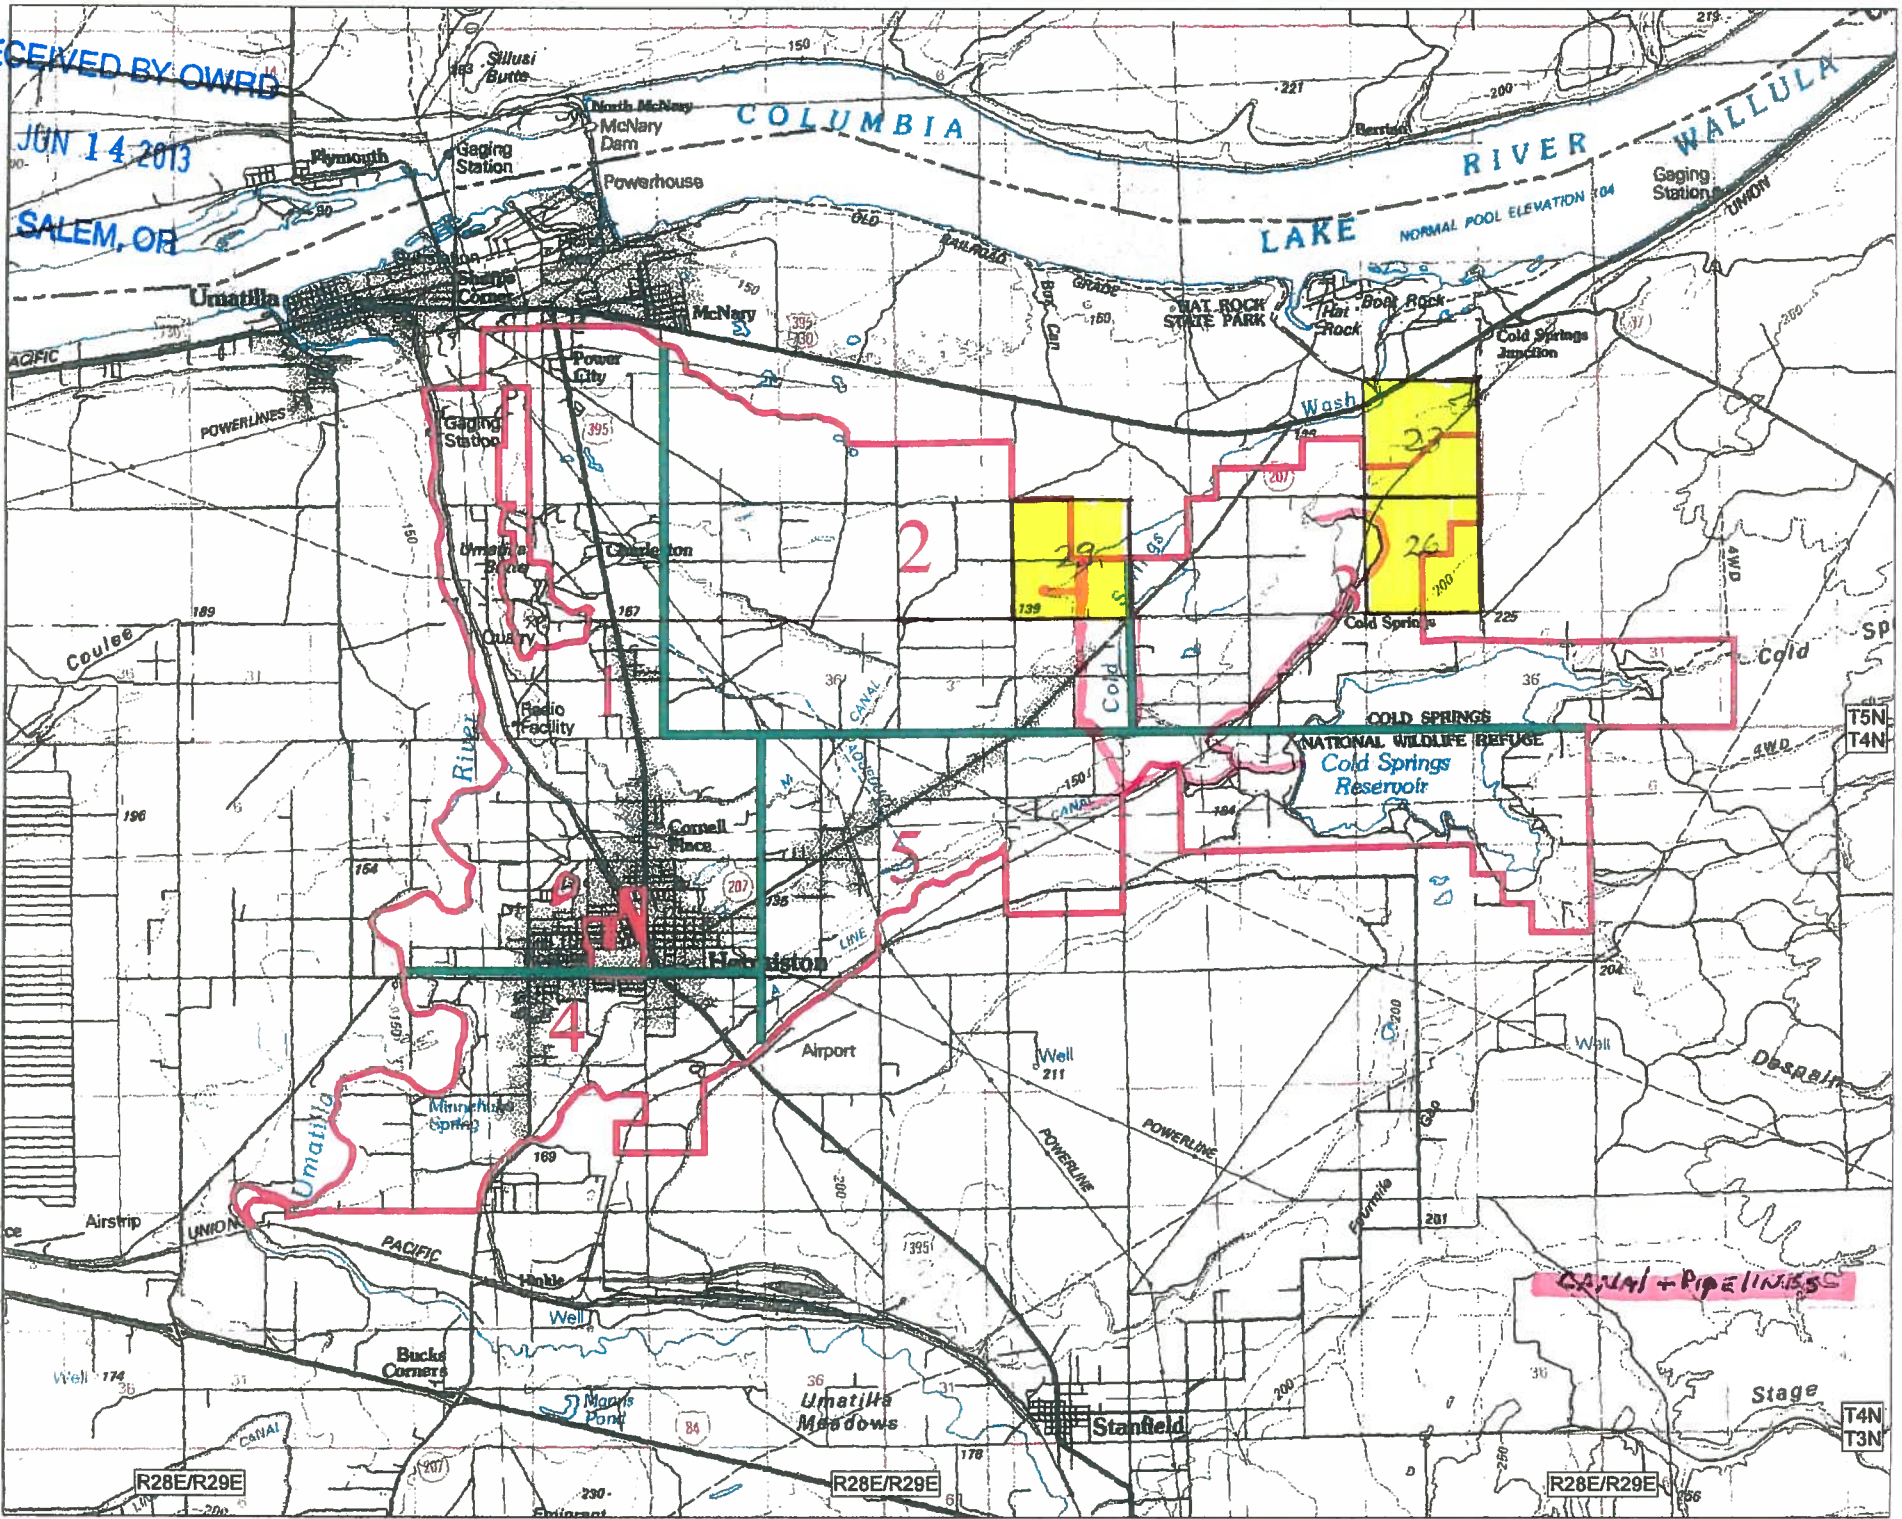

7078-5

Hermiston Irrigation District

Township 5 North Range 29 East W.M.

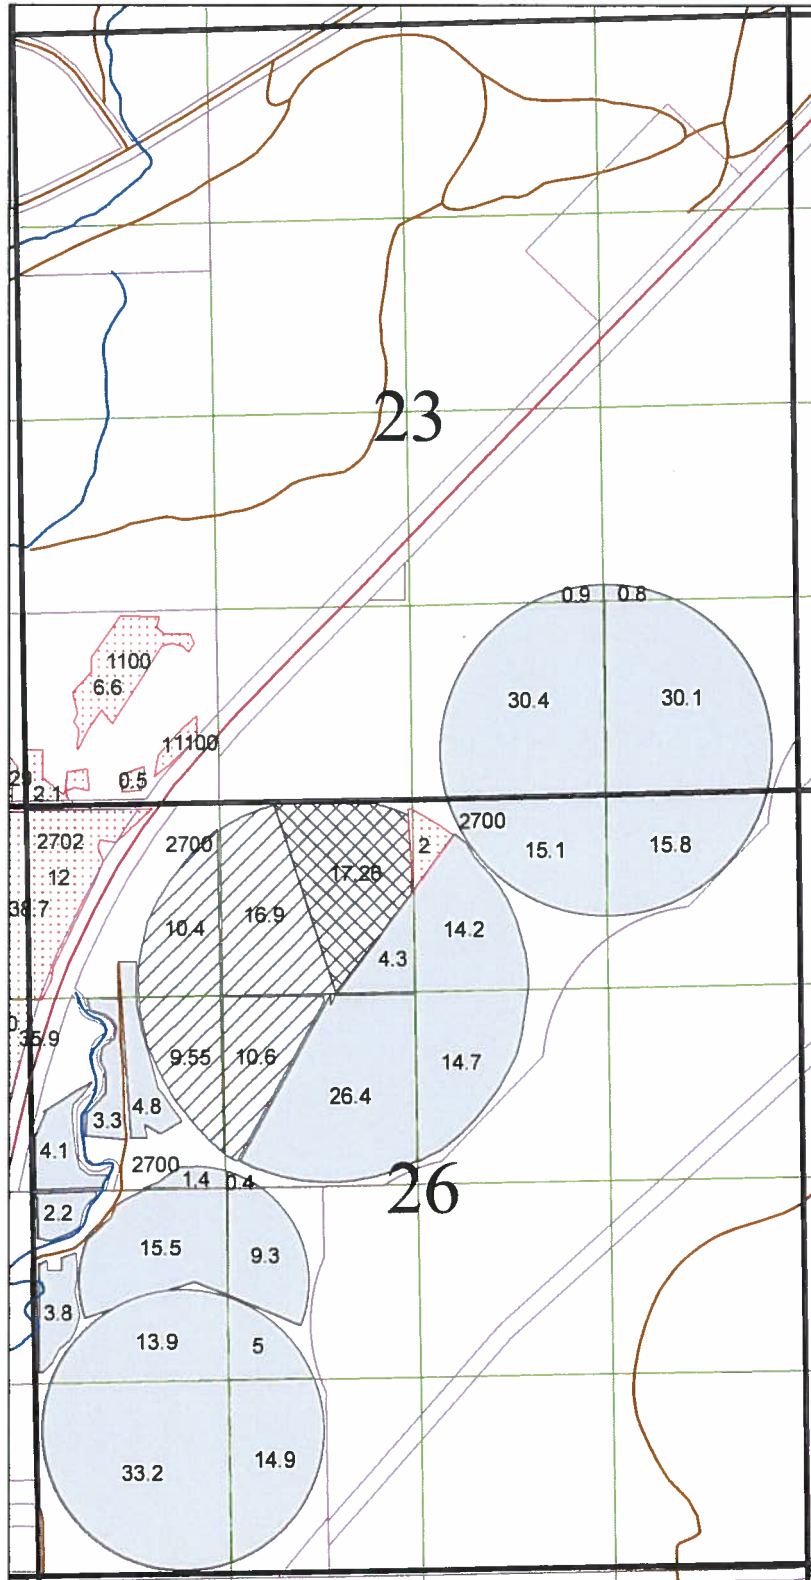

Legend

hd5n29e

USER_, DUTY

- HID-A, 3
- HID-A, 6
- HID-M, 3
- HID-M, 6
- NEW, 3

1 in = 1,320 ft

Hermiston Irrigation District
Cold Springs Reservoir
Townships 4 & 5 North, Range 29 East, W.M.

1 inch = 1320 feet

June 2013

