



Oregon Water Resources Department  
 725 Summer Street NE, Suite A  
 Salem Oregon 97301-1266  
 (503) 986-0900  
 www.wrd.state.or.us

# Certificate of Water Right Ownership Update

## NOTICE TO SELLERS & BUYERS:

By law, all water belongs to the public (ORS 537.110). In almost every instance, a permit or water right certificate from the Water Resources Department is needed before using, diverting or storing water (ORS 537.130). However, most domestic wells do not require water rights. A certificate of water right stays with the land. In order to keep track of water right ownership, the Department requests that this form be submitted to the Department. **If for multiple rights, a separate form for each right will be required.**

Water that has been used for a long time in one place or that involves a water structure (like a dam) that already exists is no guarantee that there is a water right which would allow the water use to continue.

If you have any questions about this form or water right requirements, please contact your local watermaster or call the Water Resources Department at 503-986-0900.

Note: Please type or print legibly when filling in the following information. Use additional paper if necessary.

DEEDED

RECEIVED BY OWRD

### PROPERTY SELLER INFORMATION

Applicant(s): CECILIA J. CORREA NOV 01 2012  
First Last  
 Mailing Address: 32697 CORREA LN. SALEM, OR  
ECHO OREGON 97826  
City State Zip  
 Phone: 541-449-3226 NONE -  
Home Work Other

### PROPERTY BUYER INFORMATION

Applicant(s): RICHARD J. CORREA (SON)  
First Last  
 Mailing Address: 32581 CORREA LN.  
ECHO OREGON 97826  
City State Zip  
 Phone: 541-3558 541-449-3558 SAME  
Home Work Other

### PROPERTY DESCRIPTION (attach additional pages if necessary):

County: UMATILLA Township: 3N Range: 29 Section: 5

Tax Lot Number(s): 2100 CORREA LN.

Street address of water right property: 32581 - ECHO, OR. 97826

Water Right Information (attach copy of water right permit or certificate & final proof map):

Application #: B-7142 Permit #: B-6592 Certificate or Page #: 46100

Will all the lands associated with this water right be owned by the buyer?  Yes  No

Name of individual completing this form: Cecilia J. Correa Phone: 541-449-3226

Signature: Cecilia J. Correa Date: \_\_\_\_\_


**Please be sure to attach a copy of your property deed or legal description of the property.**

T. 3N. R. 29E. W.M.

RECEIVED BY OWRD

NOV 01 2012

SALEM, OR

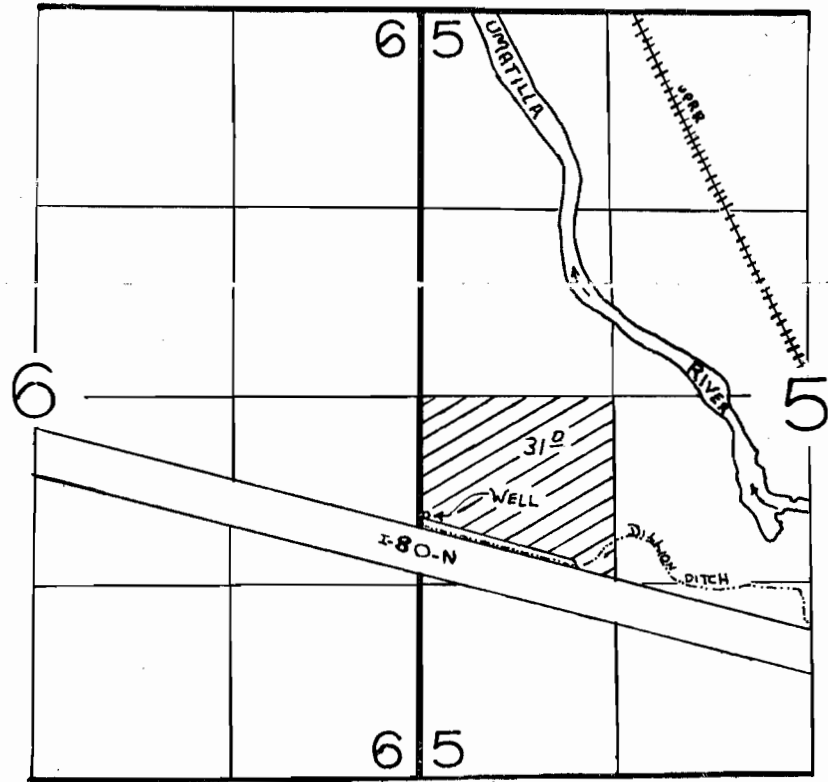

WELL LOCATED 1820' N & 30' E FROM SW COR OF SEC 5

**FINAL PROOF SURVEY**  
UNDER

Application No. G-7142 Permit No. G-6592  
IN NAME OF

.....**CECILIA J. CORREA**.....

Surveyed NOV. 8..... 1977., by BOB...BARWIN

*Lower End*