

RECEIVED

JUL 01 2013


M. K. Campbell GW application Map
T2S R20E Sec. 5 TL 400

WATER RESOURCES DEPT
SALEM, OREGON



0 200 400 800 Feet



1 inch = 400 feet

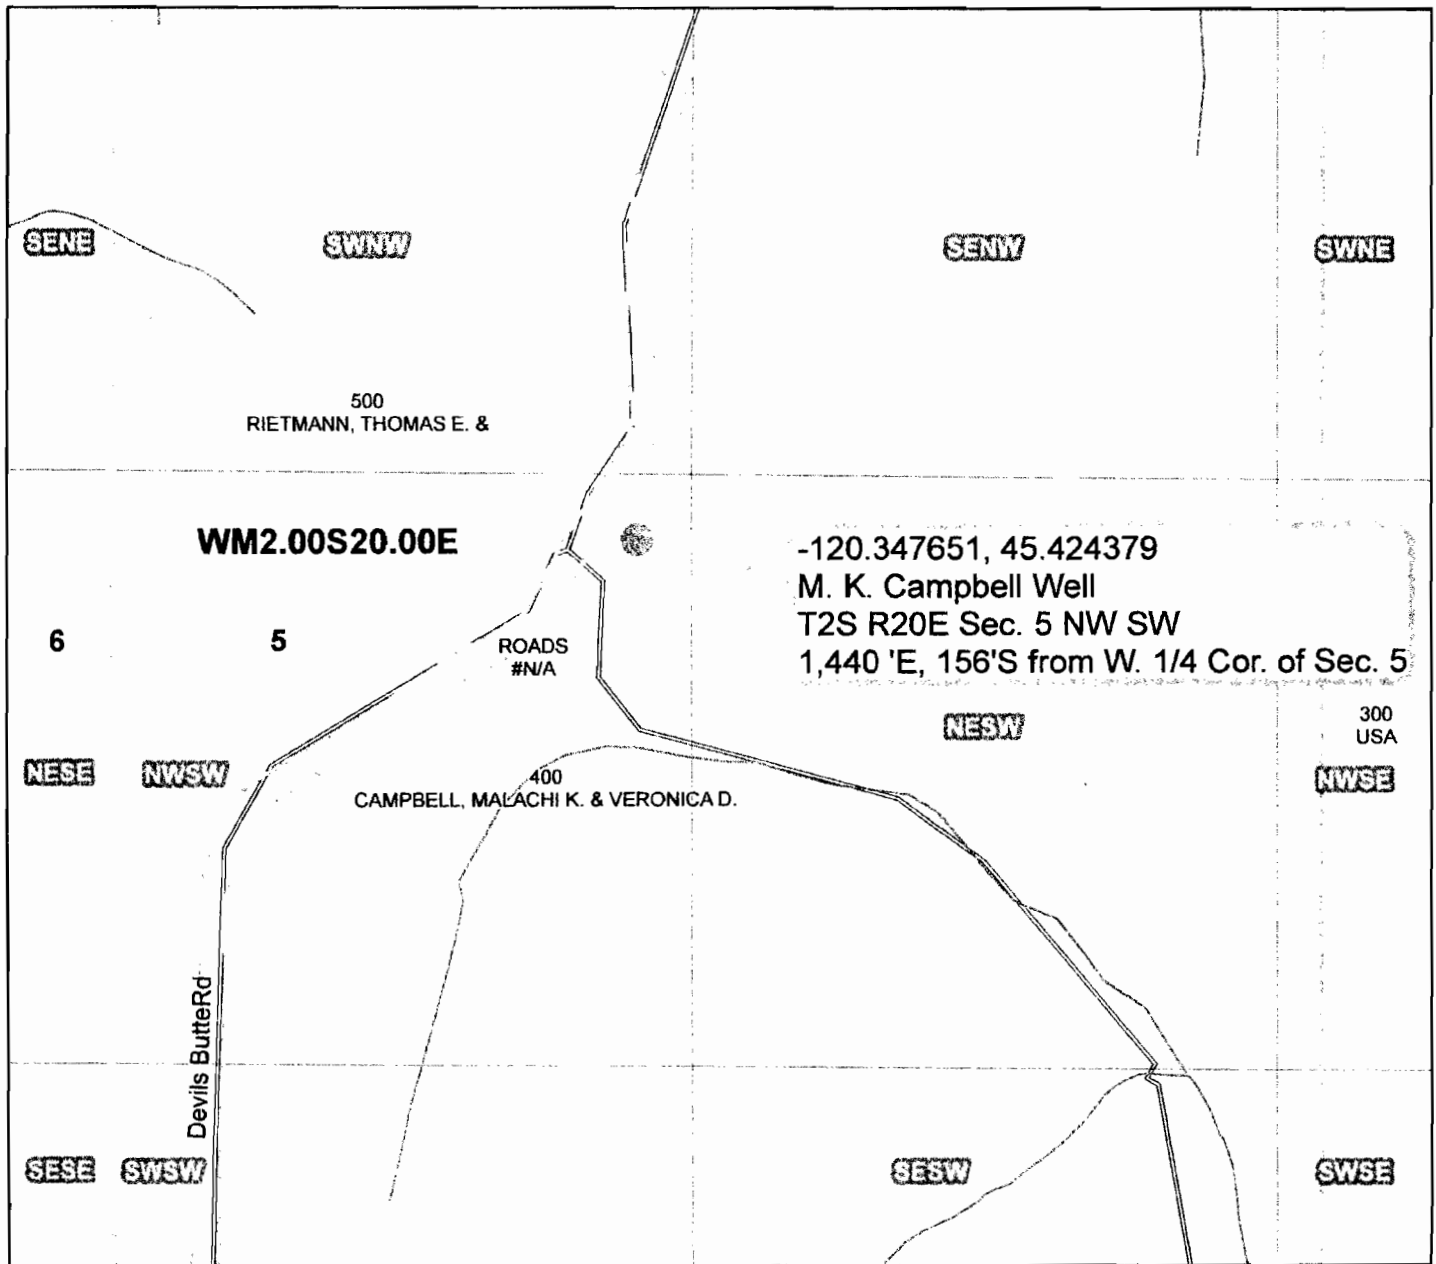

G-7695

POA
Map

THIS MAP WAS PREPARED FOR
ASSESSMENT PURPOSE ONLY

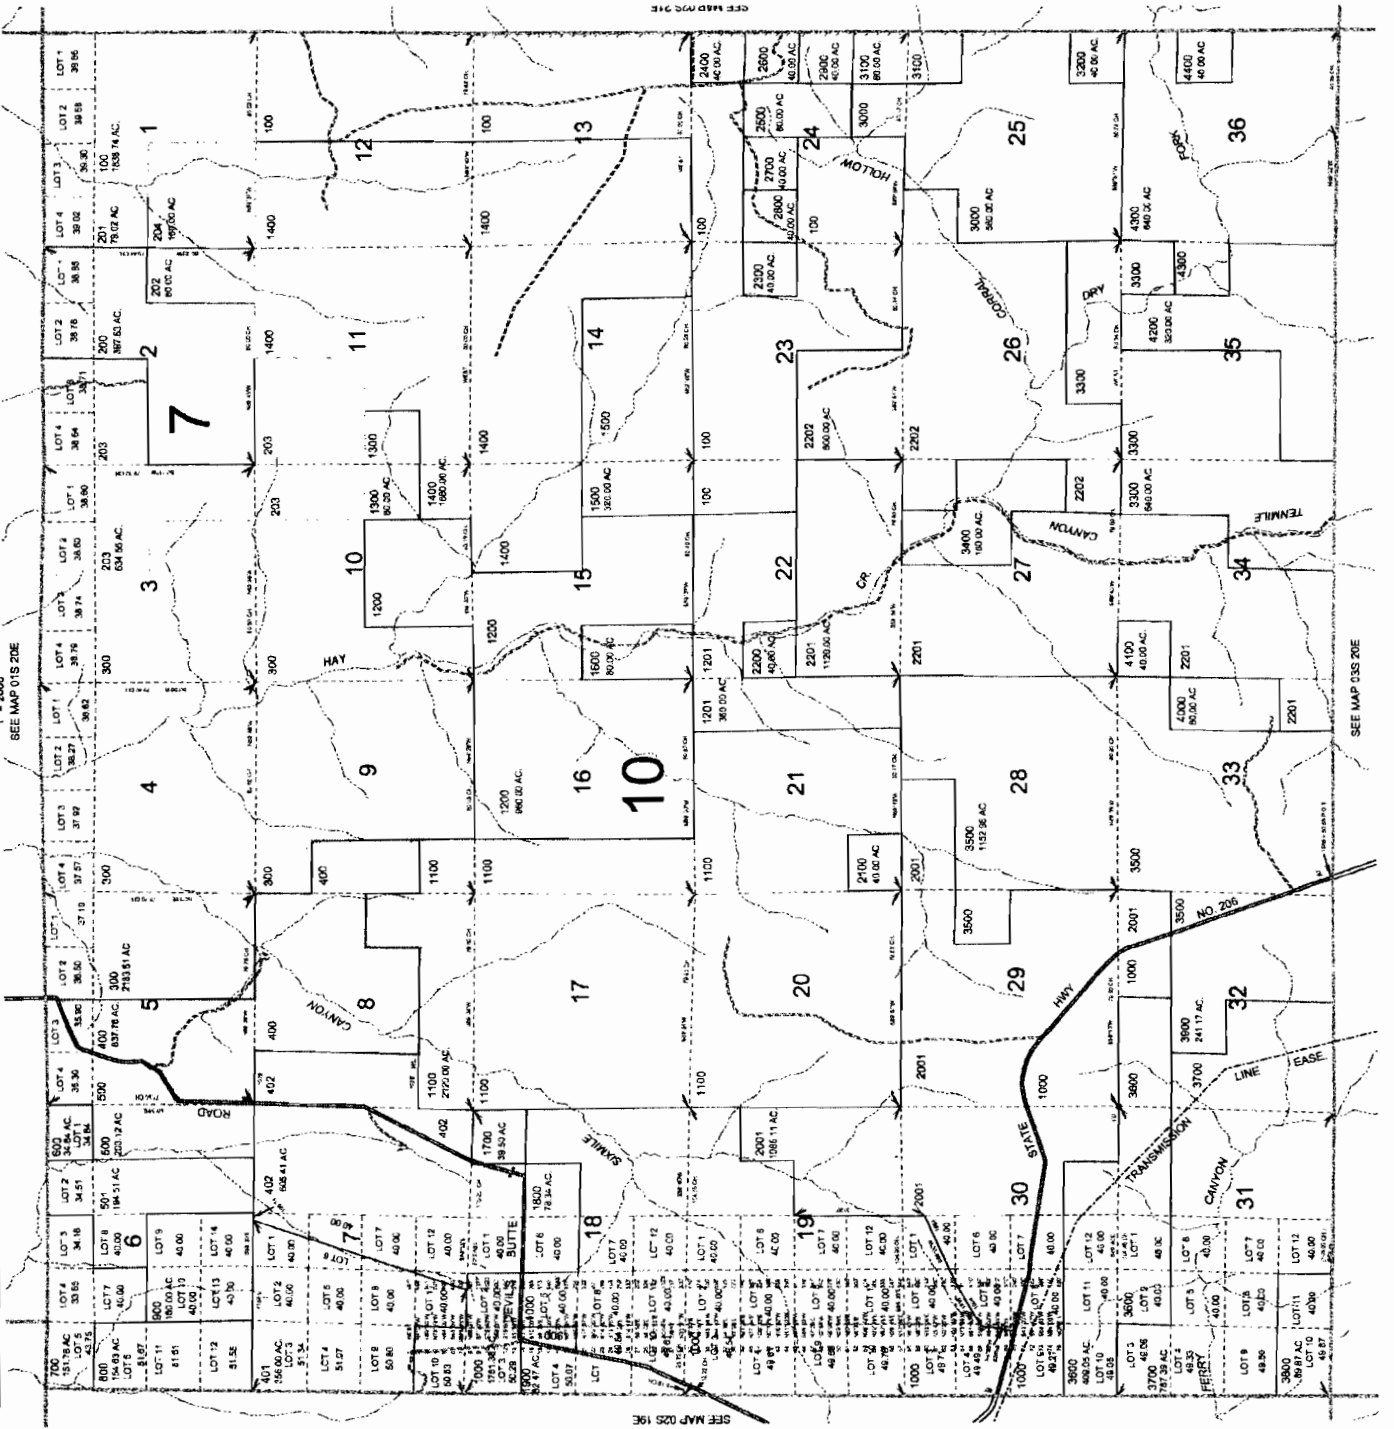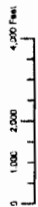


G-17695

poll
map

RECEIVED BY OWRD

JUL 02 2013

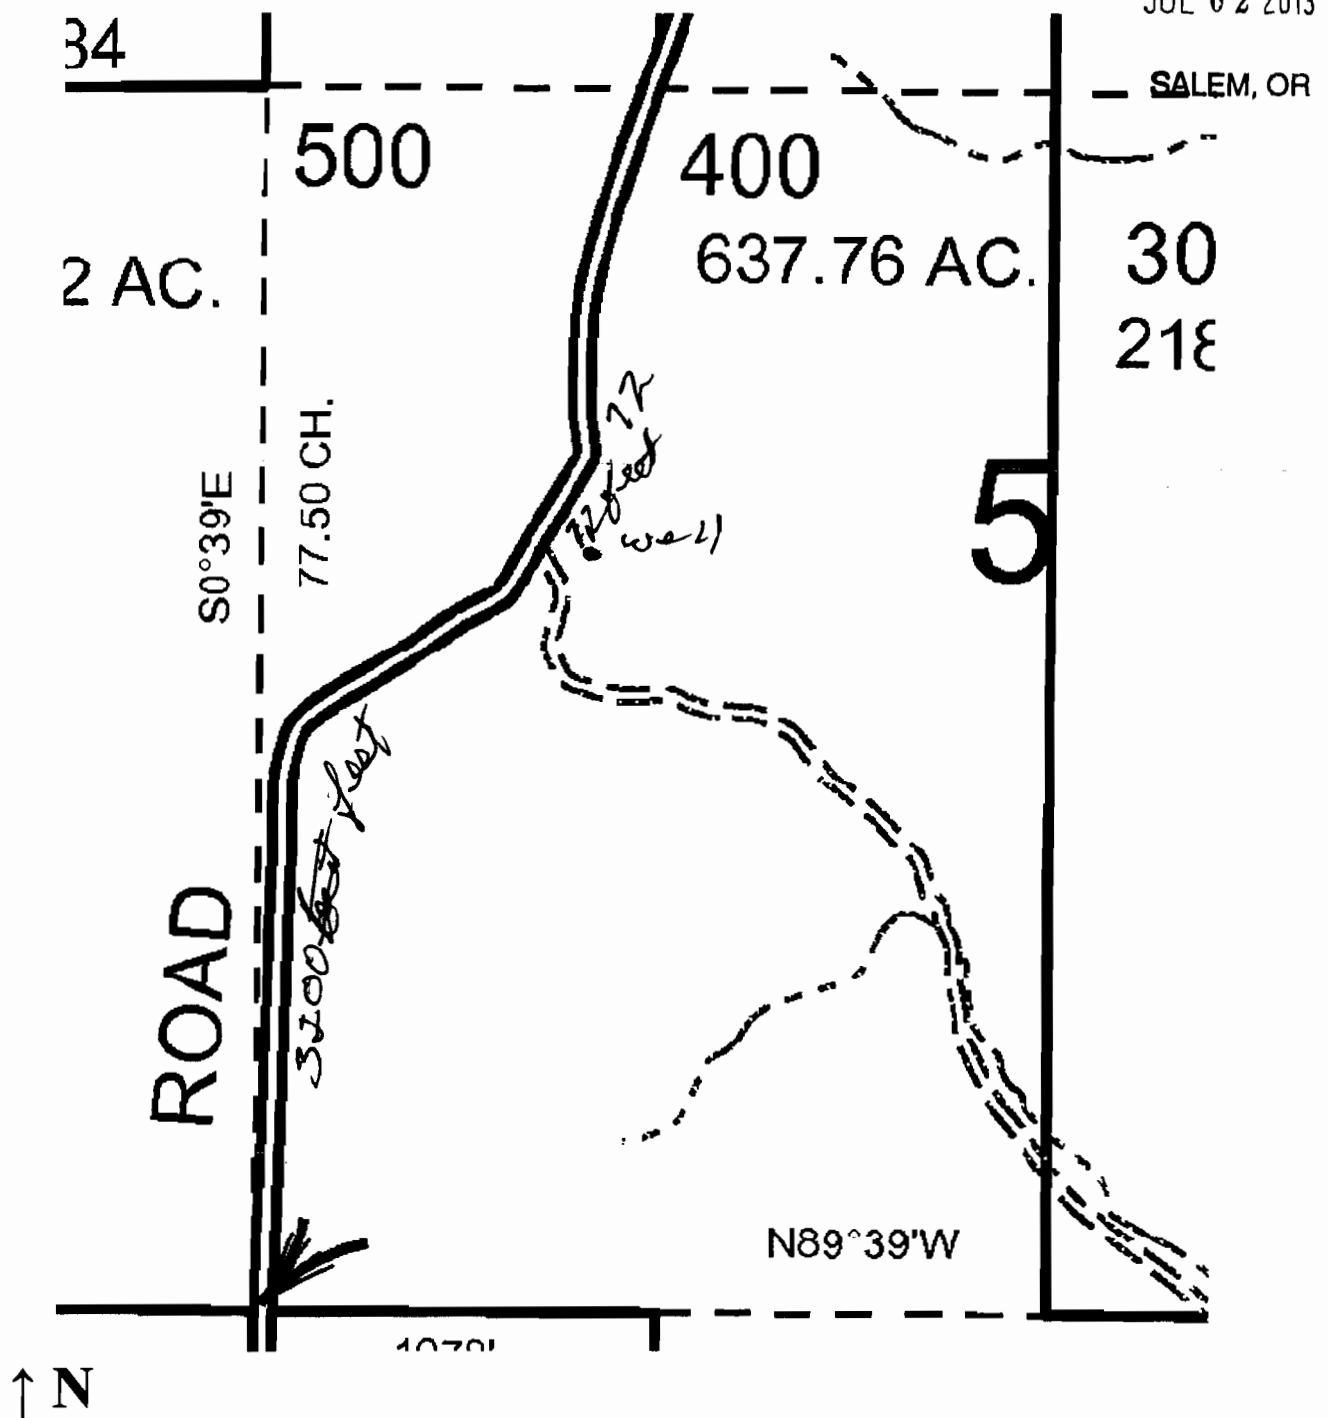

Gilliam County

Assessor Map Reference Number: 2S 20E 5 NWSW; Tax Lot 400

Street Address of Well, if Available: **Mikkalo Road 5 Miles North of Hwy 207,**

Condon, OR, Well Label (ID) # L 1008493 (Please Locate Well and Indicate distance From Property or Survey Corner, See Attached Sample Well Location Map.) MAP NOT TO SCALE

G-17695