Map to Accompnay
Tom & Fawn Kerns
Ground Water Application

T. 8S, R. 39E. WM

Scale: 1" = 1320'

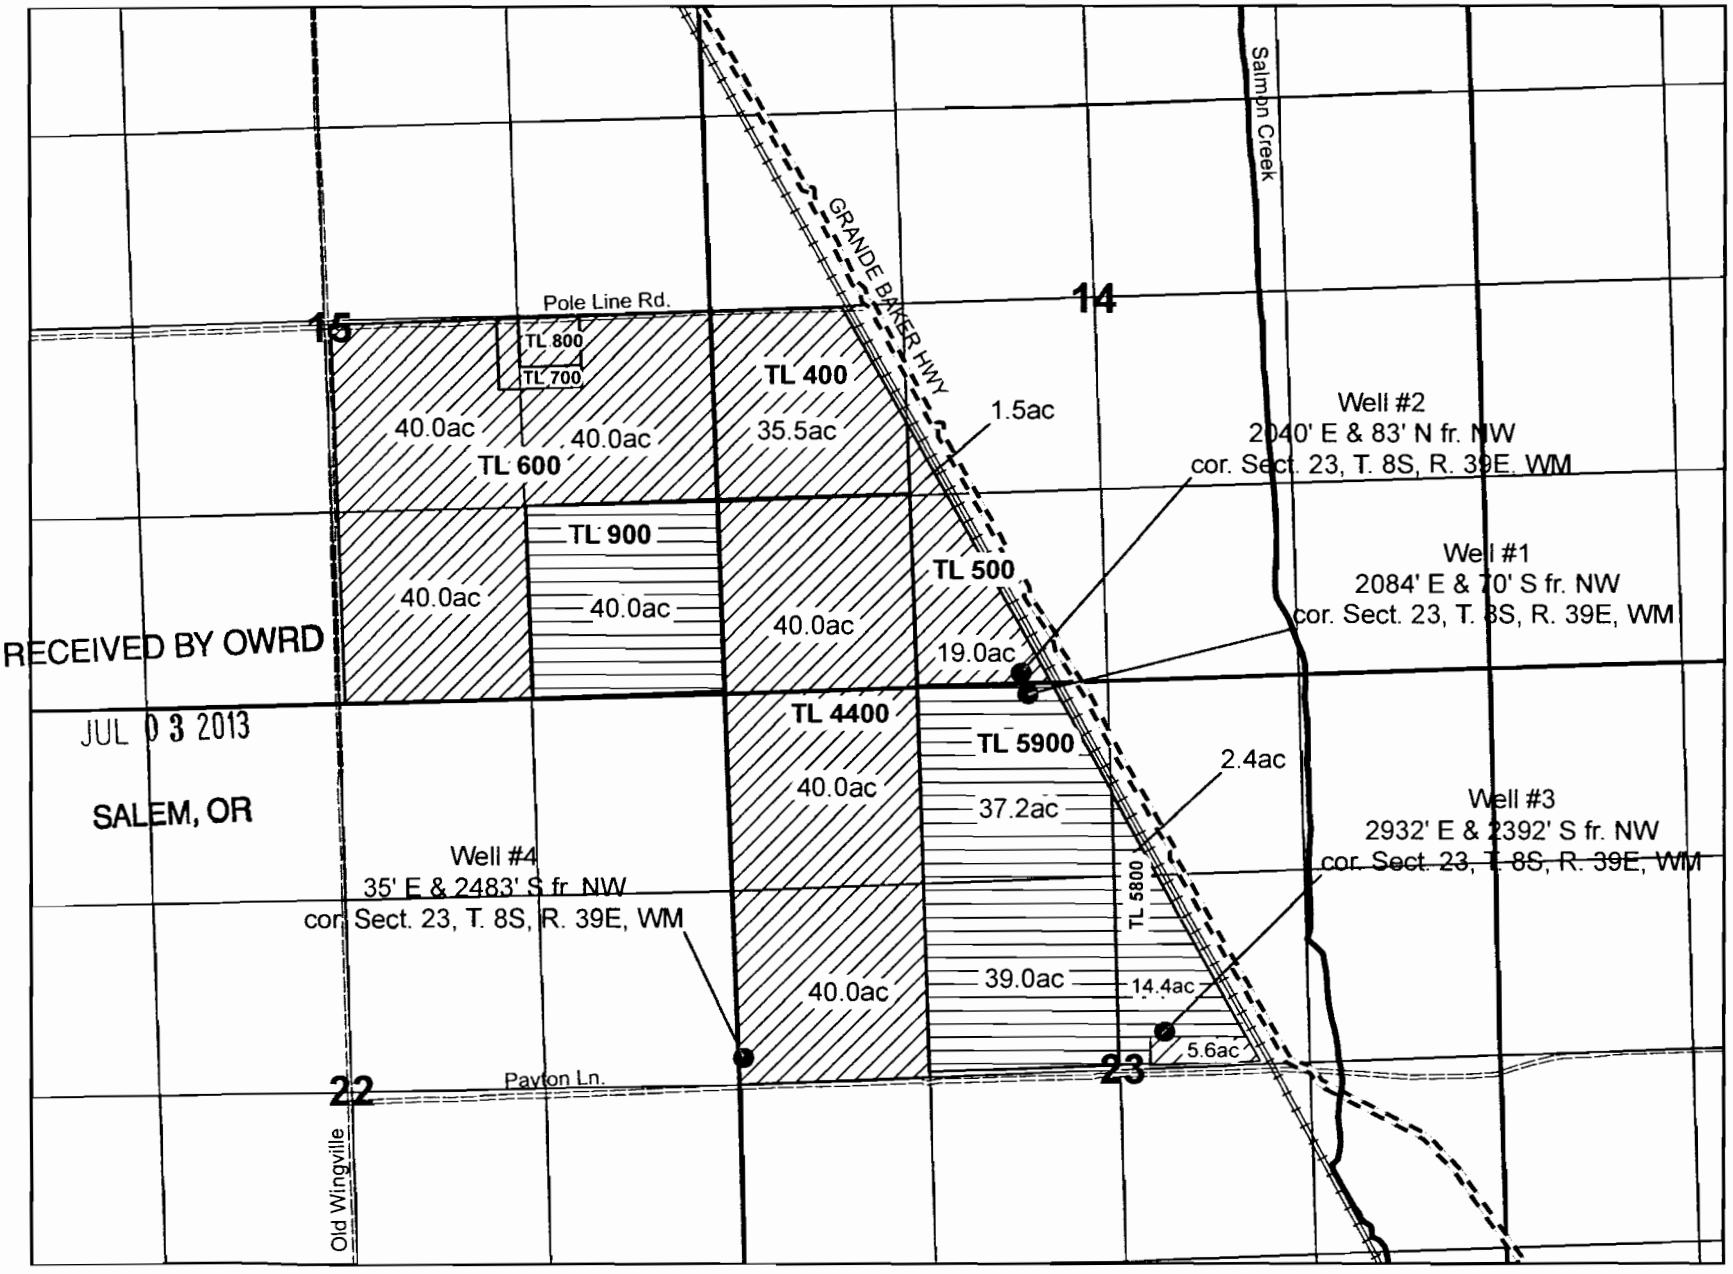

RECEIVED BY OWRD
JUL 03 2013
SALEM, OR