

Map No. P-83030

P-78218




SEE MAP 40 9 24

1" = 400'

40-8-19
501-98
500
Ac.

THIS SKETCH IS FOR LOCATION PURPOSES
AND NO LIABILITY IS ASSUMED FOR
VARIATIONS DETERMINED BY SURVEY
JOSEPHINE COUNTY TITLE
10.00 AC.

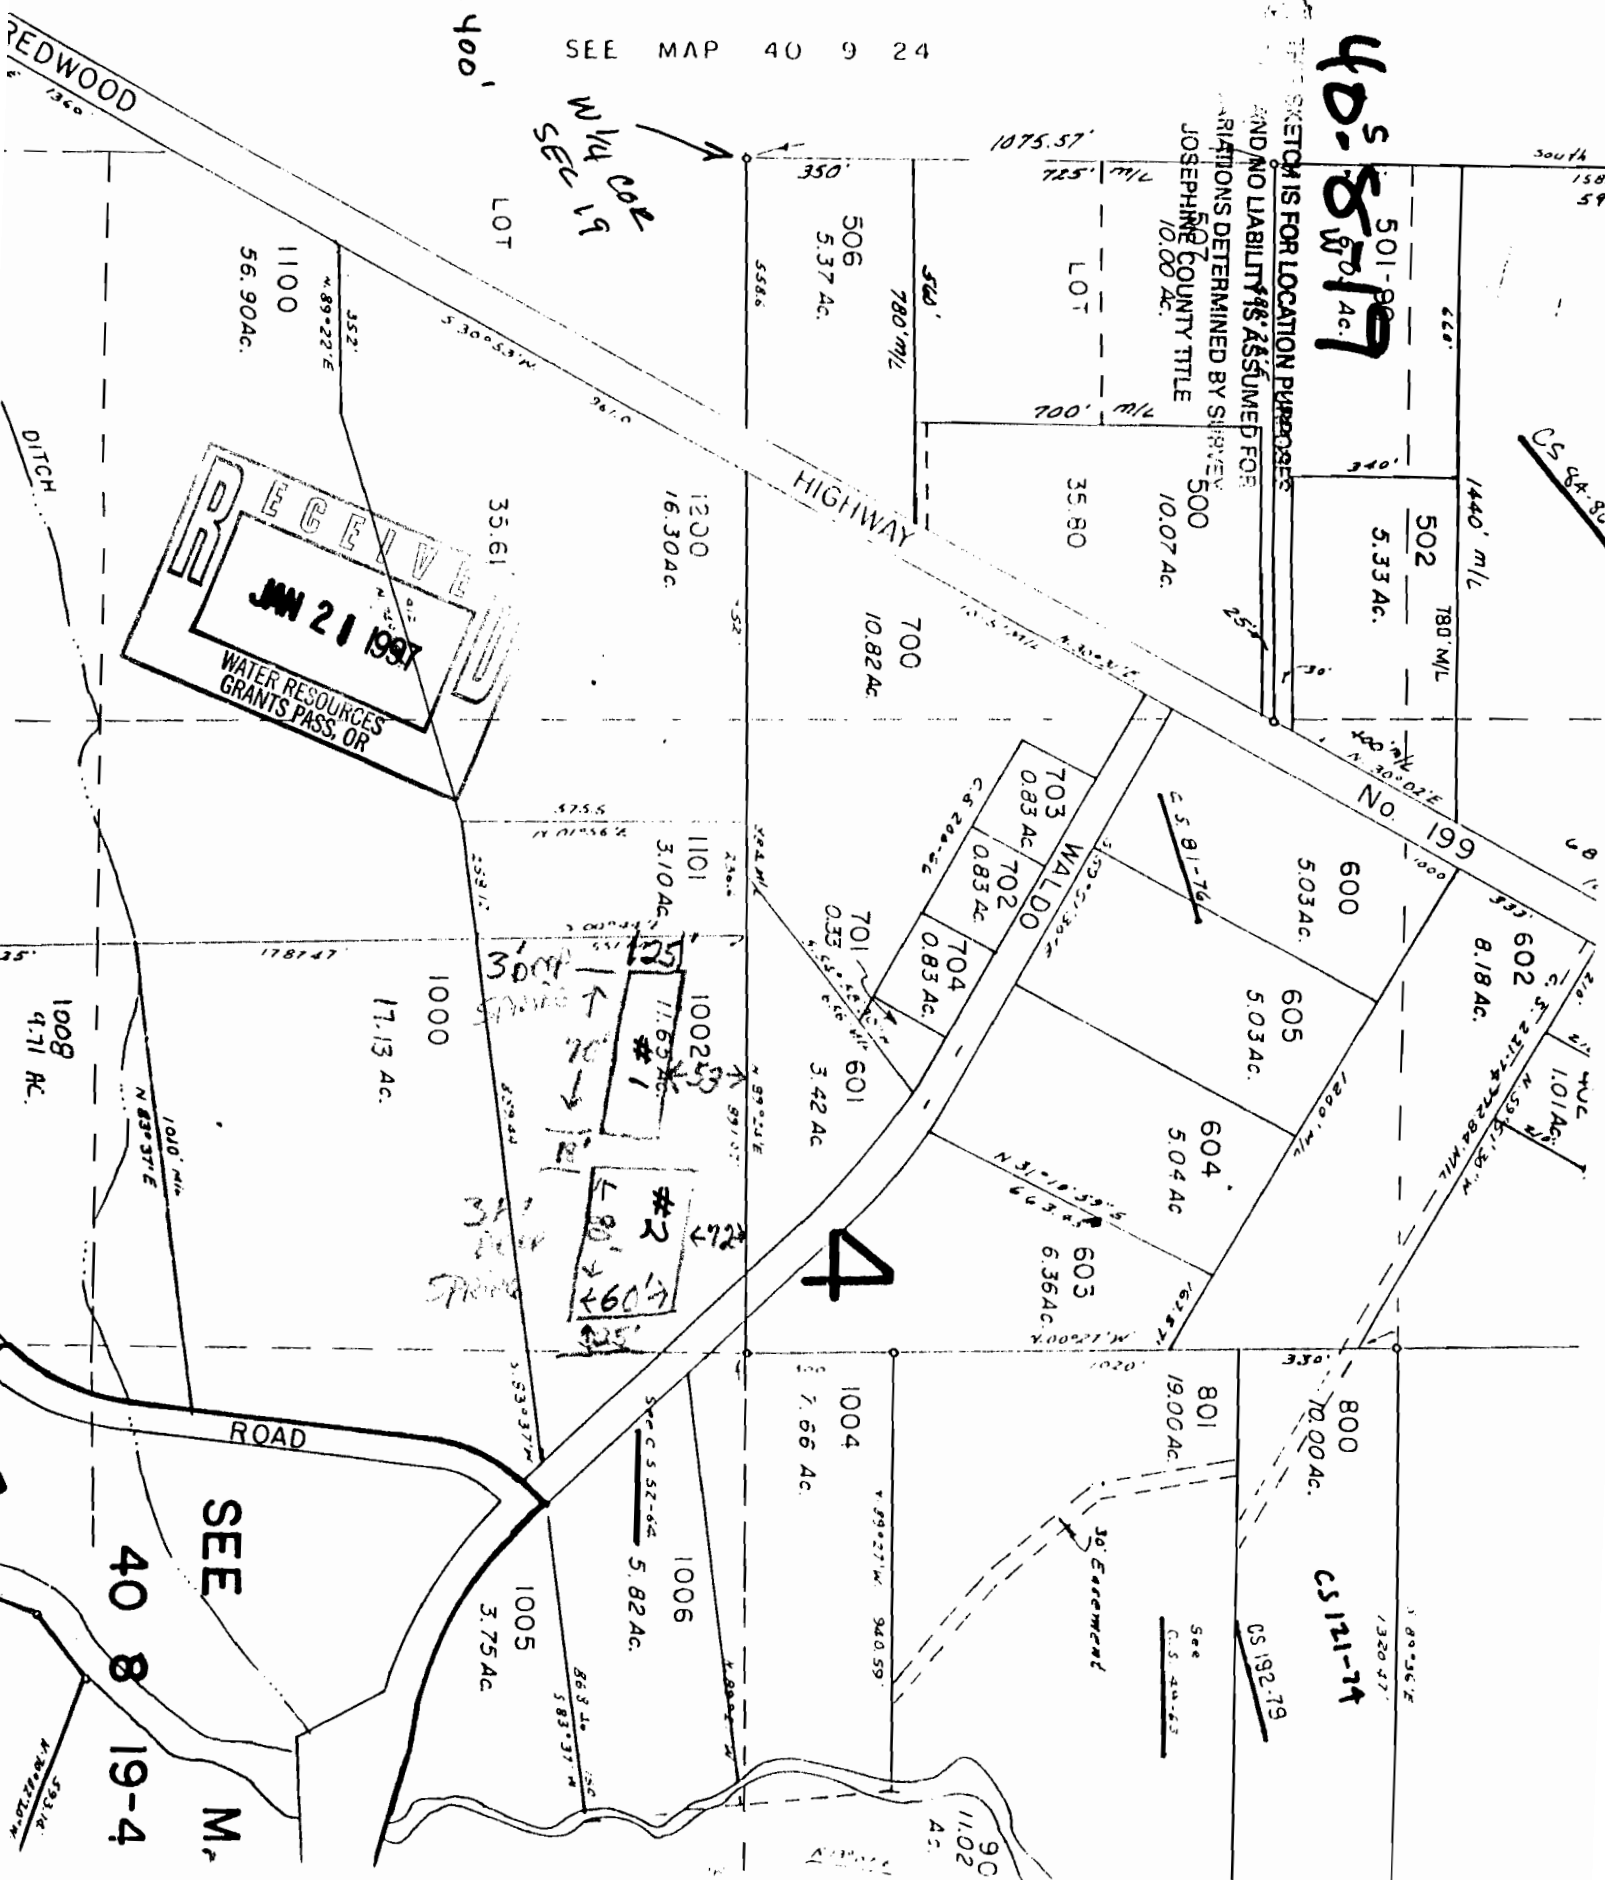

RECEIVED
JAN 21 1997
WATER RESOURCES
GRANTS PASS, OR

4

SEE
40 8 19-4
M.

CS 121-74

CS 192-79

See
CS 40-43

South
1582
596

CS 84-80

No. 199

602 8.18 AC
605 5.03 AC
604 5.04 AC
603 6.36 AC
601 3.42 AC
600 5.03 AC
30' Easement

See
CS 40-43

CS 192-79

CS 121-74