

Name Isaac T. Storm &
 By W. I. Anderson
 Address Box 863 Langlois, Oregon
Box 362, Bandon, Oregon.

Application No. 22601
 Permit No. 17826
 Certificate No. 2190
 Stream Index, Page No. 11-4B

Cancelled - sp. or Rec. Vol. 82 P. 145

FEES PAID

Date	Amount	Receipt No.
6/3/47	9.50	3060
7/22/47	0.50	3245
"	0.10d	"
10-8-56	\$1 Cert. Fee	8665
	B. P. Fee	"

Date filed June 3, 1947
 Priority June 3, 1947
 Action suspended until _____
 Returned to applicant _____
 Date of approval September 30, 1947

FEES REFUNDED

Date	Amount	Check No.
4/1/77	4.35	288
		FRIM 130

ASSIGNMENTS

Date	To Whom	Address	Volume	Page

CONSTRUCTION

Date for beginning September 30, 1948
 Date for completion October 1, 1949
 Extended to _____
 Date for application of water October 1, 1950
 Extended to _____

REMARKS

0.05 cfs from an unnamed stream (Graft Lake) for the irrigation of 4.00 acres of Cranberry's
OCT - 1 1948 CARD FOR A

PROSECUTION OF WORK

Form "A" filed October 11, 1948
 Form "B" filed October 11, 1948
 Form "C" filed October 11, 1948

FINAL PROOF

Blank mailed November 23, 1948
 Proof received _____
 Date certificate issued **DEC 21 1956**

Form C

IMPORTANT—This form is a notice to the State Engineer that permittee is ready to make final proof to the extent to which the water has actually been applied to the intended use under the terms of the permit. Permittee is cautioned that Certificate of Water Right will be issued based on the extent of the quantity and use as determined by the final proof inspection and survey which will be made in response to the filing of this Form C.

NOTE: In the case of an irrigation permit, this Form C should not be mailed to the State Engineer until all of the land described in the permit, which it is intended to irrigate under this permit at any time, has actually been irrigated. Fill out, detach, and mail to the State Engineer, Salem, Oregon, when all of the water has been applied.

Application No. 22601

NOTICE OF COMPLETE APPLICATION OF WATER TO A BENEFICIAL USE

I, Issac T. Storm, the holder of Permit No. 17826 to appropriate the public waters of the state of Oregon, completely applied the waters to a beneficial use in accordance with the terms of said permit, on the 15th day of June, 1948.

Remarks: Water is insufficient to irrigate the total acreage stipulated in my application. Therefore, I have decided to abandon the irrigation of 5/10 acres that I originally intended to develop and irrigate.

IN WITNESS WHEREOF, I have hereunto set my hand this 9th day of October, 1948.

Isaac T. Storm (Signature of Applicant)

P.O. Box 362, Bandon, Oregon (Address)

Form B

Application No. 22601

NOTICE OF COMPLETION OF CONSTRUCTION

I, Issac T. Storm, the holder of Permit No. 17826 to appropriate the public waters of the state of Oregon, completed the construction of the works described therein on the 30th day of September, 1947.

Remarks: Construction was completed according to plans submitted in my application. If the works have less capacity than described in the permit, or you have definitely abandoned part of the proposed development, you should so state in order that our records may not be unnecessarily encumbered.

IN WITNESS WHEREOF, I have hereunto set my hand this 9th day of October, 1948.

Isaac T. Storm (Signature of Applicant)

P.O. Box 362, Bandon, Oregon (Address)

Fill out, detach, and mail to the State Engineer, Salem, Oregon, when construction work is completed.

Form A

Application No. 22601

NOTICE OF BEGINNING OF CONSTRUCTION

I, Issac T. Storm, the holder of Permit No. 17826 to appropriate the public waters of the state of Oregon, began the actual construction of the works described therein on the 1st day of September, 1947.

Remarks: Work has been completed. The appropriator should state the manner of beginning construction work, number of men employed, the amount of work

up to the date of this statement, and any additional information which may tend to show the beginning of work in good faith.


IN WITNESS WHEREOF, I have hereunto set my hand this 9th day of October

Isaac T. Storm (Signature of Applicant)

P.O. Box 362, Bandon, Oregon (Address)

Fill out, detach, and mail to the State Engineer, Salem, Oregon, when construction work is begun.

T.30 S. R.15 W.W.M.

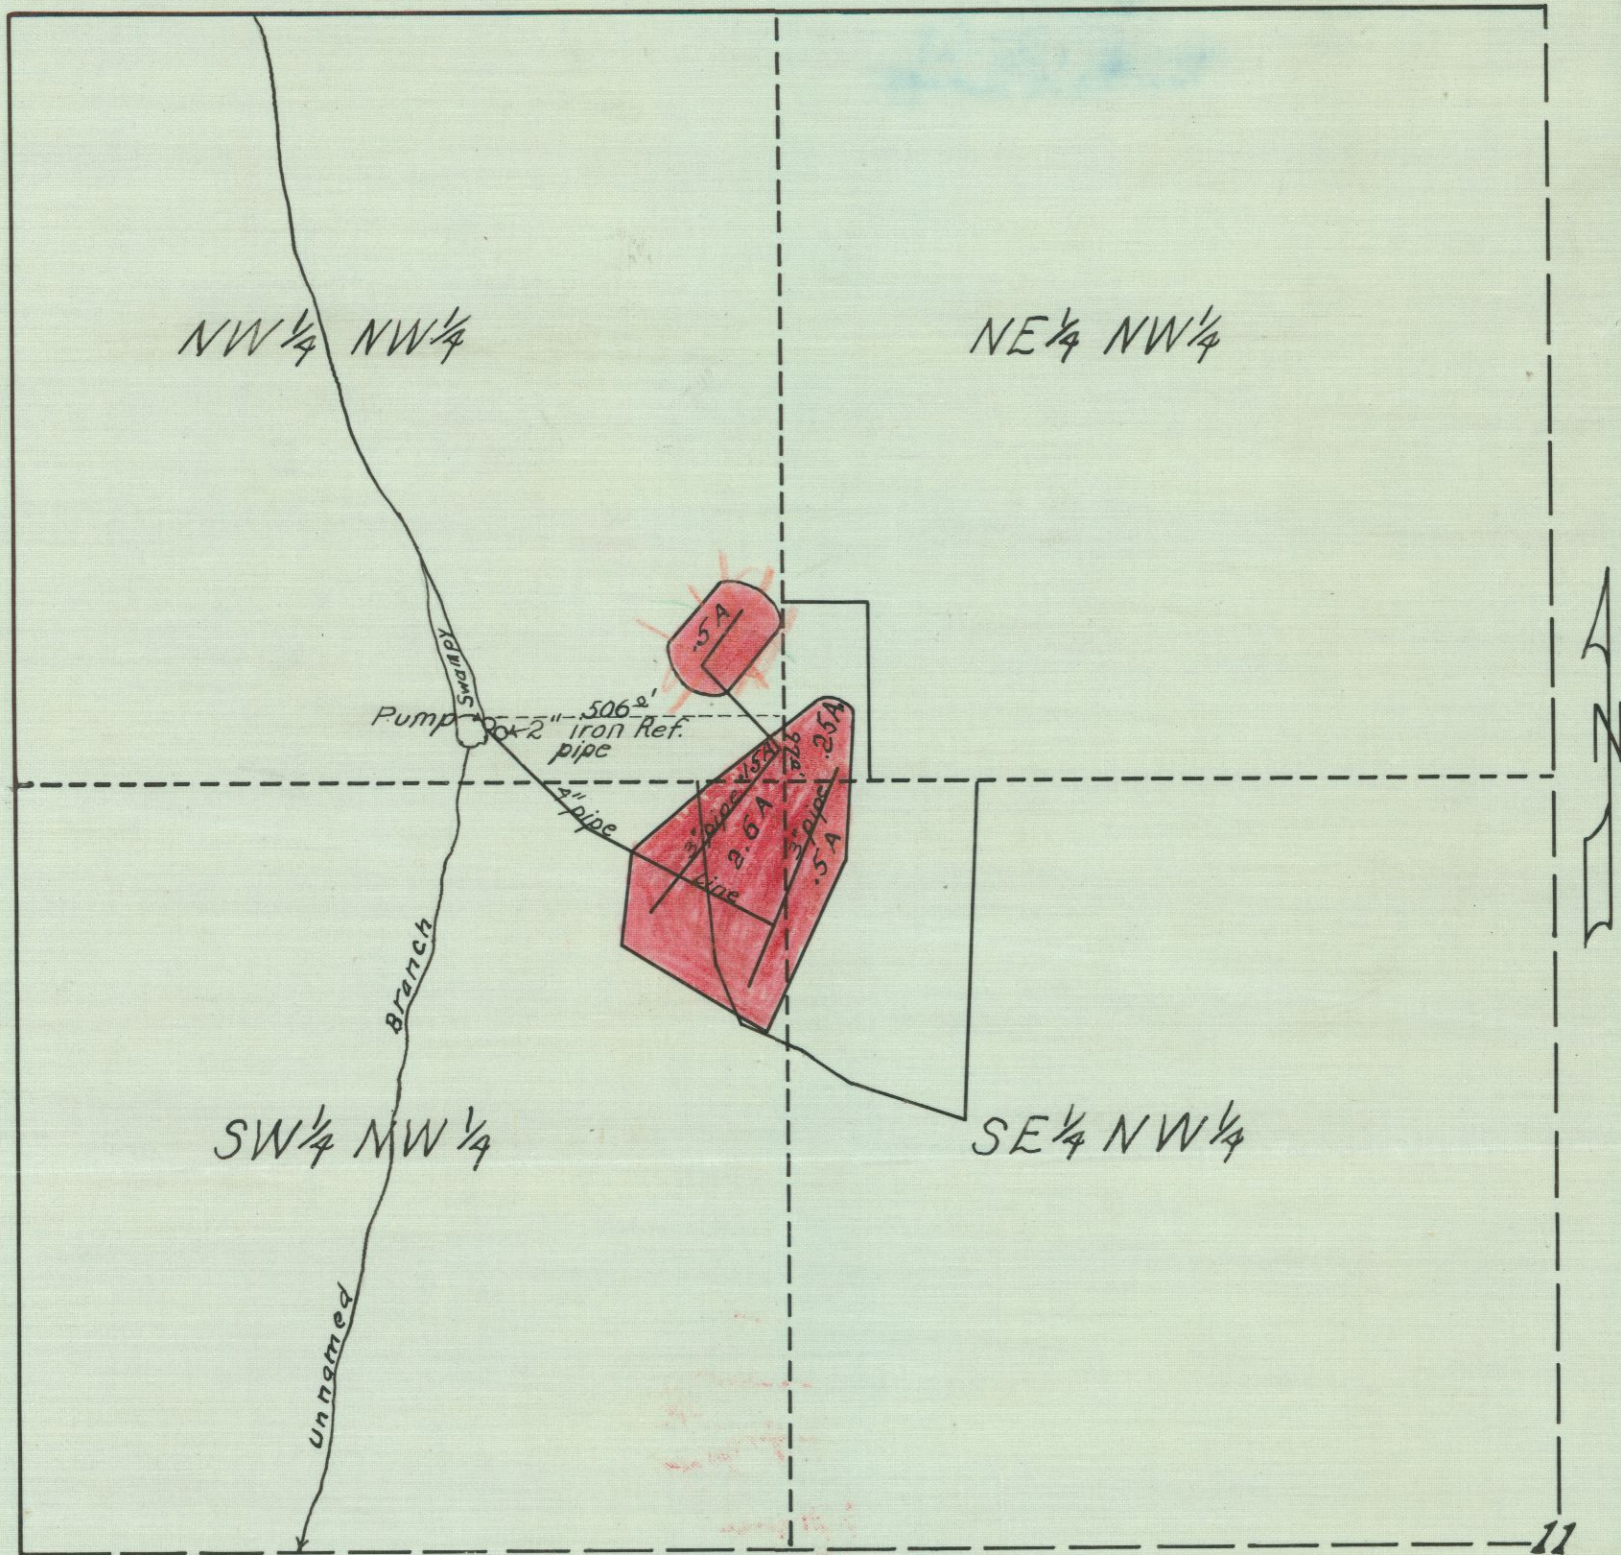

Scale 1 in. = 5 chs = 330 ft.

Map accompanying application of ISAAC T. STORM to appropriate water

I, J.N. Gearhart, of Myrtle Point, Oregon, do hereby certify that this map was made from notes taken during an actual survey made by me on August 7, 1947, and that it correctly represents the works described in the accompanying application together with the location of other streams and ditches in the immediate vicinity.

J.N. Gearhart
Oregon No. 183

RECEIVED
AUG 19 1947
STATE ENGINEER
SALEM, OREGON

22601
17826