



Oregon Water Resources Department
 725 Summer Street NE, Suite A
 Salem, Oregon 97301
 (503) 986-0900
 www.wrd.state.or.us

Request for Assignment

RECEIVED

JUL 30 2013

WATER RESOURCES DEPT
 SALEM, OREGON

If for multiple rights, a separate form and fee for each right will be required.

I, Joseph E. Bronec

(Name of Applicant / Permit / Transfer Holder / License Holder/GR Certificate of Registration)

27886 Barlow Road Canby OR 97013 503-651-2851
 (Mailing Address) (City) (State) (Zip) (Phone #)

- hereby assign all my interest in and to application/permit/transfer/license/GR Certificate of Registration;
- hereby assign all my interest in and to a portion of application/permit/transfer/license/GR Certificate of Registration; (You must include a map showing the portion of the application/permit/transfer/license/GR Certificate of Registration to be assigned.)
- hereby assign a portion of my interest in and to the entire application/permit/transfer/license/GR Certificate of Registration:

Application # G-11781 ; Permit # G-10882 ; Transfer #
 -OR-
 License # : GR Statement # : GR Certificate of Registration #

As filed in the office of the Water Resources Director, to:

West Coast Trust, Trustee; Frank J. Bronec Trust, UTD 09/12/05
 (Name of New Owner)

P.O. Box 1012 Salem OR 97308 503-399-2907
 (Mailing Address) (City) (State) (Zip) (Phone #)

Note: If there are other owners of the property described in the Application, Permit, Transfer, License, or GR Certificate of Registration, you must provide a list of all other owners' names and mailing addresses and attach it to this form.

I hereby certify that I have notified all other owners of the property described in this Application, Permit, Transfer, License, or GR Certificate of Registration of this Request for Assignment

Witness my hand this 19 day of July, 2013.

Applicant/Permit Holder

Applicant/Permit Holder

Joseph E Bronec

ASSIGNMENT RECEIVED 7/31/2013

DO NOT WRITE IN THIS BOX

This certifies assignment and record change at Oregon Water Resources Department effective 8:00 a.m. on date of receipt at Salem, Oregon. Fee receipt # See below For Director by Jerry Sauter, Program Analyst in Water Rights Division *[Signature]*


The completed "Request for Assignment" form *must* be submitted to the Department along with the recording fee of \$75.

T.5S., R.1W., W.M


RECEIVED

JUL 30 2013

WATER RESOURCES DEPT
SALEM, OREGON

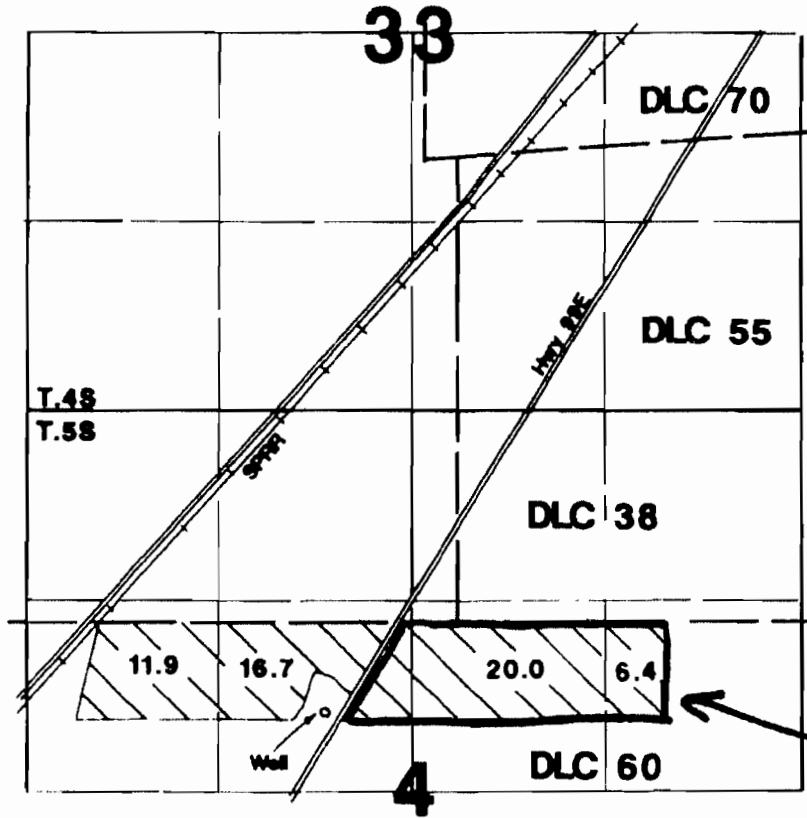

Well located 890'W & 595'S from SW corner DLC 38.

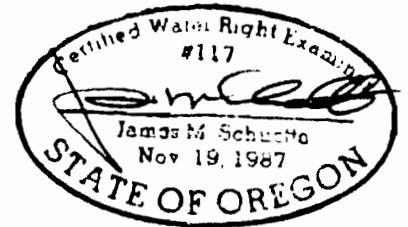

Final Proof Survey

Application #: G-11781 Permit #: G-10882

In Name Of

Joe E. Bronec

Surveyed on September 10, 1993 by JM Schuette

THIS MAP WAS PREPARED FOR THE PURPOSE OF IDENTIFYING THE LOCATION OF A WATER RIGHT ONLY AND IS NOT INTENDED TO PROVIDE LEGAL DIMENSIONS OR LOCATION OF PROPERTY OWNERSHIP LINES.