
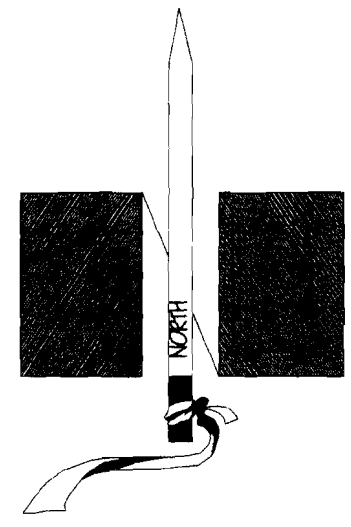
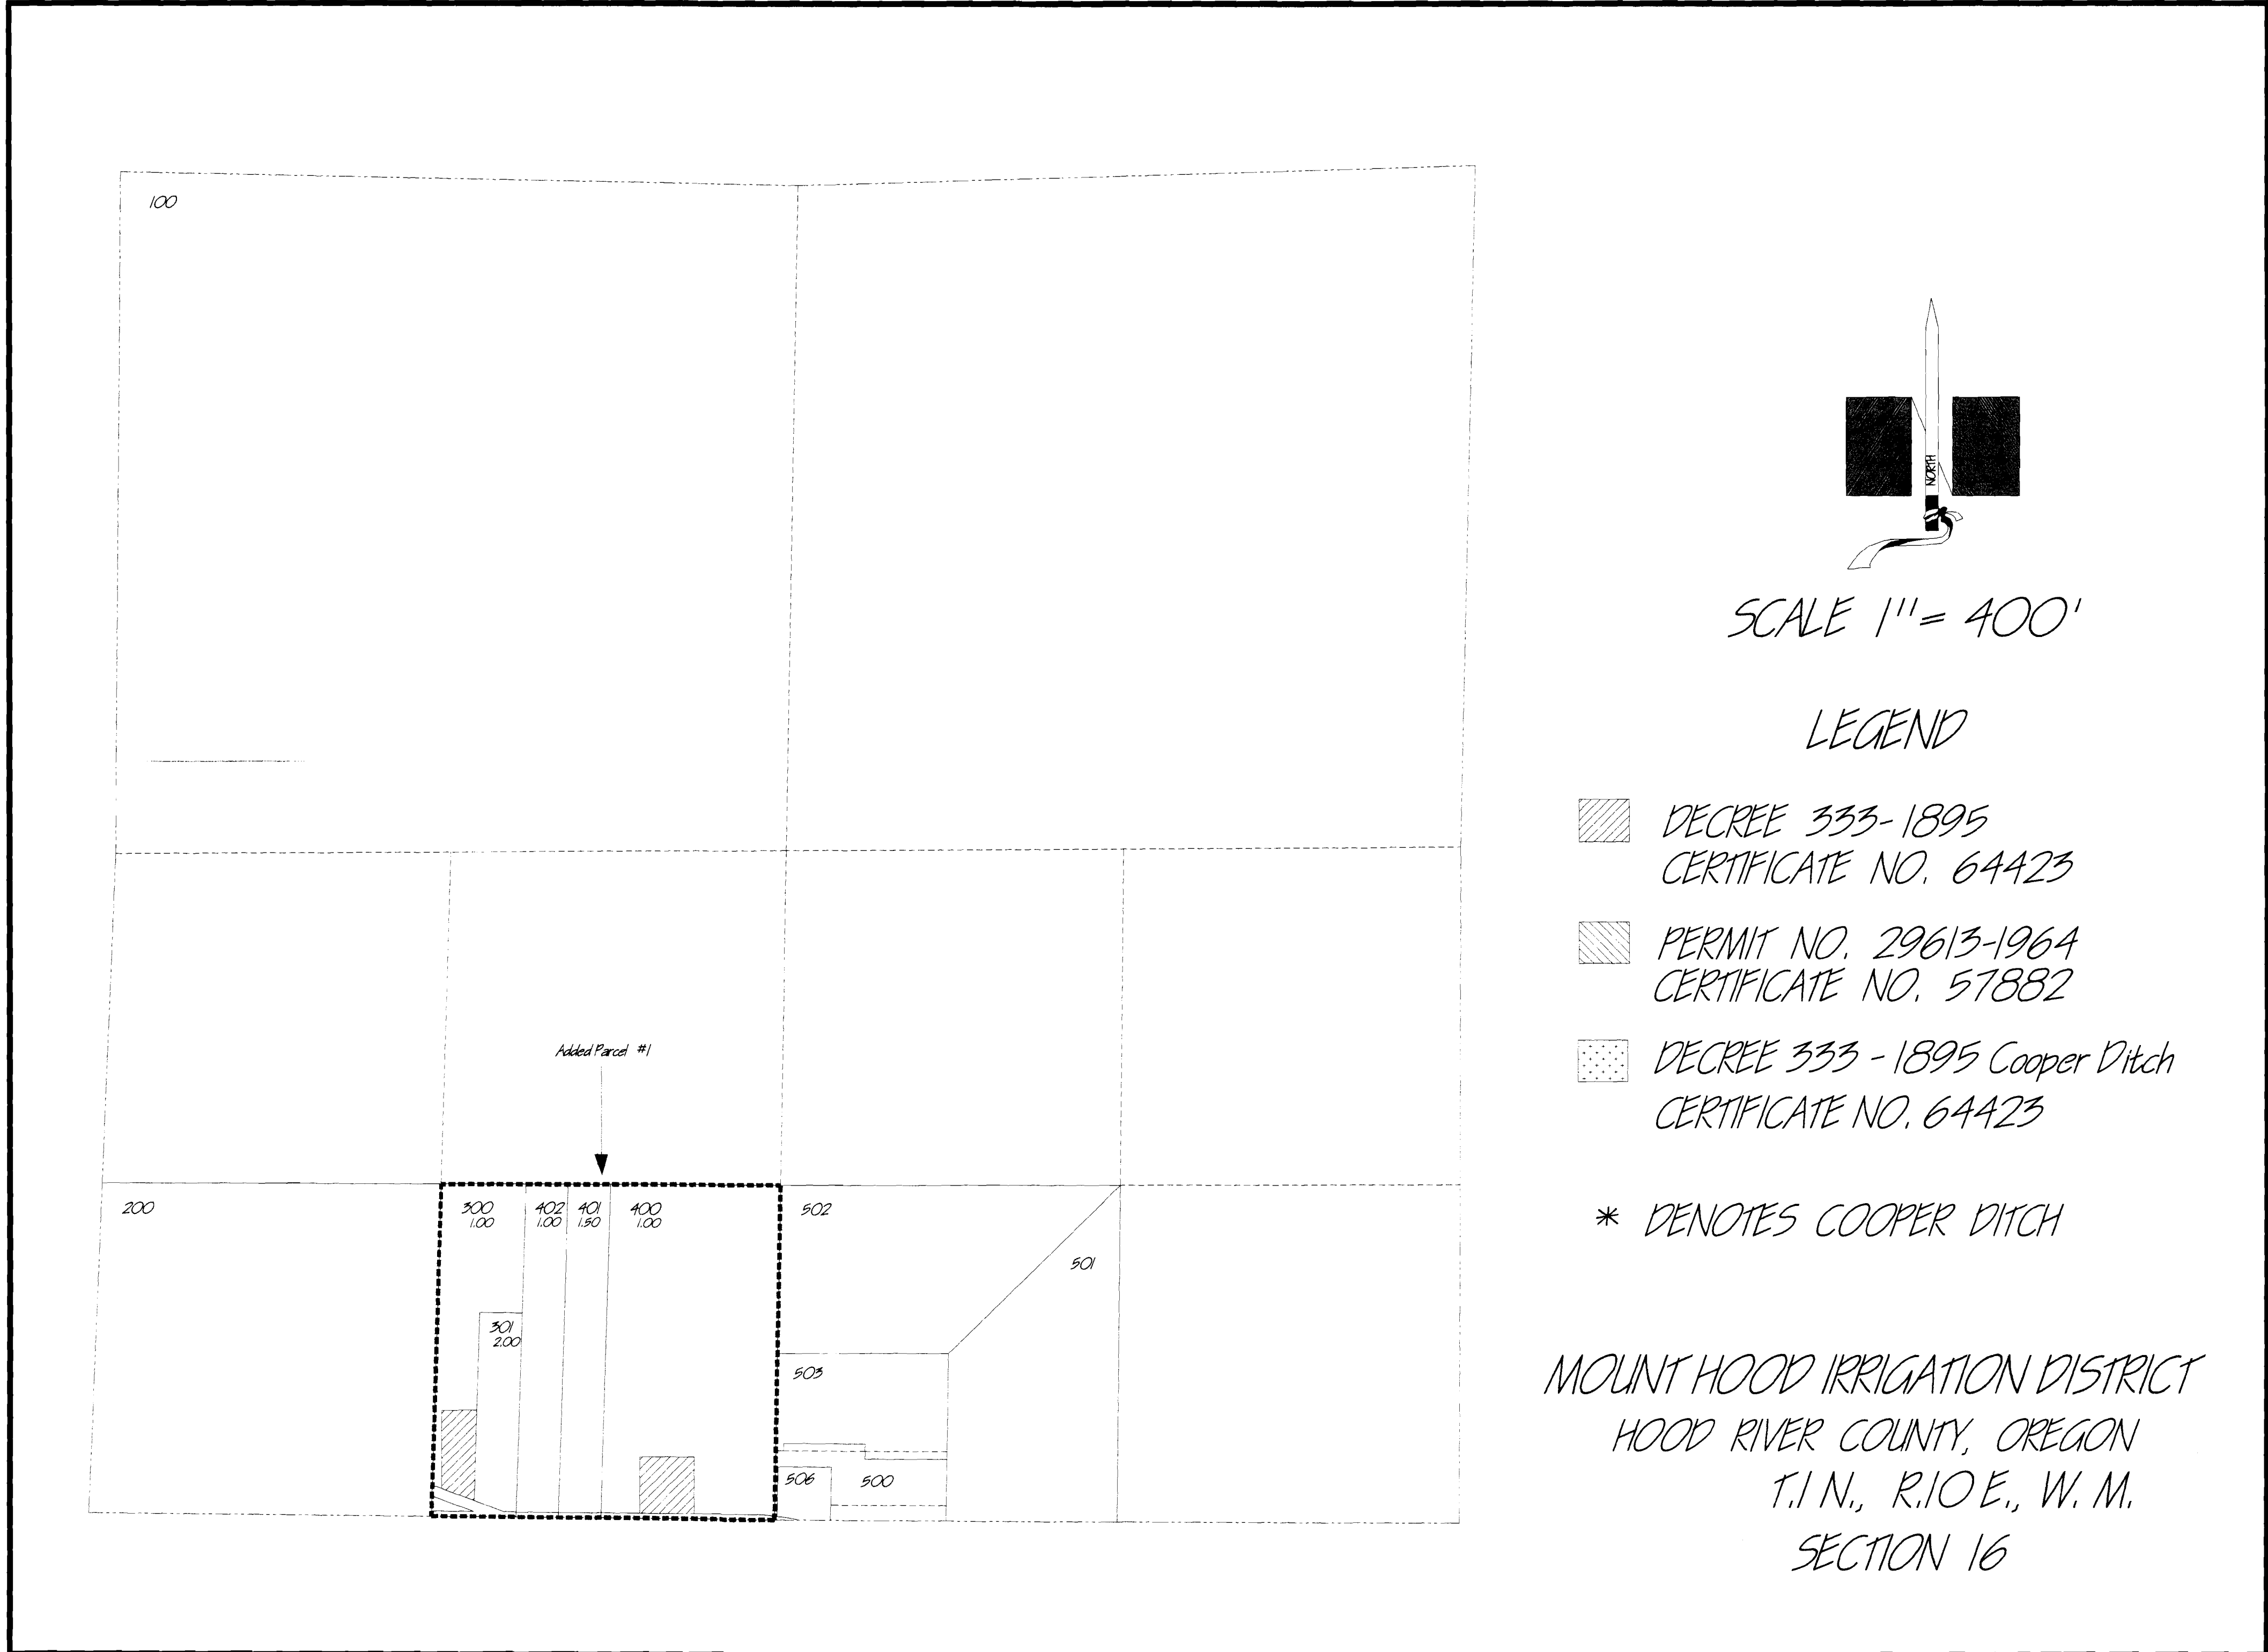
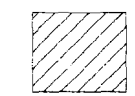
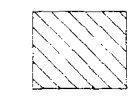


4-8-44

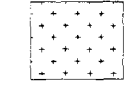

SCALE 1" = 400'

LEGEND

-  DECREE 333-1895
CERTIFICATE NO. 64423
-  PERMIT NO. 29613-1964
CERTIFICATE NO. 57882
-  DECREE 333 - 1895 Cooper Ditch
CERTIFICATE NO. 64423

* DENOTES COOPER DITCH

MOUNT HOOD IRRIGATION DISTRICT
 HOOD RIVER COUNTY, OREGON
 T.1 N., R.10 E., W. M.
 SECTION 16