


BOUNDARY SURVEY  
FOR  
**ERWIN NYQUIST AND BARBARA NYQUIST**  
**JOINT REVOCABLE LIVING TRUST**  
IN THE NW & SW 1/4 OF SECTION 19, T. 4 S., R. 1 W., W.M.  
MARION COUNTY, OREGON  
DECEMBER 13, 2012

SE NW  
LEGEND

- = Found Monument as noted, flush with ground surface and in good condition unless otherwise noted
- = Set 5/8"X30" Iron Rod with Yellow Plastic Cap Marked "AZIMUTH SURVEYING"
- ( ) = Data of Record
- [ ] = Data Computed from one or more Record Sources, or scaled from plat
- [ ] = Surveyor, File Number for survey in which monument probably originated
- I.P. = Iron Pipe
- I.R. = Iron Rod
- I.B. = Iron Bar
- x - x - = Fence

SCALE: 1" = 100'

**RECEIVED**  
SEP 05 2013  
WATER RESOURCES DEPT  
SALEM, OREGON

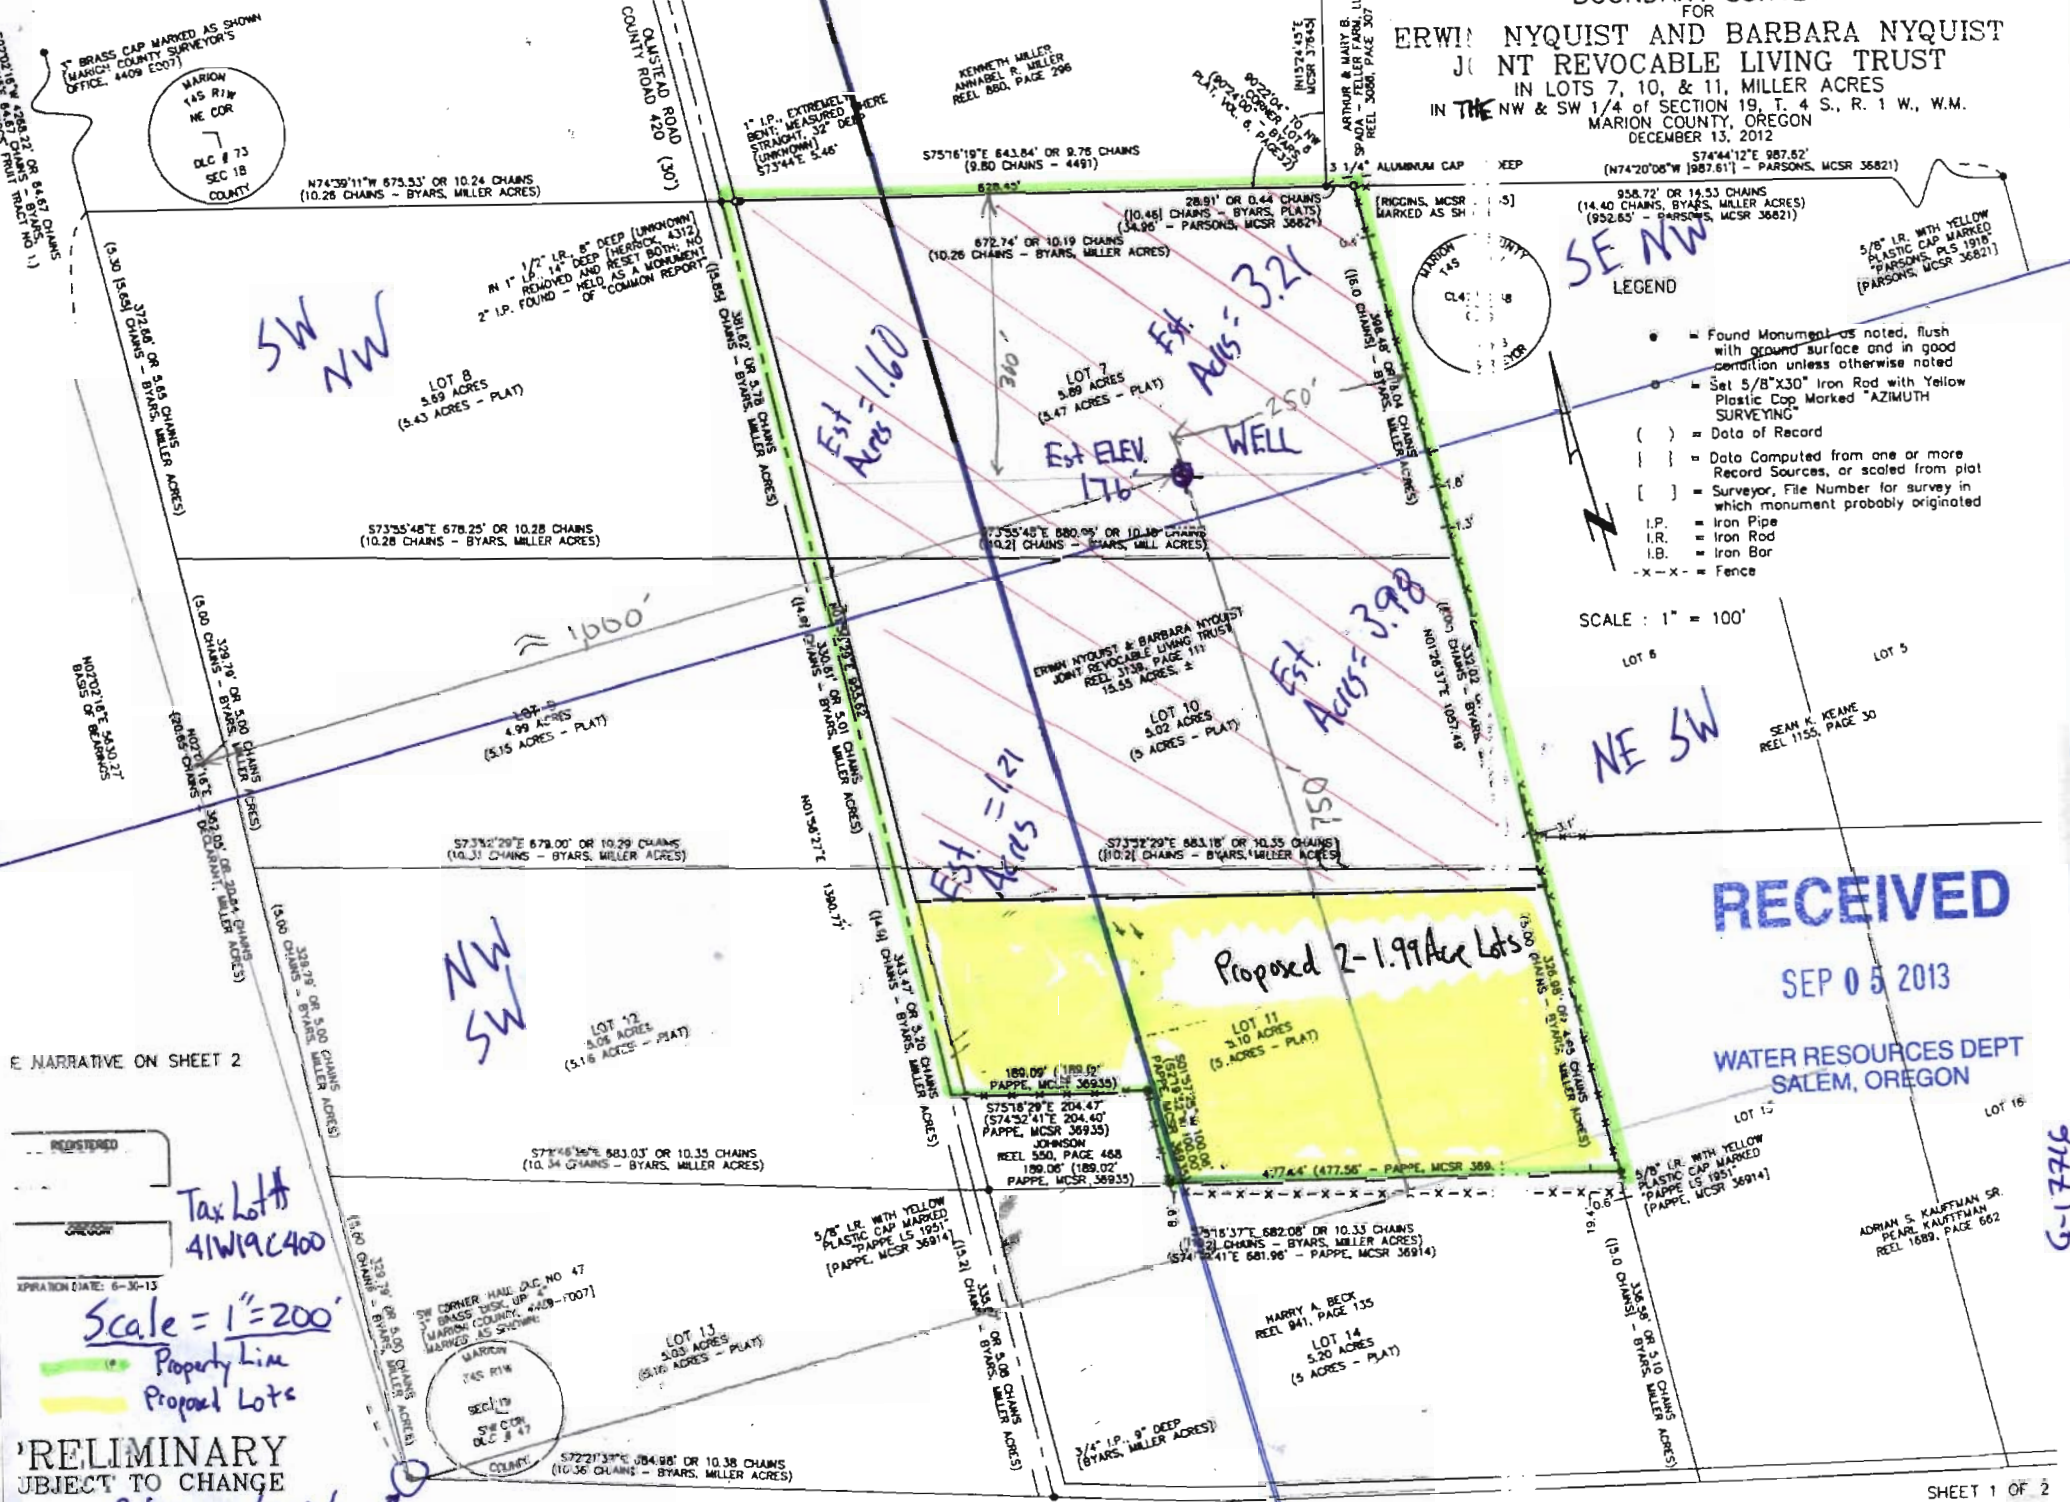

E NARRATIVE ON SHEET 2

REGISTERED  
OREGON  
EXPIRATION DATE: 6-30-13

Scale = 1" = 200'

Property Line  
Proposed Lots

PRELIMINARY  
SUBJECT TO CHANGE

Reference Corner

G-17716

1

LEGEND

LINE TYPES

- TAX LOT BOUNDARY OLD PROPERTY LINE
- ROAD RIGHT-OF-WAY VACATED RIGHT-OF-WAY
- RAILROAD RAILROAD RIGHT-OF-WAY
- STREAM, LAKE, ETC. TAX LOT BOUNDARY STREAM, LAKE, ETC. NON-BOUNDARY
- SUBDIVISION BOUNDARY PARTITION PLAT BOUNDARY
- TAX CODE BOUNDARY EASEMENT

SYMBOL TYPES

- BLK.
- CONTROL POINTS
- SURVEY MONUMENTS
- CLA. CORNER
- SECTION 1/4 SEC. 1/8 SEC.

NUMBERS

TAX CODE NO. 000 00 00 0

ACRES - ALL ACRES INCLUDE ANY PORTION THAT MAY LIE WITHIN THE INDICATED PUBLIC RIGHT OF WAY.

TICK MARKS - WHEN A TICK MARK IS INDICATED ON THE EXTENSION OF A LINE, THEN THE DIMENSION CODE TO THE TICK MARK, GENERALLY THIS IS USED WHEN DIMENSIONS GO INTO PUBLIC RIGHT OF WAY.


ARROWS ARE USED WITH DIMENSIONS IN AREAS OF GREATER COMPLEXITY

NOTICE: This map was created for Assessor's Office use ONLY.



SCALE 1" = 400'

Plot file created: August 5, 2005

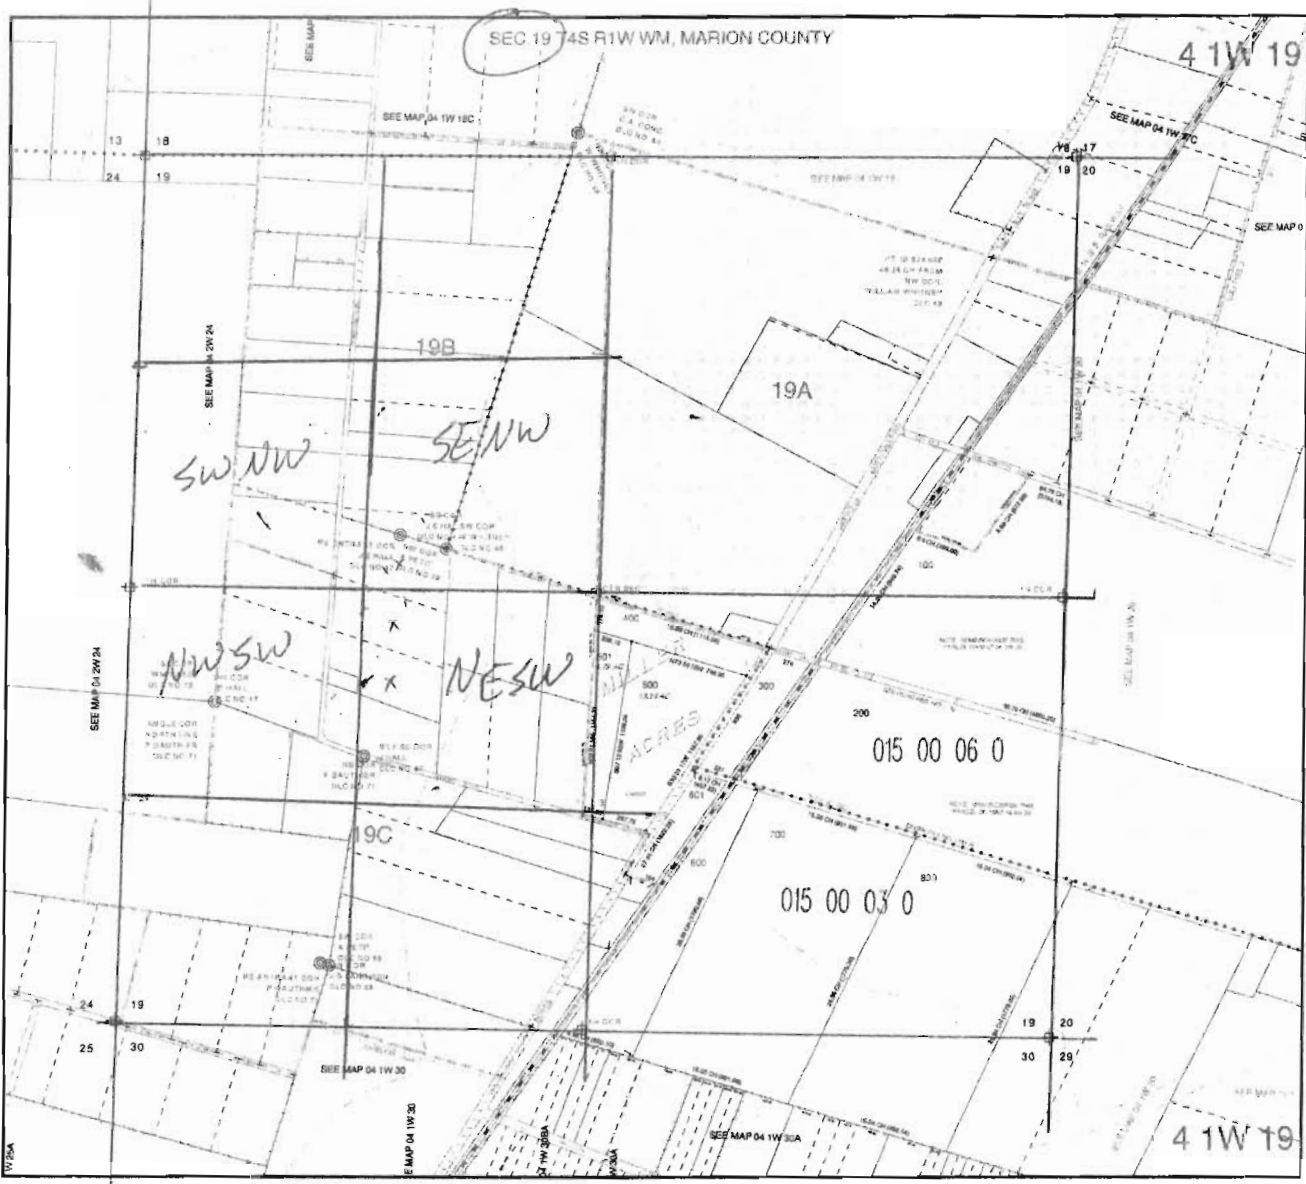

h-v

h

RECEIVED

SEP 05 2013

WATER RESOURCES DEPT SALEM, OREGON

G-17716



**LEGEND**

**LINE TYPES**

TAX LOT BOUNDARY OLD PROPERTY LINE

ROAD RIGHT-OF-WAY VACATED RIGHT-OF-WAY

RAILROAD RAILROAD RIGHT-OF-WAY

STREAM, LAKE, ETC. STREAM, LAKE, ETC. TAX LOT BOUNDARY NON-BOUNDARY

SUBDIVISION BOUNDARY PARTITION PLAT BOUNDARY

TAX CODE BOUNDARY EASEMENT

**SYMBOL TYPES**

DL-2

CONTROL POINTS

RESURVEY MONUMENTS

GRID CORNERS

BESTFIT 1/4 SEC 1/4 SEC 1/4 SEC

**NUMBERS**

TAX CODE NO

000 00 00 0

NOTICE - ALL AREAS, INCLUDING ANY PORTION THAT MAY BE WITHIN THE INDICATED PUBLIC RIGHT-OF-WAY

THE MARKS WITH A TICK MARK AS INDICATED ON THE EXTENSION OF A LINE, SHOW THE DIMENSION CODE TO THE END MARK, GENERALLY THIS IS USED WHEN DIMENSIONS GO INTO PUBLIC RIGHT-OF-WAYS


ARROWS ARE USED WITH DIMENSIONS IN AREAS OF UNLATER CERTAINTY.

**NOTICE:** This map was created for Assessor's Office use ONLY.



SCALE 1" = 200'

Plot file created: January 11, 2007

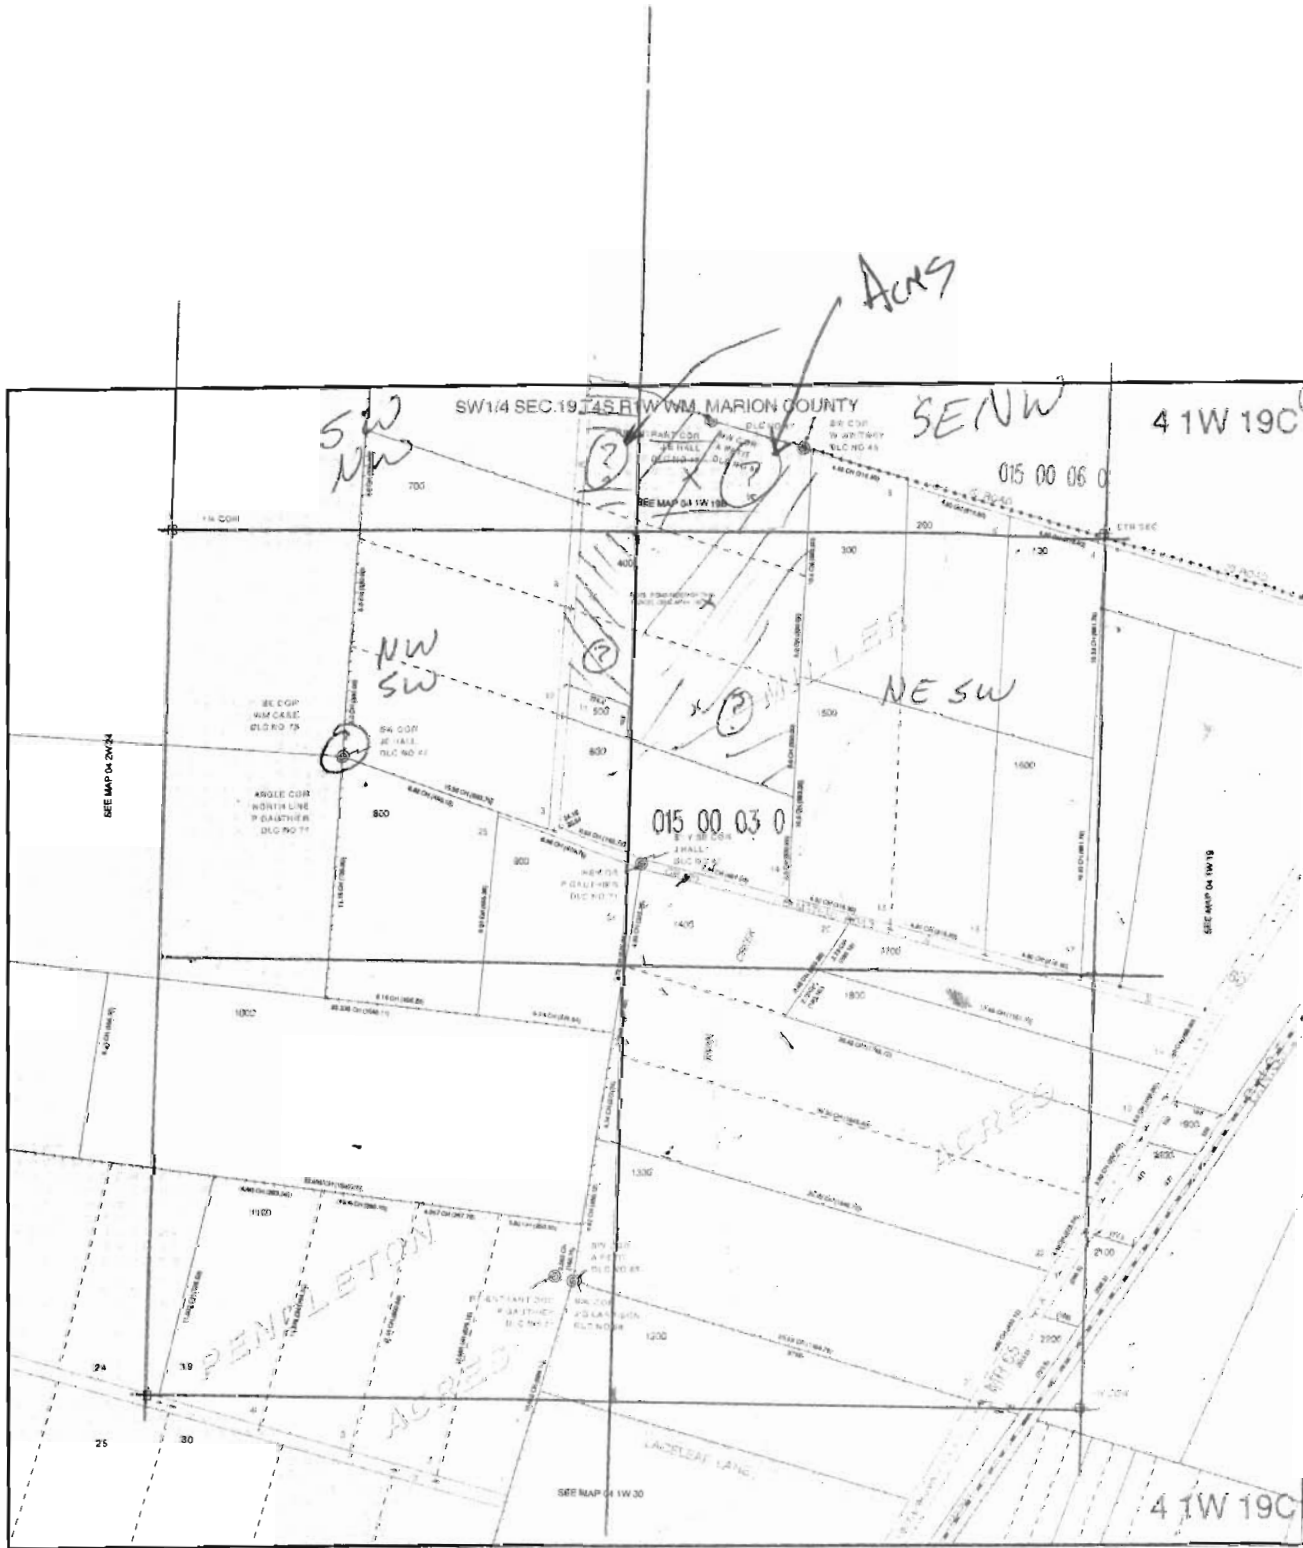

**RECEIVED**

SEP 05 2013

WATER RESOURCES DEPT  
SALEM, OREGON

G-7716