

T 4N R 32E WM
UMATILLA COUNTY

NE 1/4 NE 1/4 of Section 16

Tax lot #1900

WATER RIGHT APPLICATION

DALE PETERS

MARCH 8, 2013

PH 541-276-2234




SCALE

1" = 400'

1" = 800'

9/10/2013

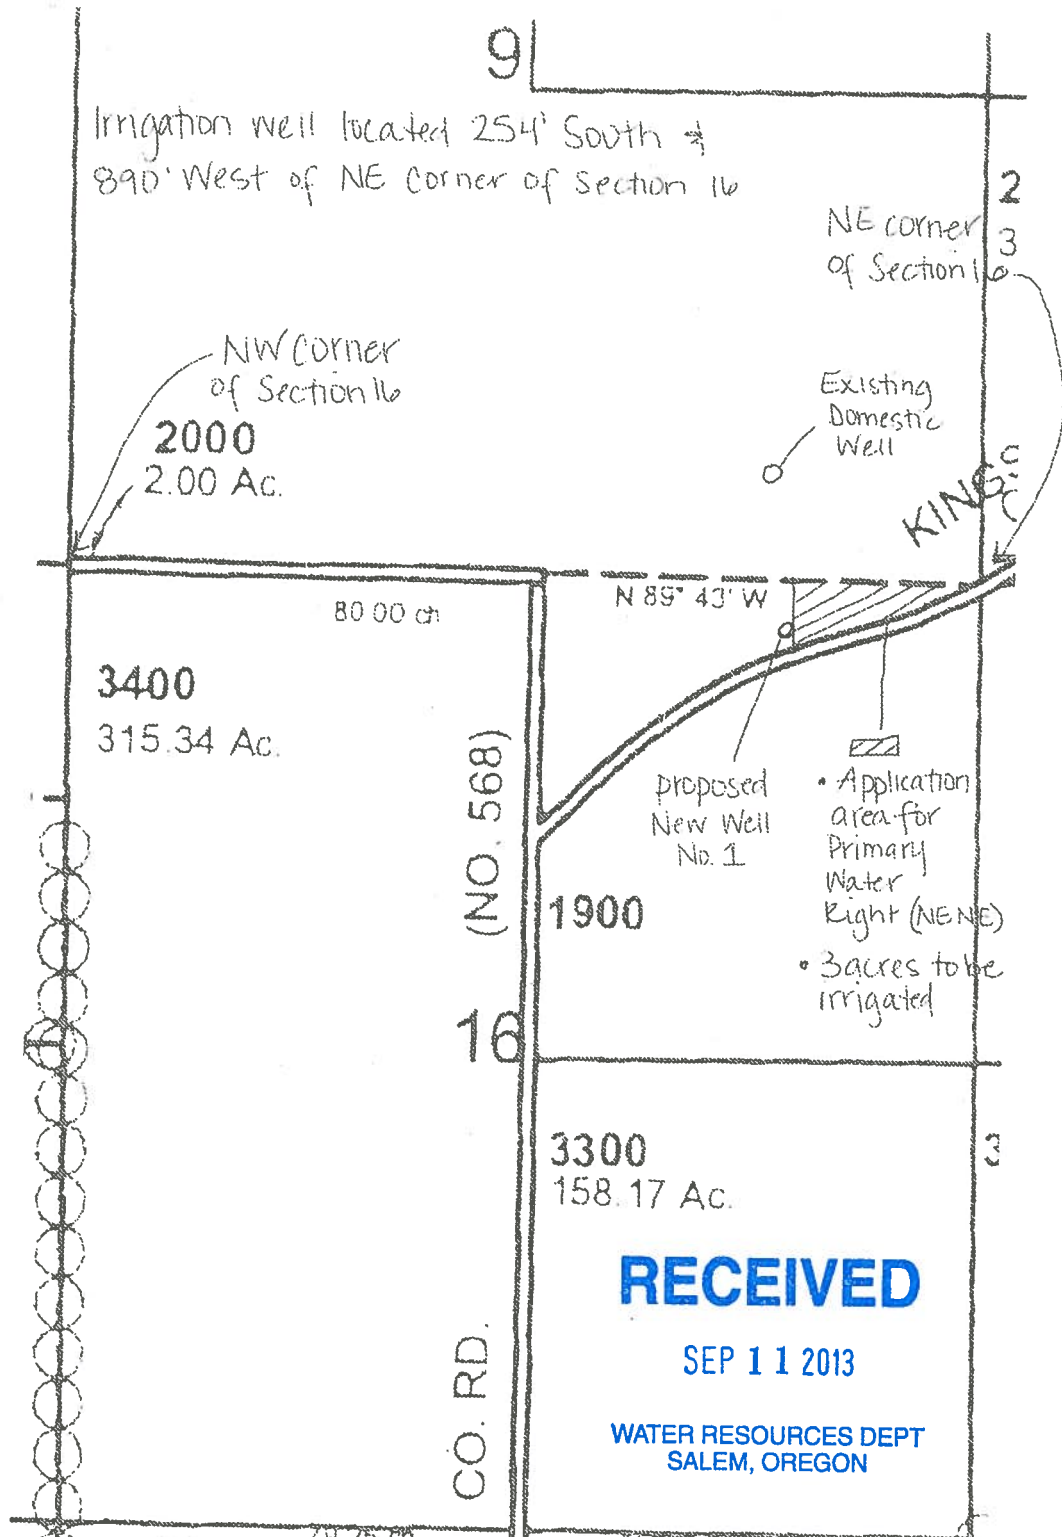

App 9-17636

RECEIVED

SEP 11 2013

WATER RESOURCES DEPT
SALEM, OREGON