



# Map to Accompany New Groundwater Application for Gary Pointer

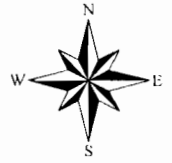

Scale: 1" = 1320'

**T. 7S, R. 38E WM**

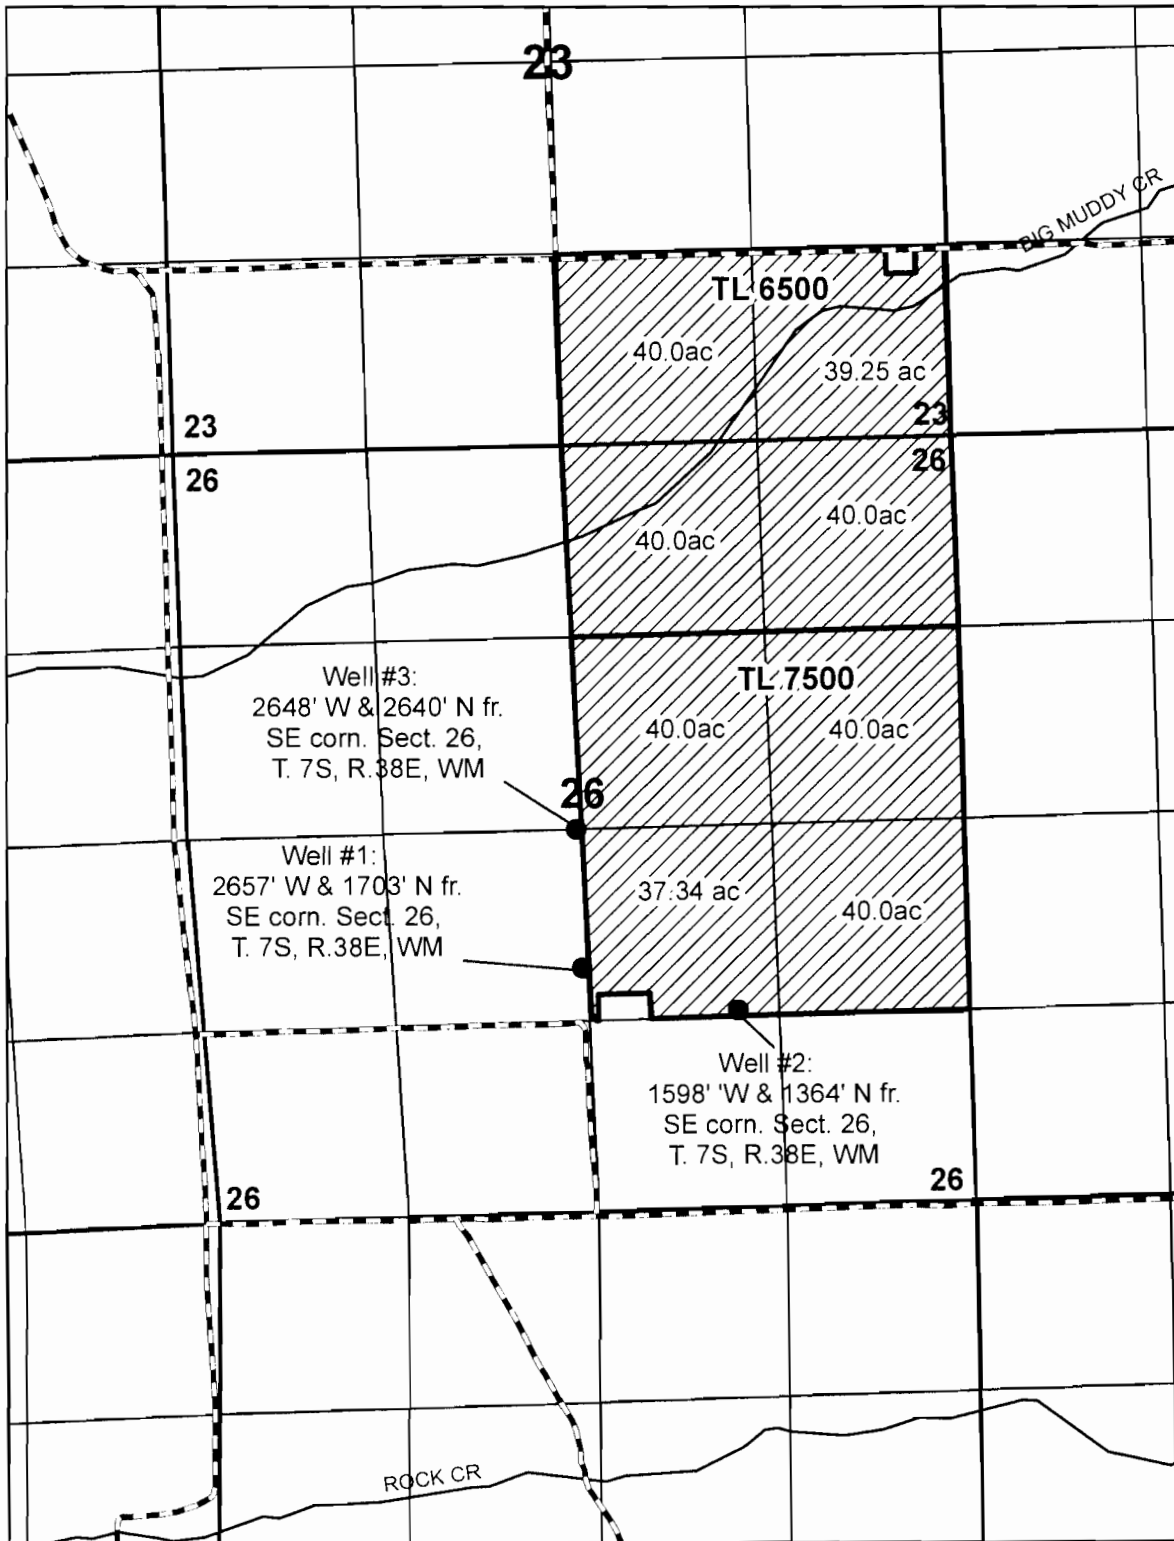

Supplemental Irrigation

Well Location

RECEIVED BY OWRD

SEP 18 2013

SALEM, OR