


N 1

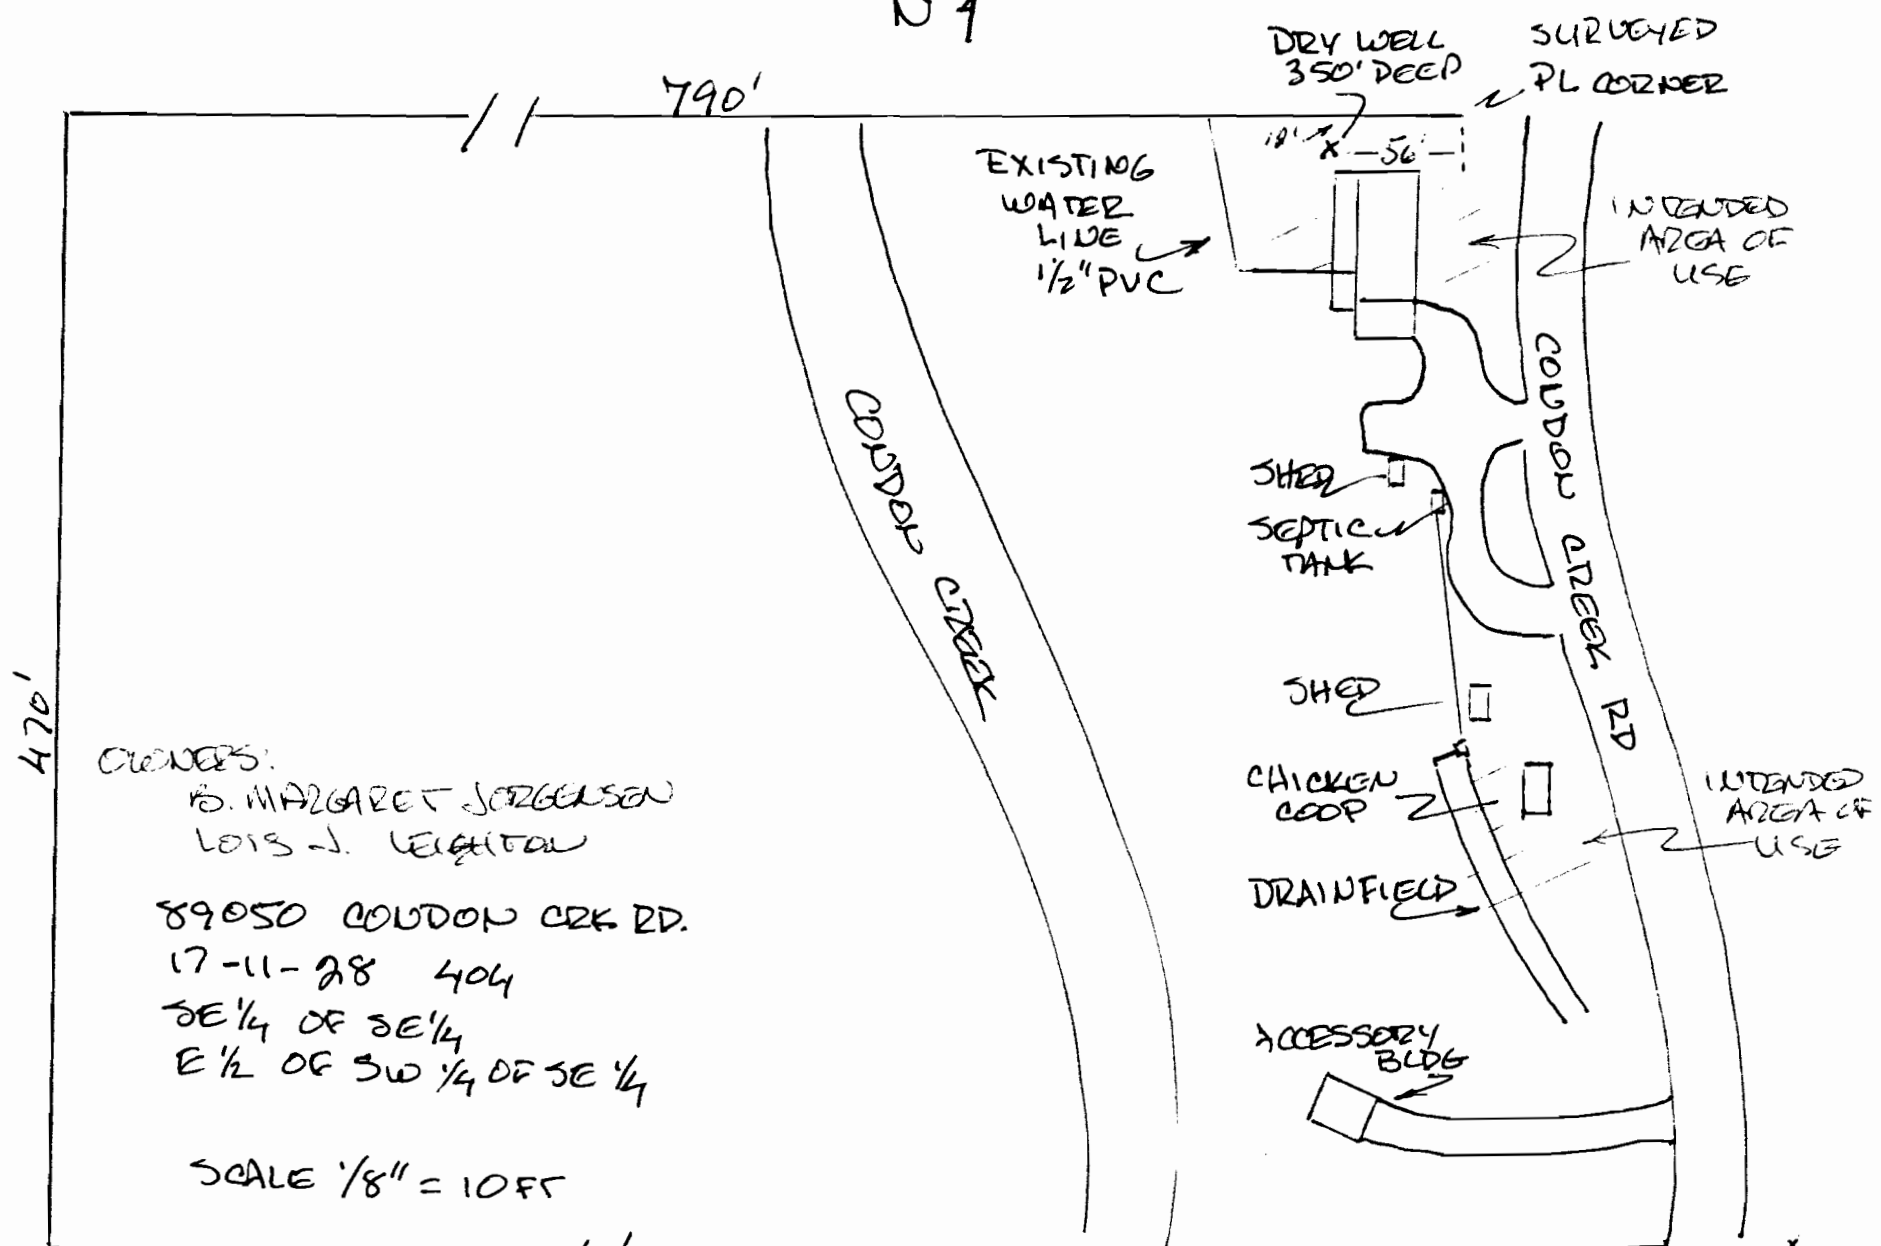

OWNERS:
B. MARGARET JORGENSEN
LOIS J. LEIGHTON
89050 COUDON CRK RD.
17-11-28 404
SE 1/4 OF SE 1/4
E 1/2 OF SW 1/4 OF SE 1/4

SCALE 1/8" = 10 FT

RECEIVED

SEP 19 1977


SALEM, OR

WELL IS LOCATED
± 475 FT N OF ±
± 186' W, OF MARKER

YELLOW METAL
SURVEY MARKER

587934

 541-997-3824
 17-11-28-400

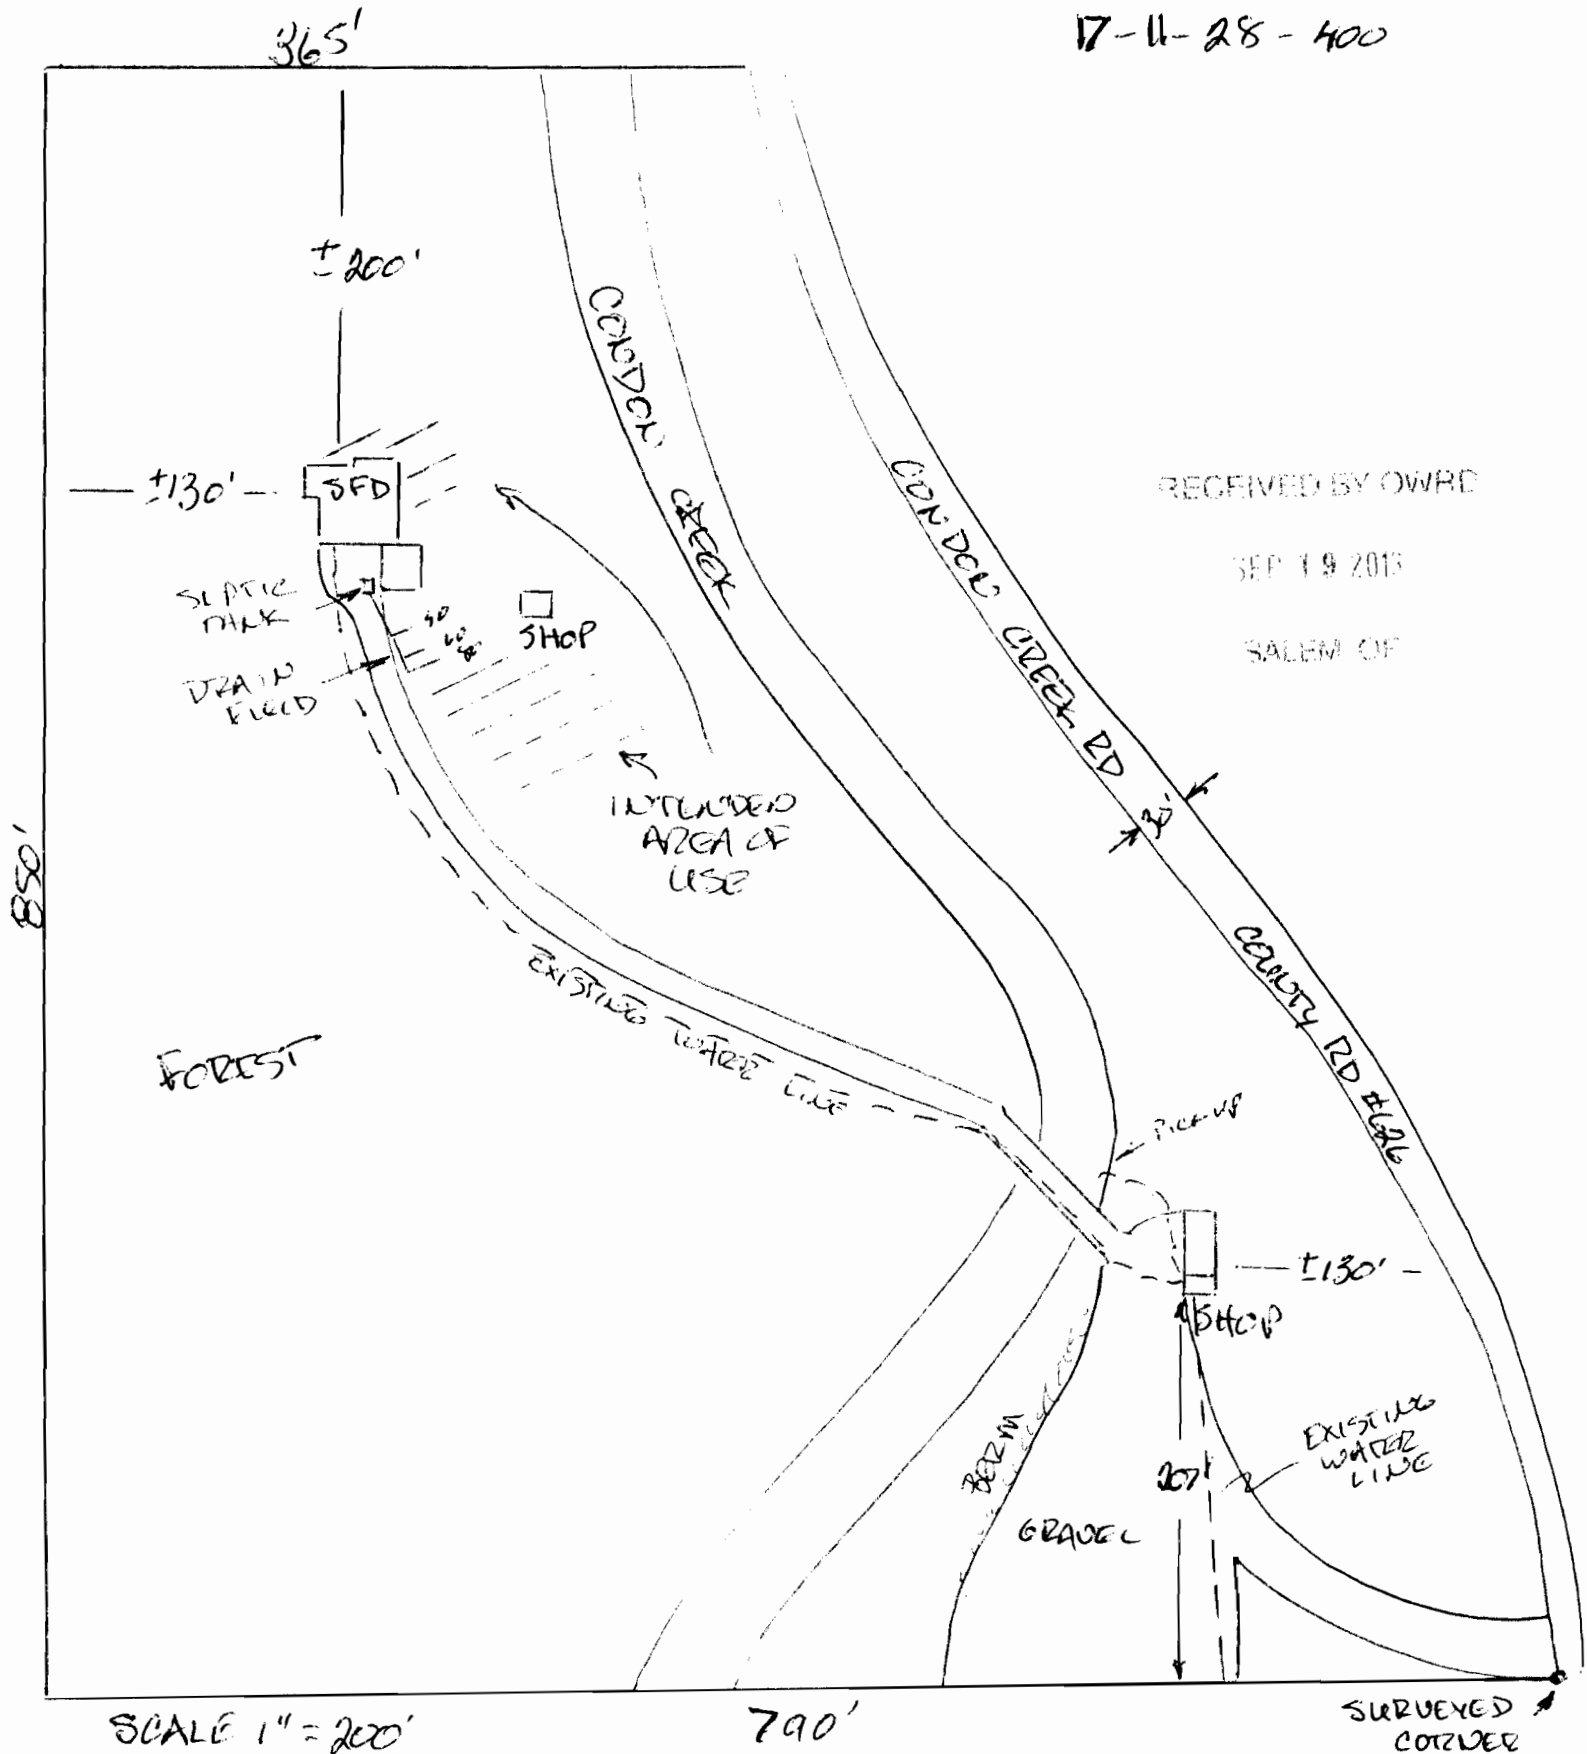

RECEIVED BY OWRD

SEP 19 2013


SALEM OF

OWNERS: B. MARGARET JORGENSEN
 LOIS J. KEIGHTON
 89050 CONDON CREEK RD.
 FLORENCE, OR 97439
 541-997-6964
 17-11-28-404

CLOWERS: BYRON & SUSAN DEWITT
 89060 CONDON CREEK RD.
 FLORENCE, OR 97439
 541-997-3824
 17-11-28-400

POD is 710 ft N
 and 1080 ft E
 from S $\frac{1}{4}$ cor. Sec 28

WELL IS 450 FT N
 AND 1280 FT E
 FROM S $\frac{1}{4}$ COR SEC 28

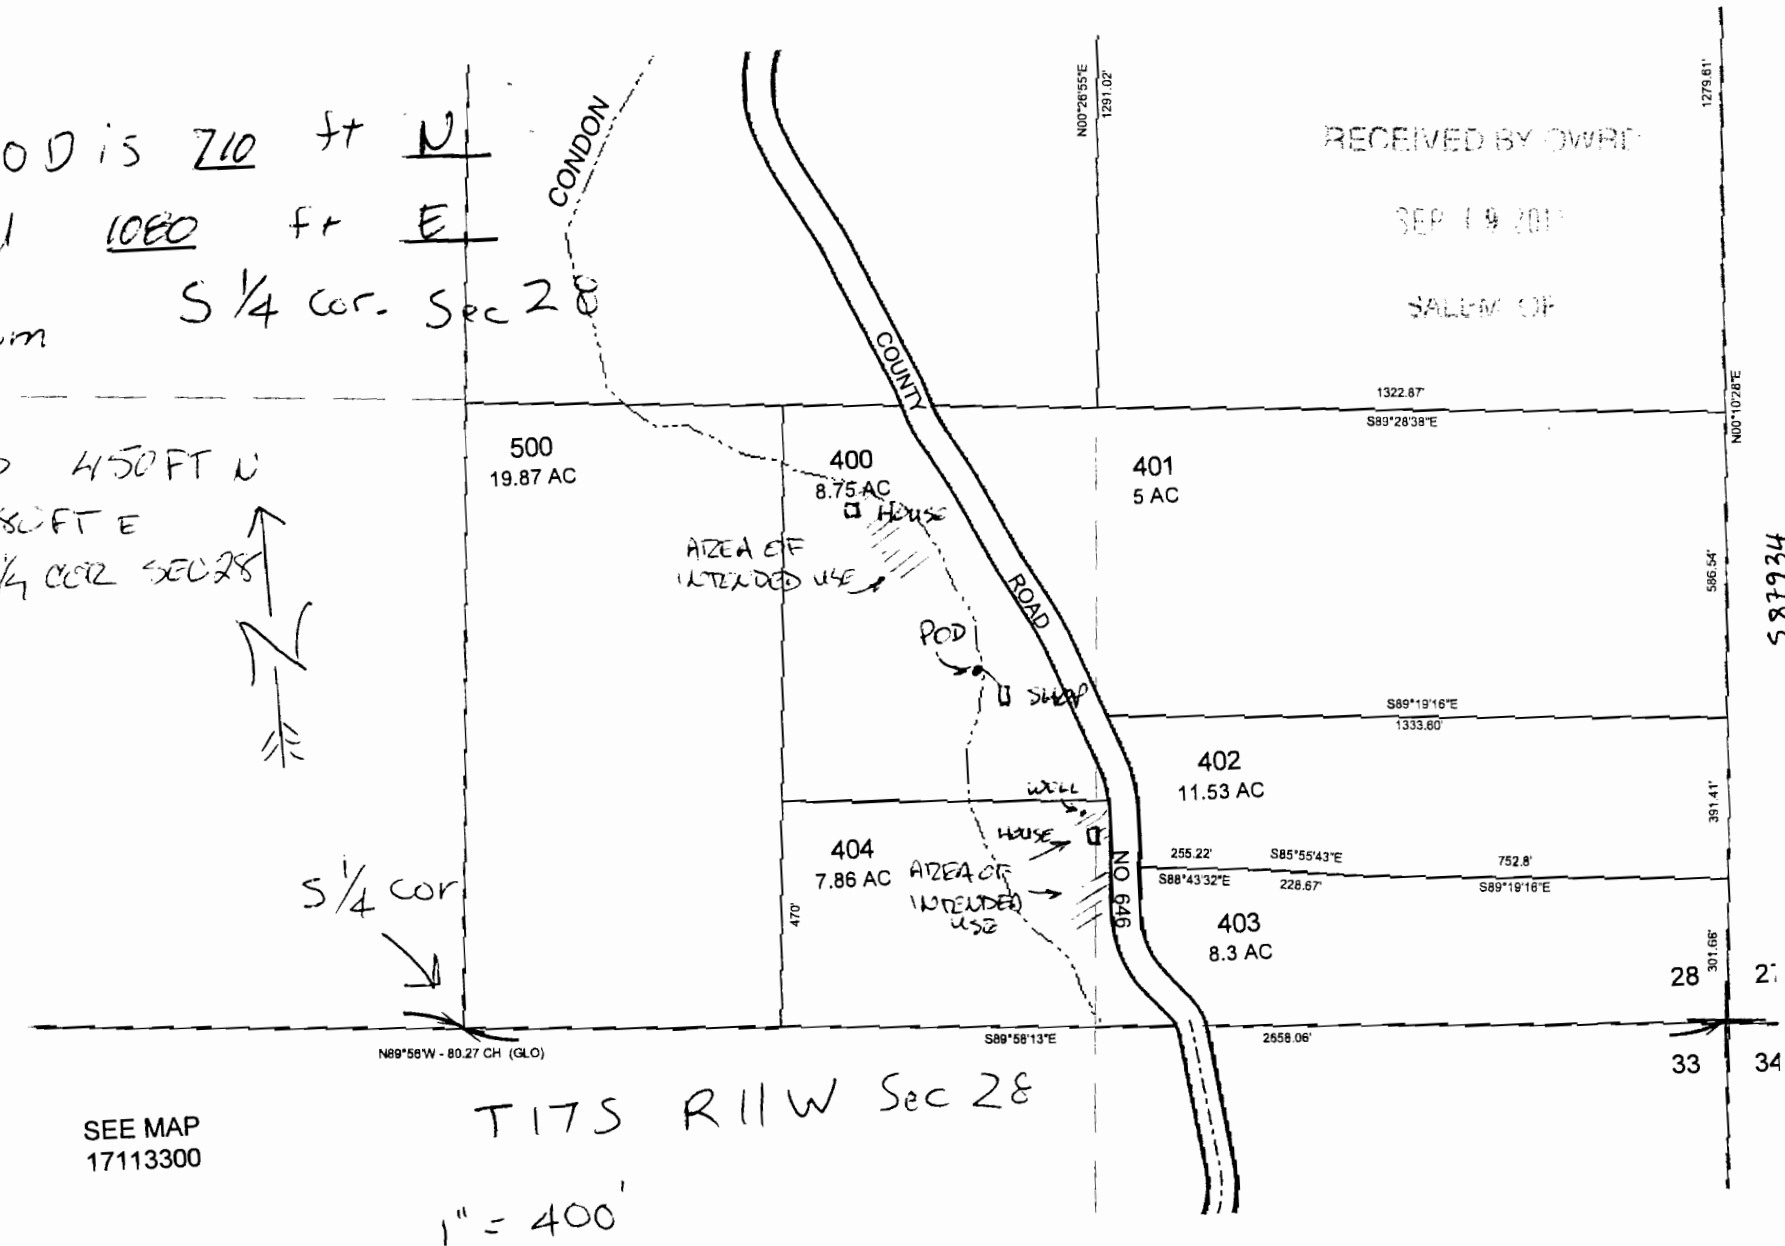SEE MAP
 17113300

T17S R11W Sec 28

1" = 400'


SEP 19 2011

SALEM OF

587934

28 27
 33 34