

This map was produced using the Polk County GIS data. The GIS data is maintained by the county to support its governmental activities. The county is not responsible for map errors, omissions, misuse or misinterpretation.


R-6790

RECEIVED

JUN 20 2013

WATER RESOURCES DEPT
SALEM OREGON

Scale
1" = 500'

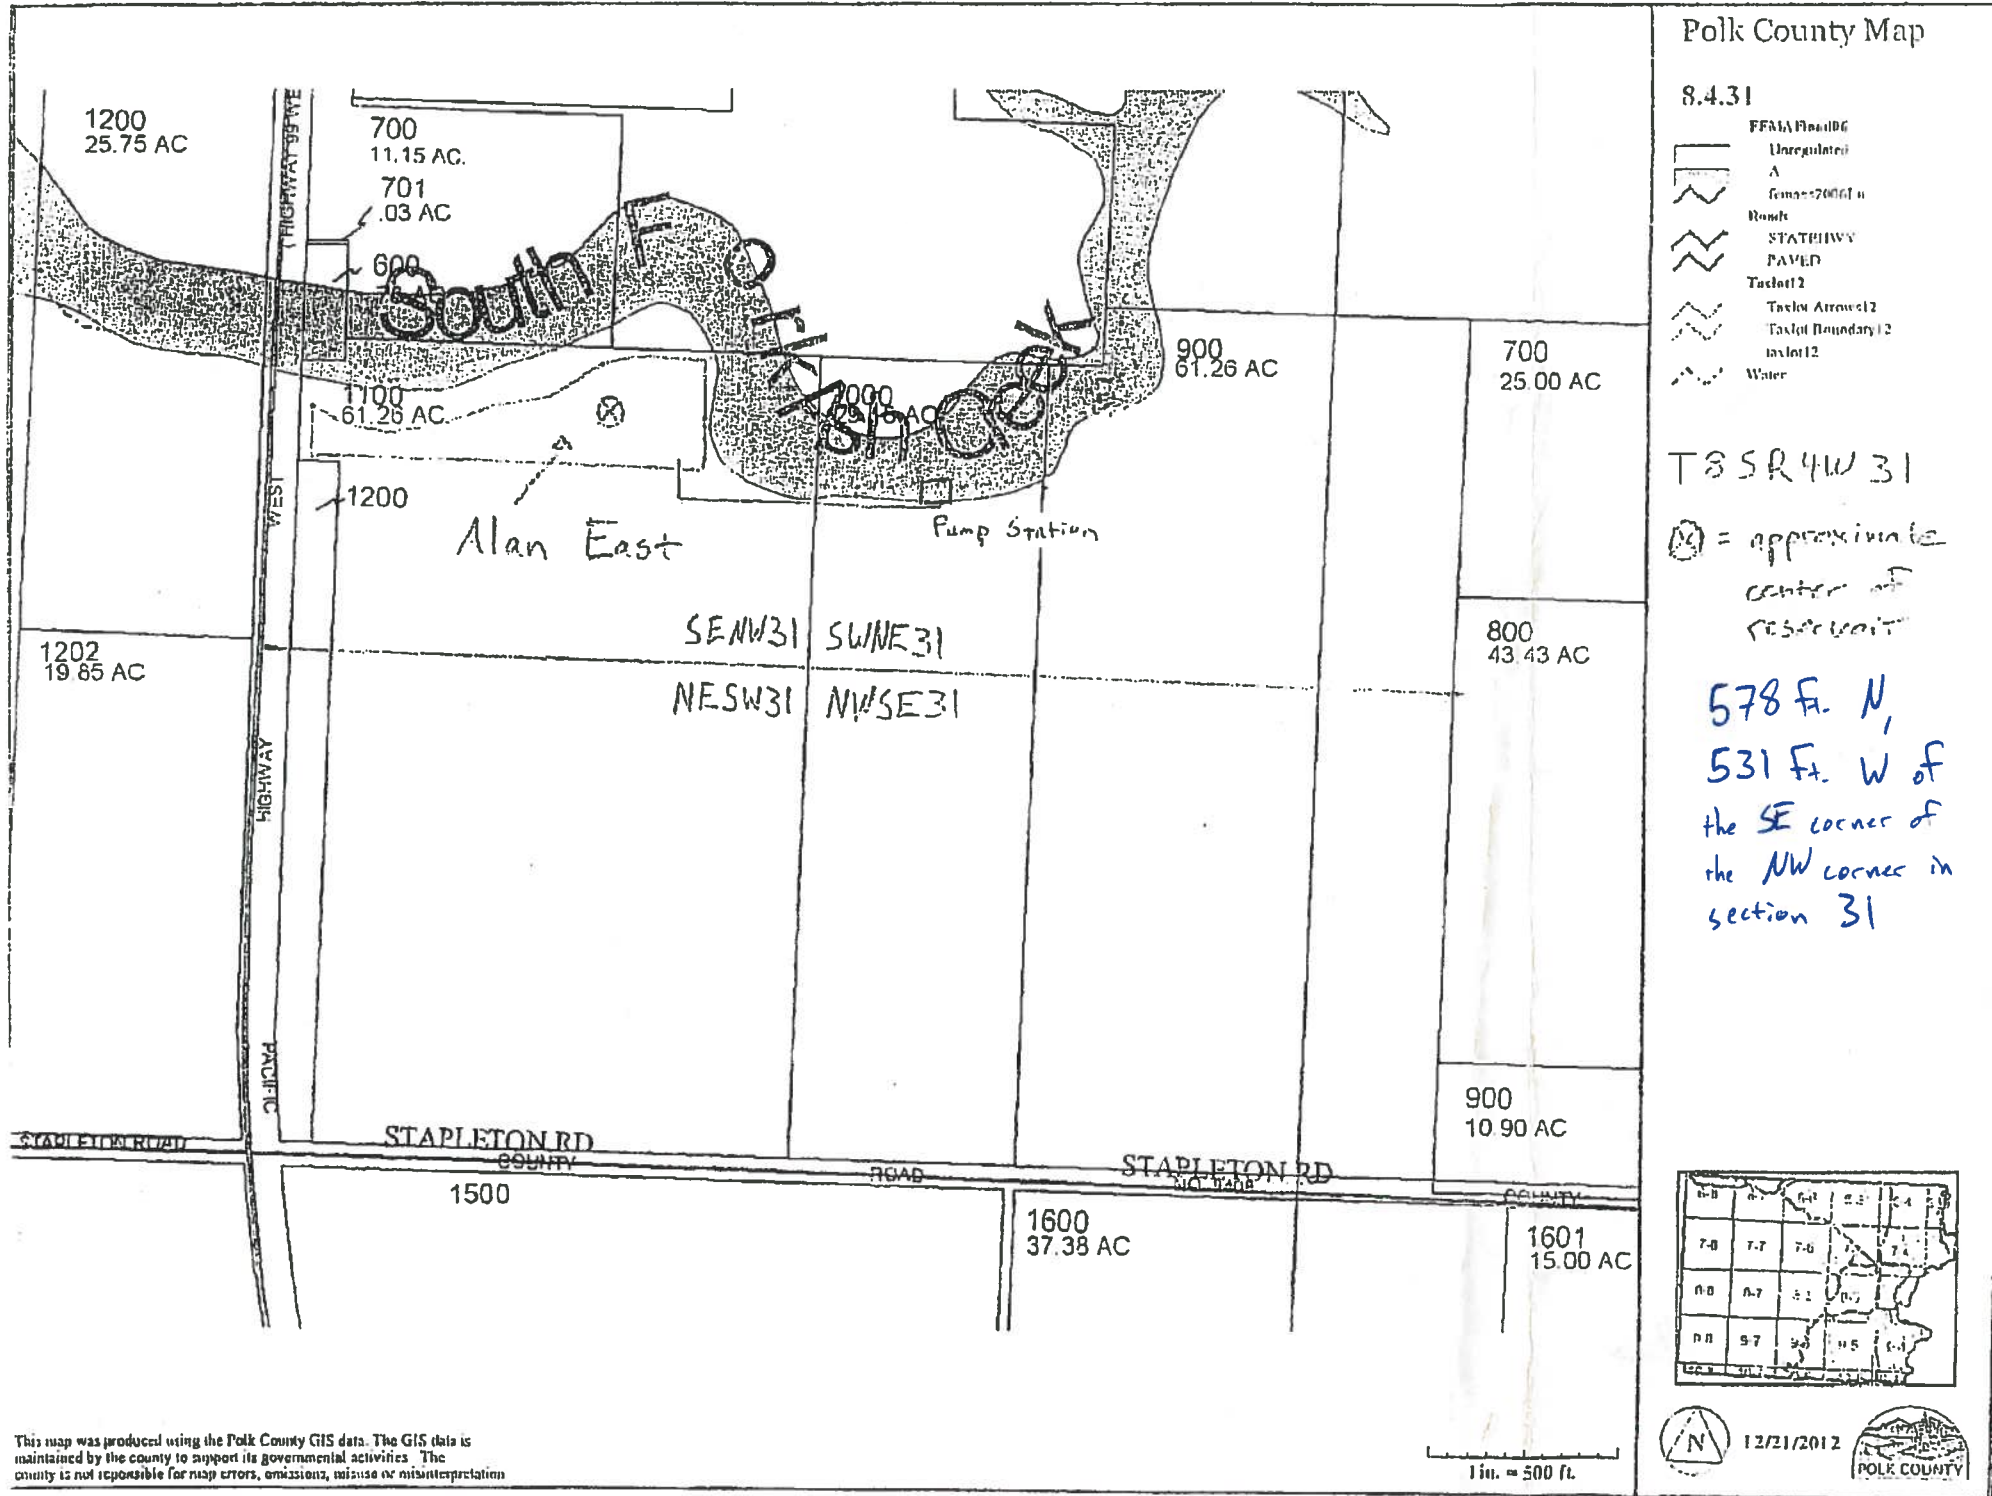

This map was produced using the Polk County GIS data. The GIS data is maintained by the county to support its governmental activities. The county is not responsible for map errors, omissions, misuse or misinterpretation.

R-07910