


1" = 1320'

Tax Lot: 1200

Section 11
SE 1/4

Township 3S, Range 3E, W.M.

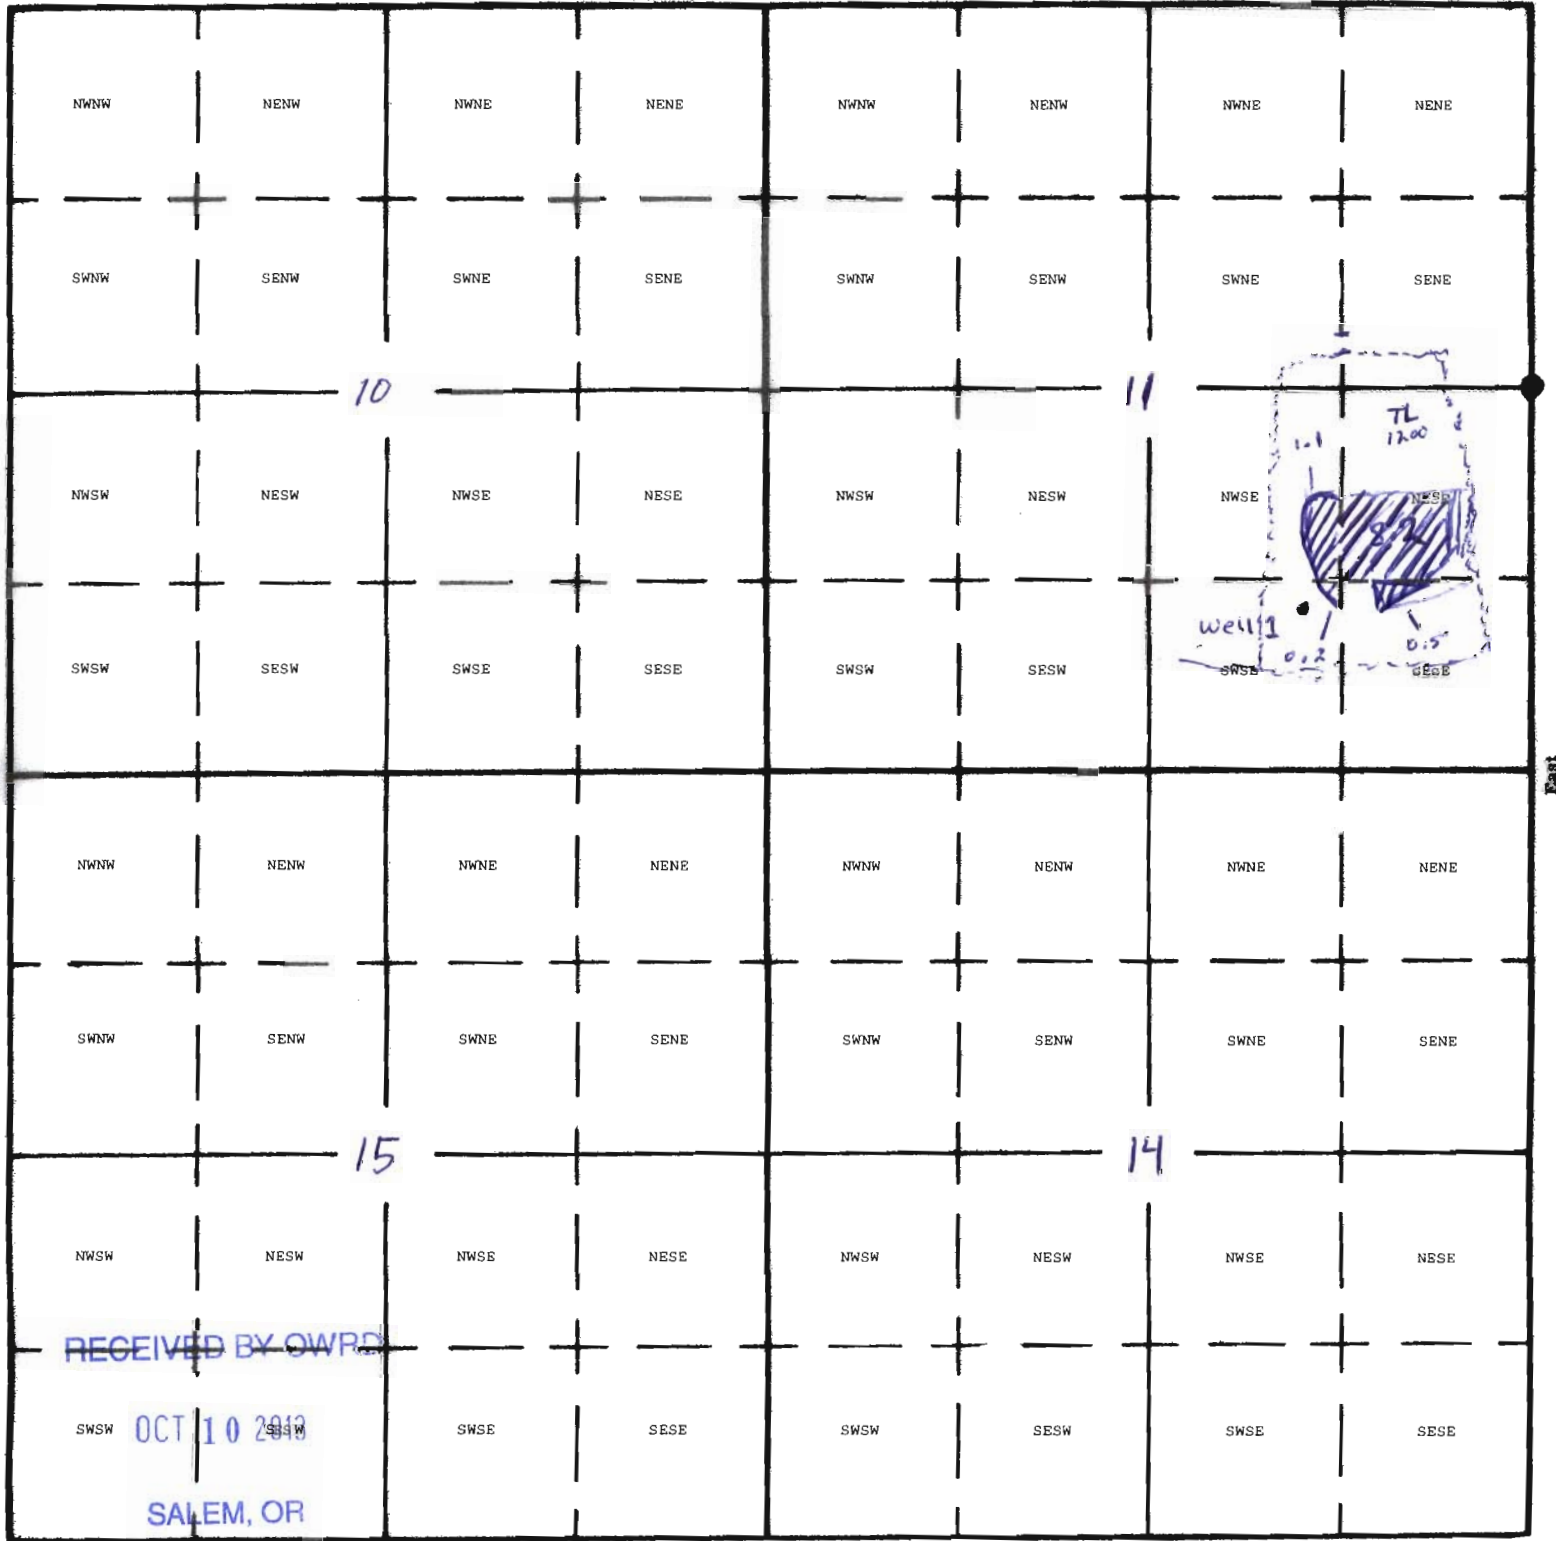

South

 Nursery use

Well 1 1400' S & 1500' W from E 1/4 cor. Sec 11

G17725

8.2 acres in NESE Sec 11
1.1 acres in NWSE Sec 11
0.2 acres in SWSE Sec 11
0.5 acres in SESE Sec 11 } all in taxlot 1200

