


Application No. 61650
Permit No. 50606

RECEIVED
AUG 03 1987
WATER RESOURCES DEPT.
SALEM, OREGON

SCALE: 4 inches = 1 mile


Revised 7-27-87

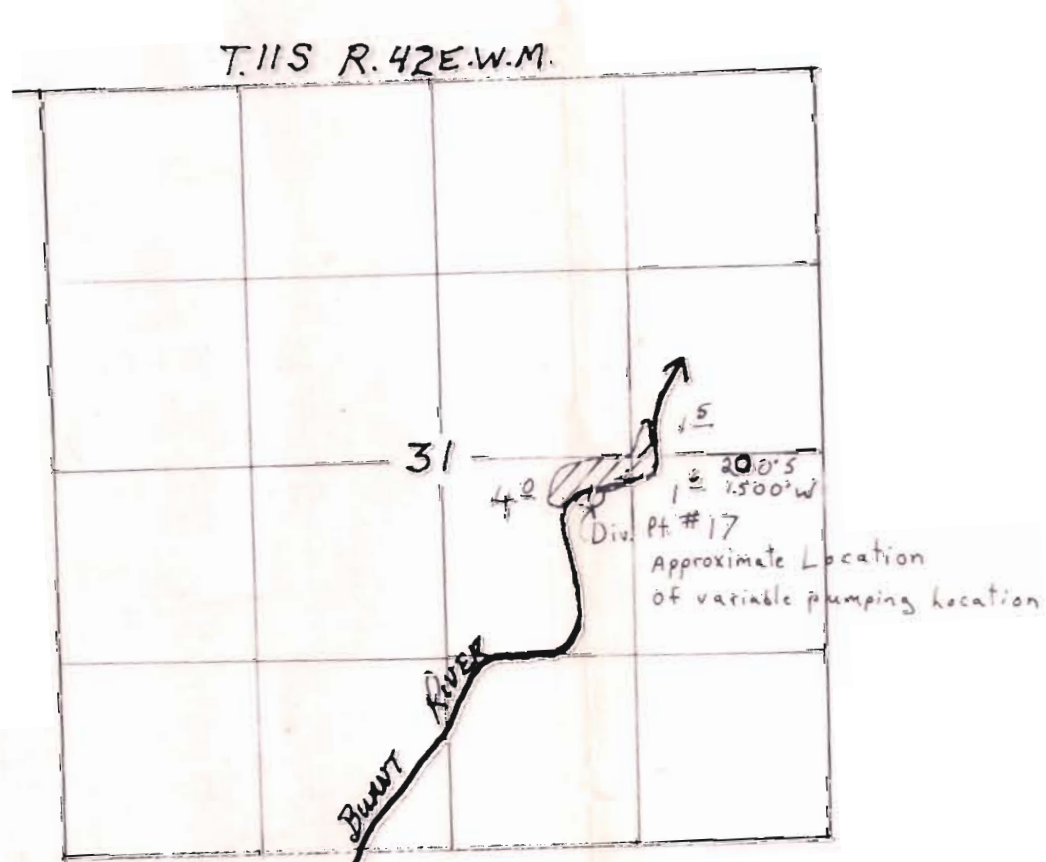

Application No. 61650
 Permit No. 50606

RECEIVED
 AUG 03 1987
 WATER RESOURCES DEPT.
 SALEM, OREGON

Revised 7-27-87

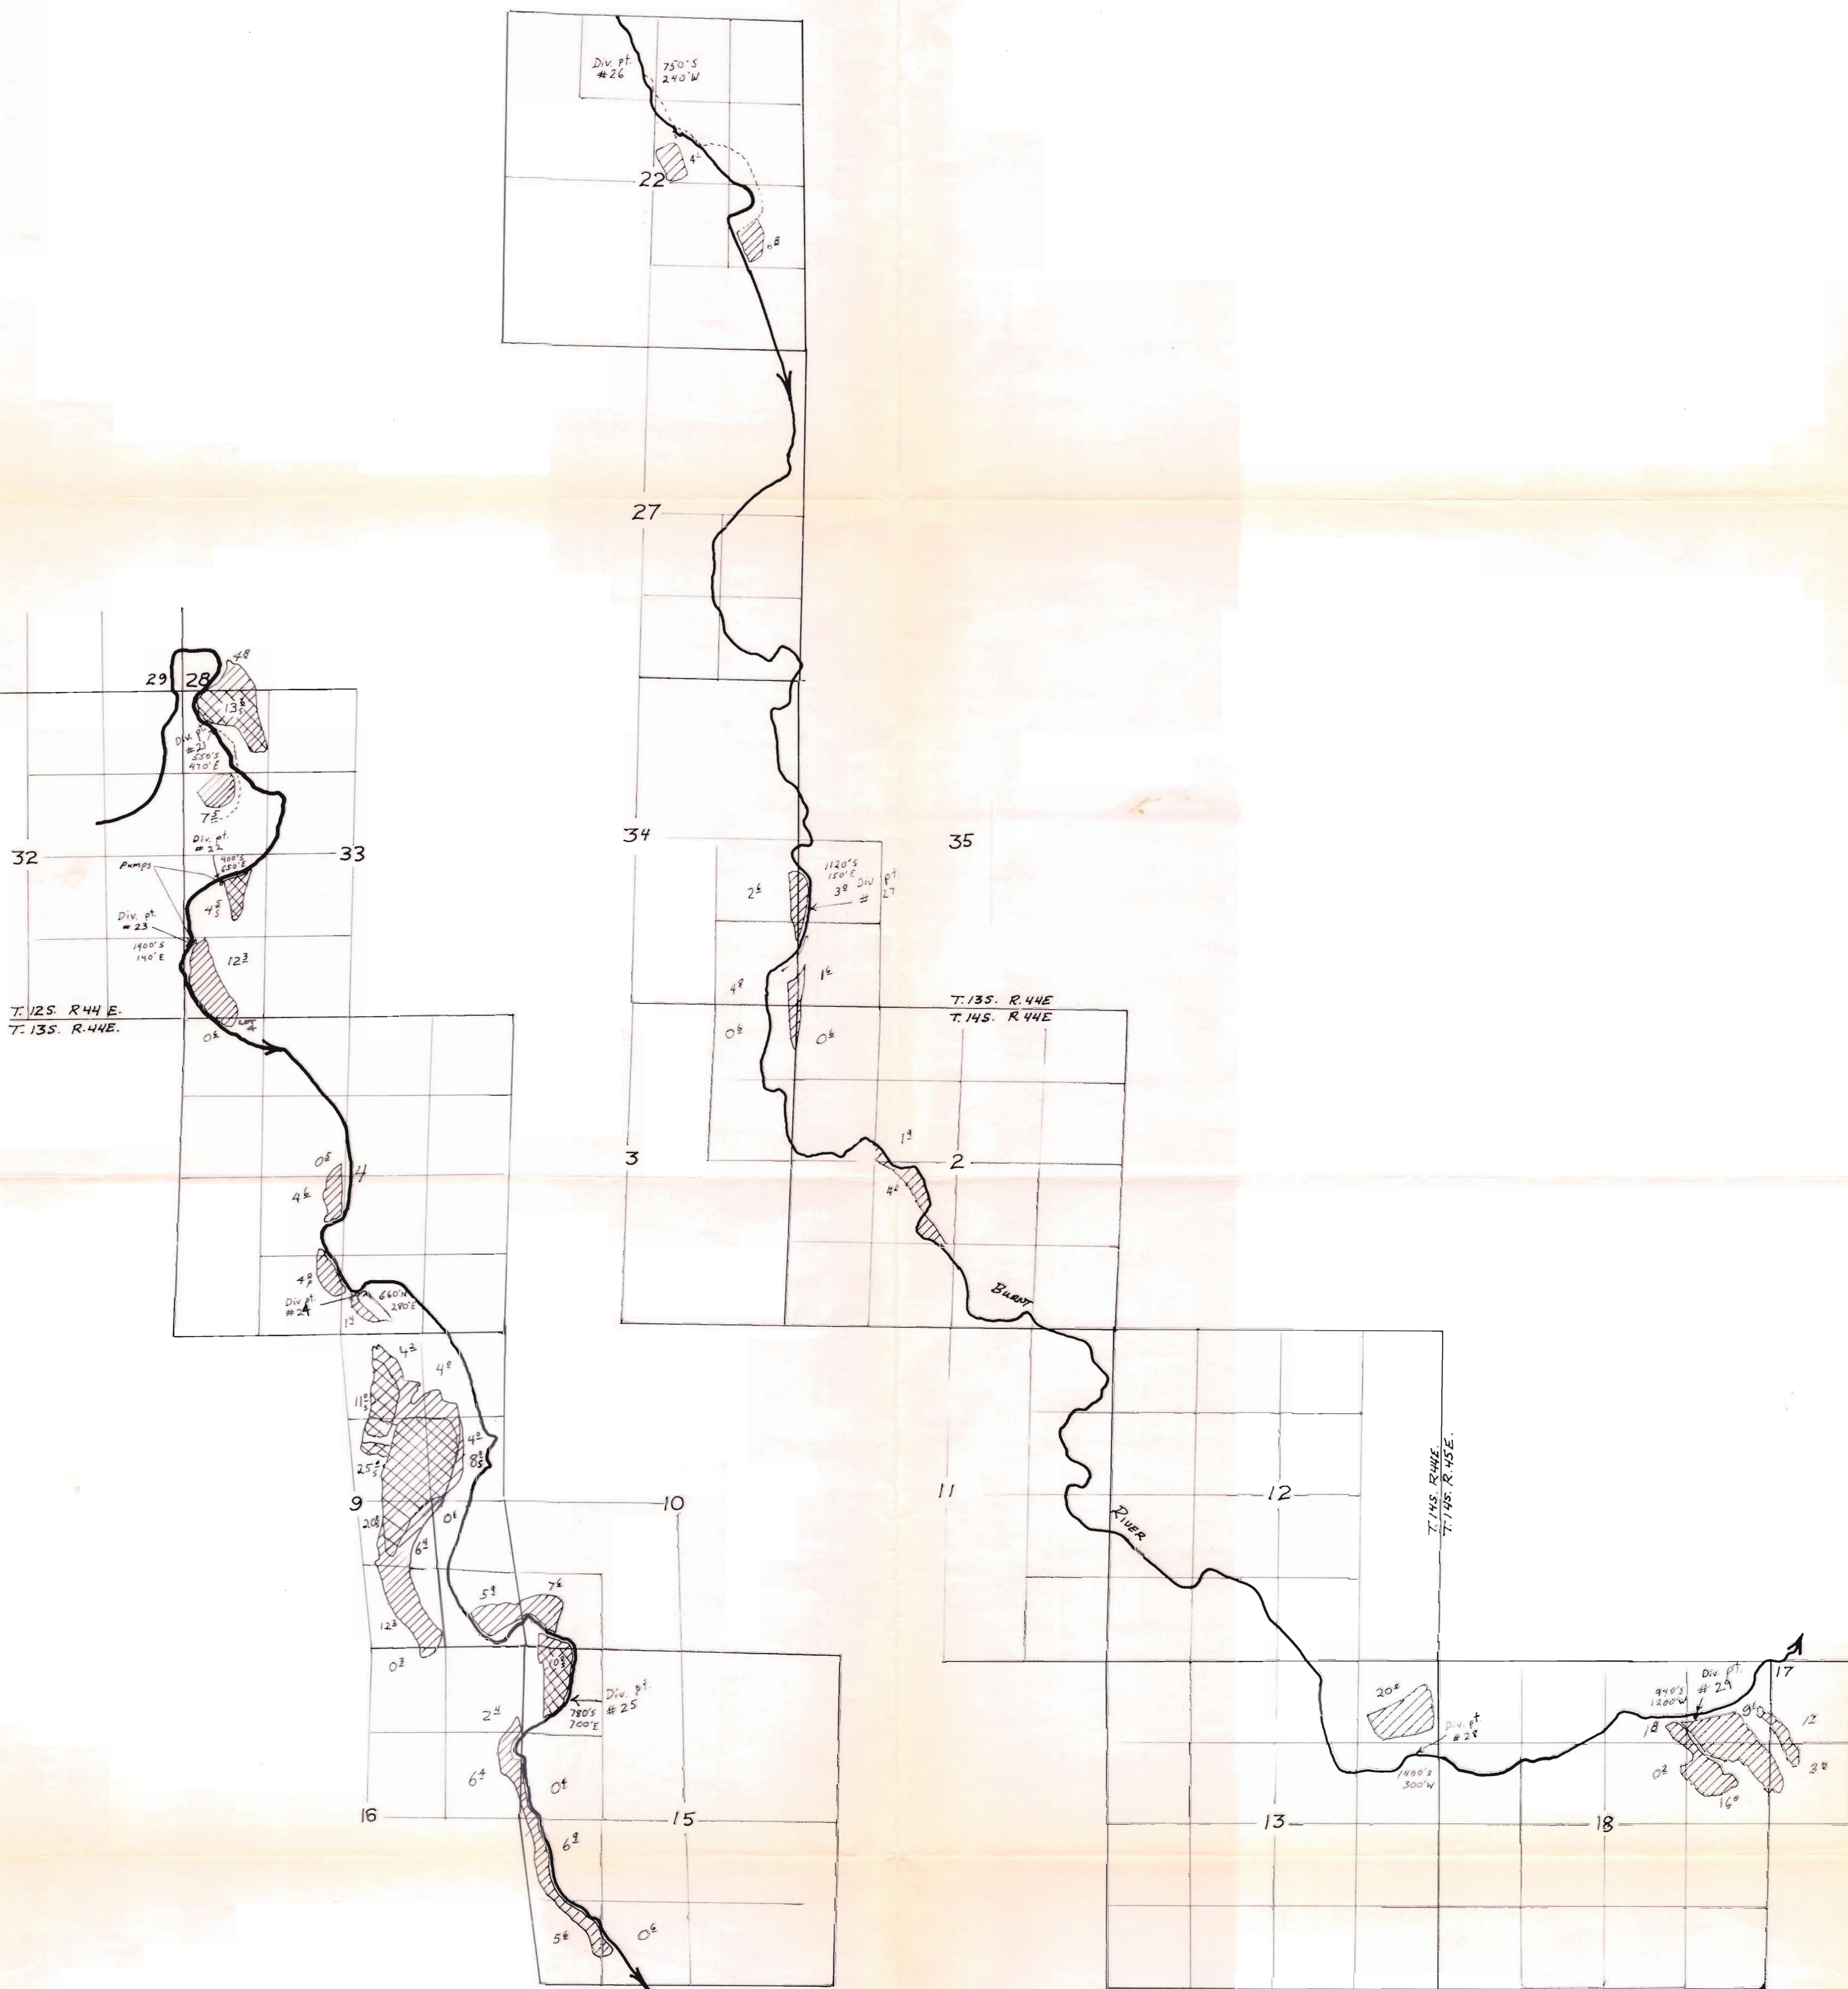




RECEIVED

AUG 03 1987

WATER RESOURCES DEPT.
SALEM, OREGON

Application No. 61650
Permit No. 50606

Revised 7-27-87

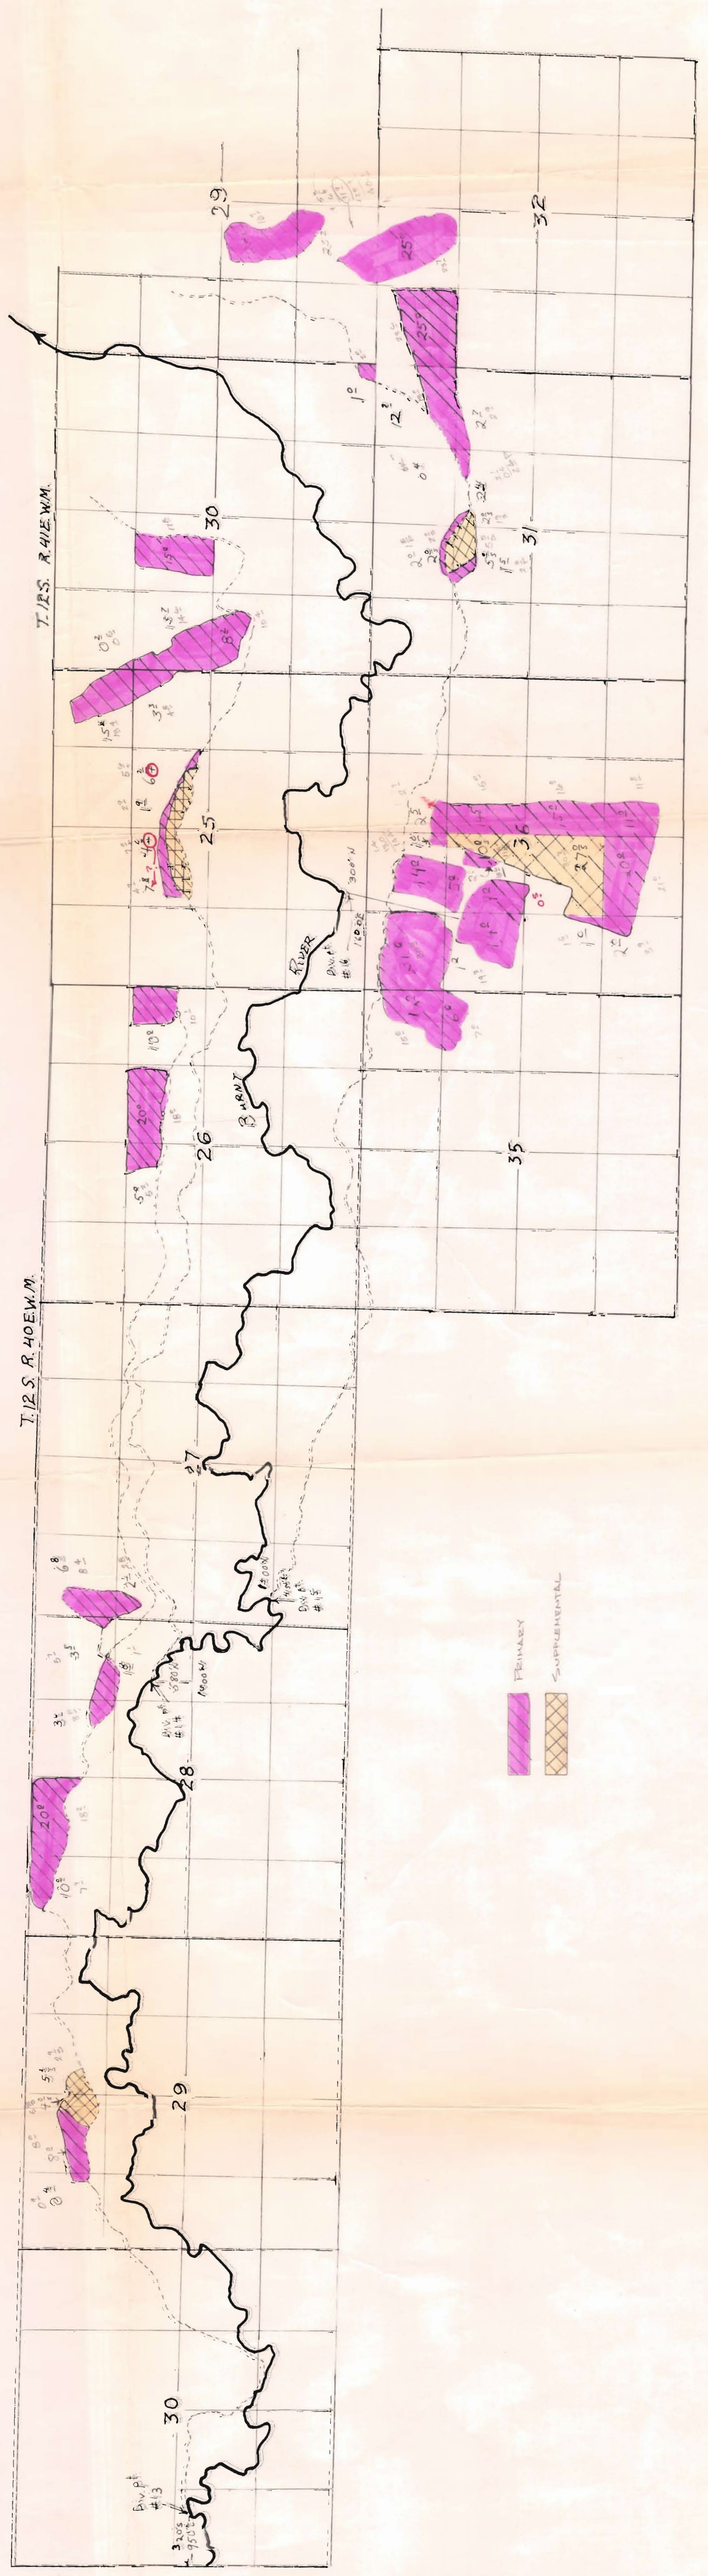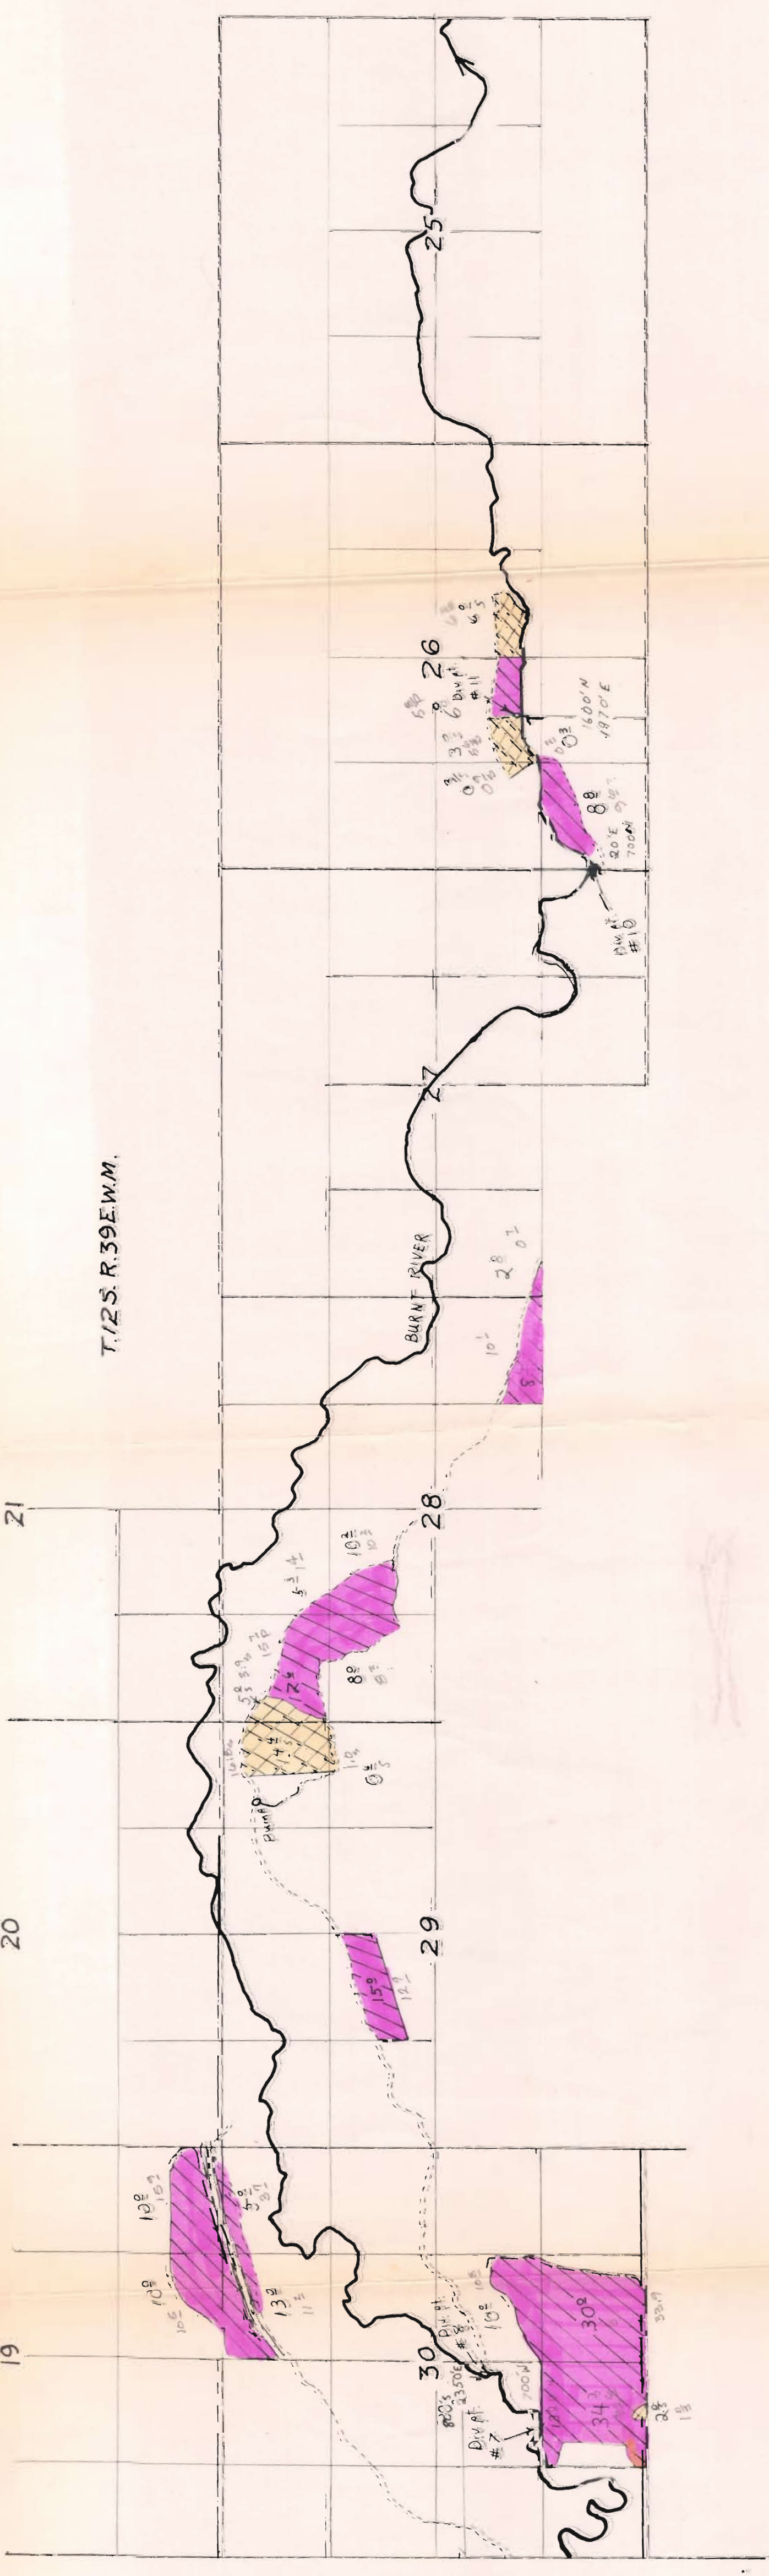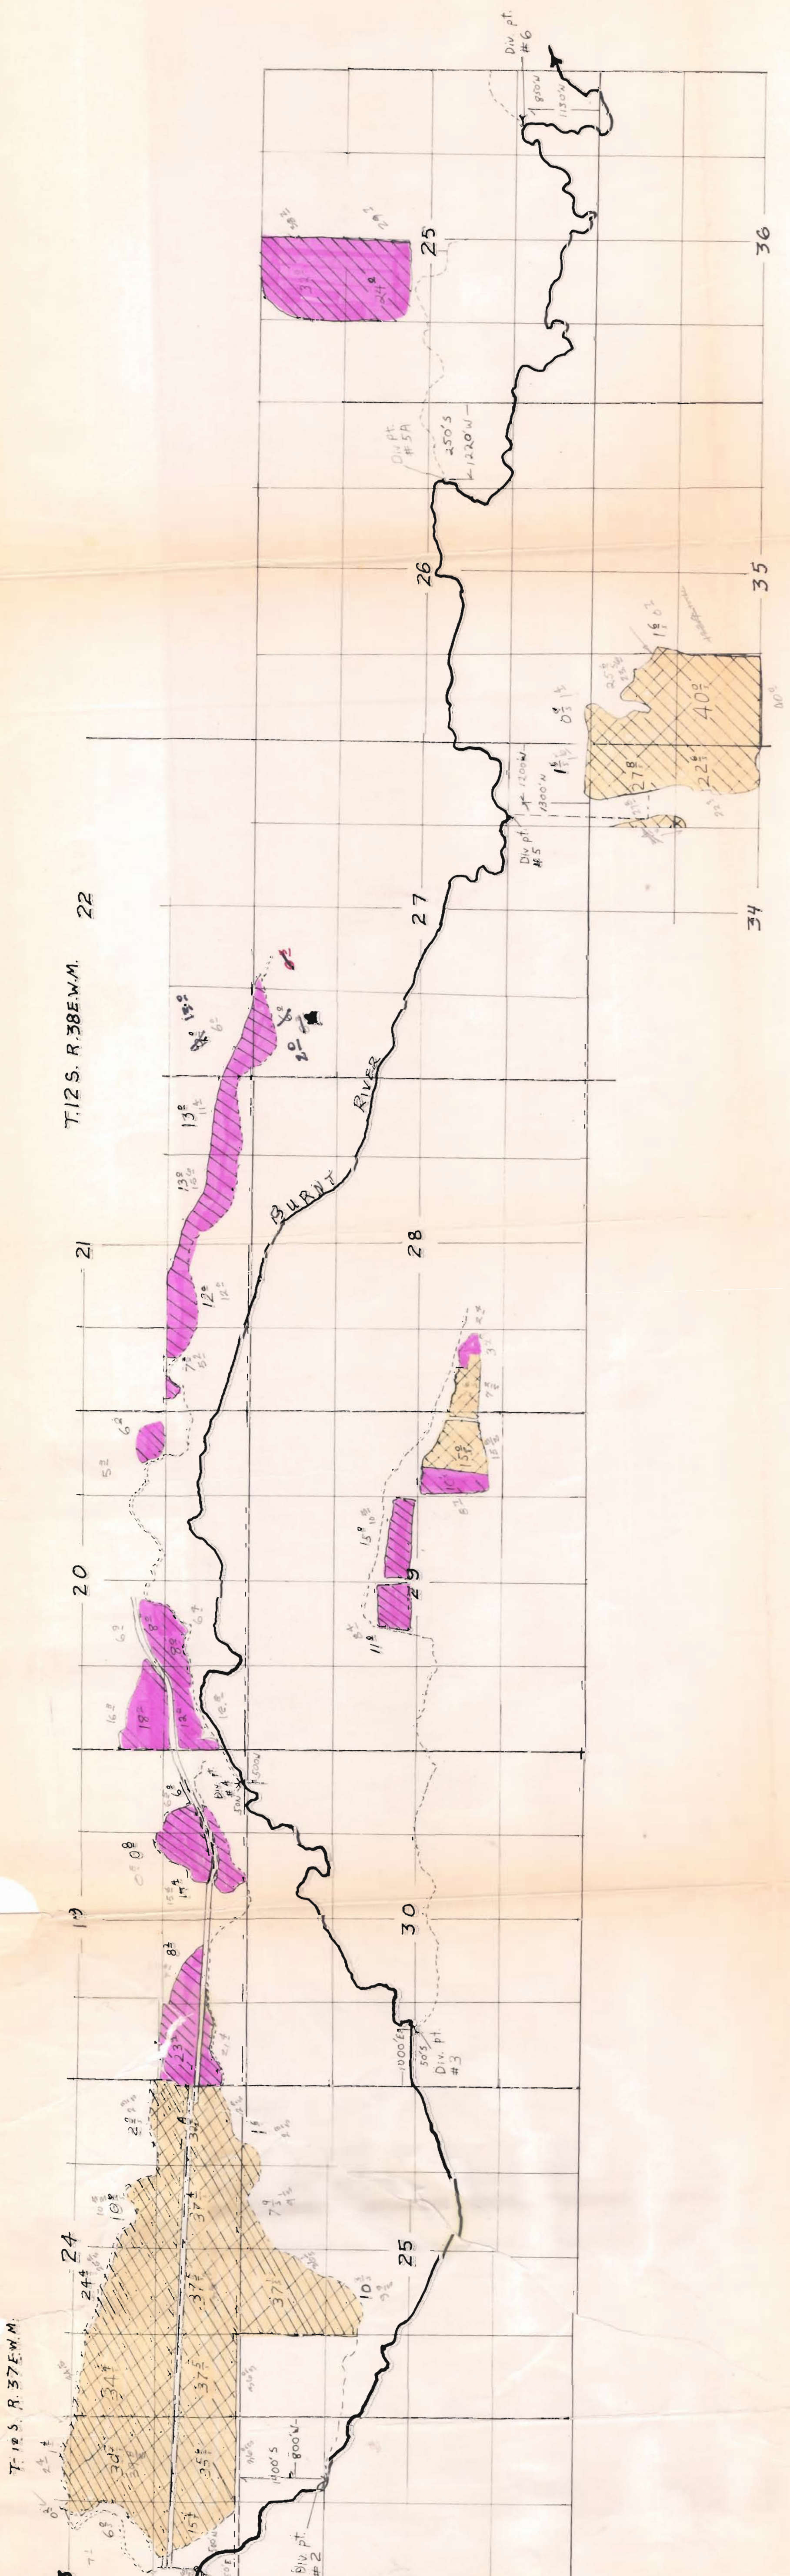




33	15.5				
34	15.5				
35	15.5				
36	15.5				

Application No. 61650
Permit No. 50616

RECEIVED
MAY 18 1937
WATER RESOURCES DEPT.
SALEM, OREGON

SCALE: 4 inches = 1 mile

Revised 7-27-37

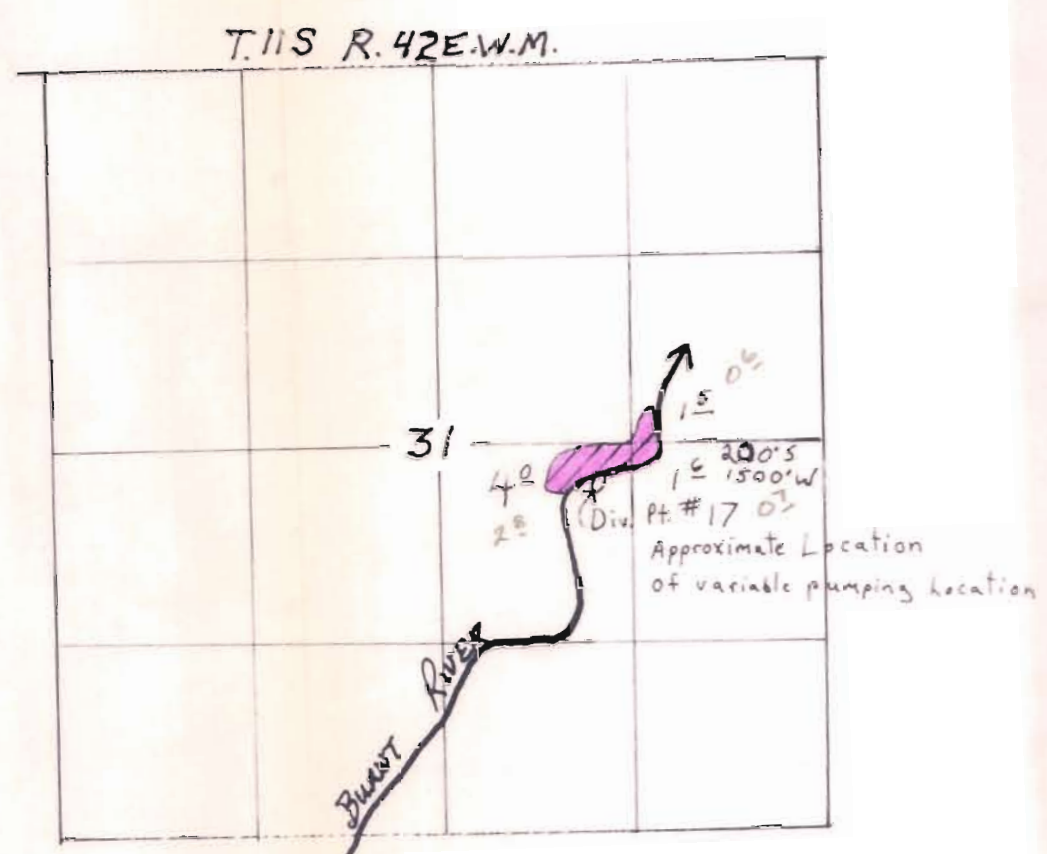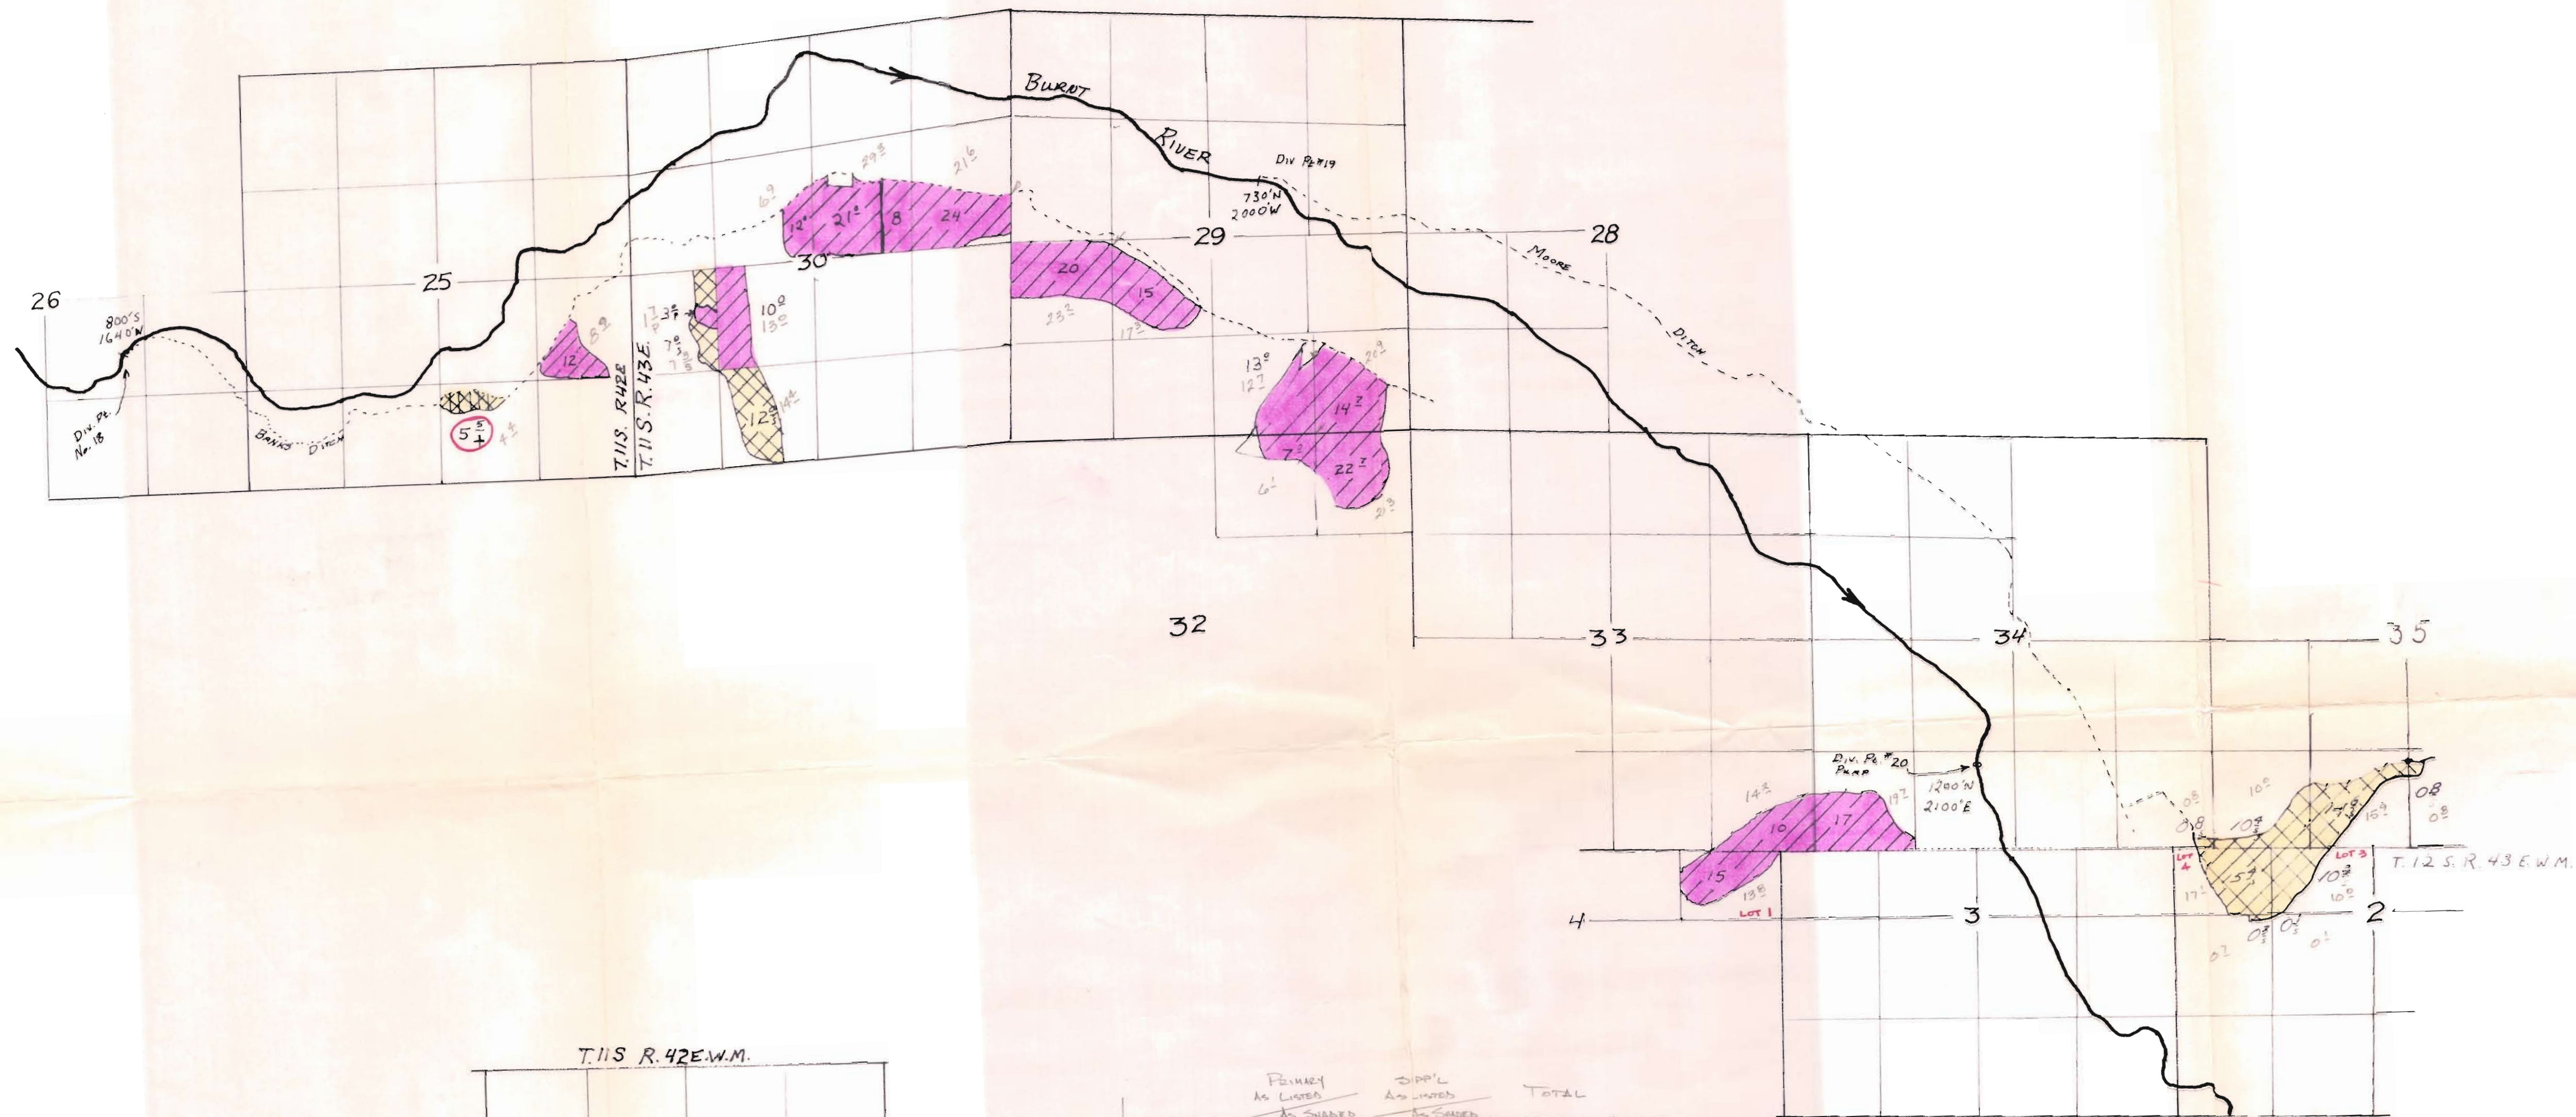

DIV. PT #	PUMPED AS LISTED		SUPPLY AS LISTED		TOTAL
	AS SHOWN	AS SHOWN	AS SHOWN	AS SHOWN	
#17	7.1	4.1	7.1	4.1	-3.0
#18	182.4	181.9	24.7	26.1	208.0 + 1.1
#19			52.4	55.4	55.4 + 2.8
#20	42.0	47.7	42.0	47.7	+5.7
					+6.8

Pink - primary
 Yellow - supplemental

Application No. 61650
 Permit No. 50606

RECEIVED
 AUG 03 1987
 WATER RESOURCES
 SALEM, OREGON

Div. Pt. #	FORMER		SUPPL		TOTAL		
	Lineal	Watered	Lineal	Watered	Lineal	Watered	
21	15.7	9.9	15.0	14.6	30.7	24.5	-1.4
22			2.5	4.2	4.5	4.2	-0.3
23	12.9	13.3			12.9	13.3	+0.4
24	42.2	52.1	64.0	55.1	106.2	107.2	+1.0
25	50.5	35.9	10.0	10.6	45.8	44.5	-1.0
26	10.9	8.9			10.9	8.9	-2.0
27	19.1	17.8			19.1	17.8	-1.3
28	20.0	13.5			20.0	13.5	-6.5
29	51.5	36.9			51.5	36.9	-14.6
							-8.0



Pink - primary
 Yellow - supplemental

Revised 7-27-87