


T 21 S, R 35 E – Harney, County

TL 400

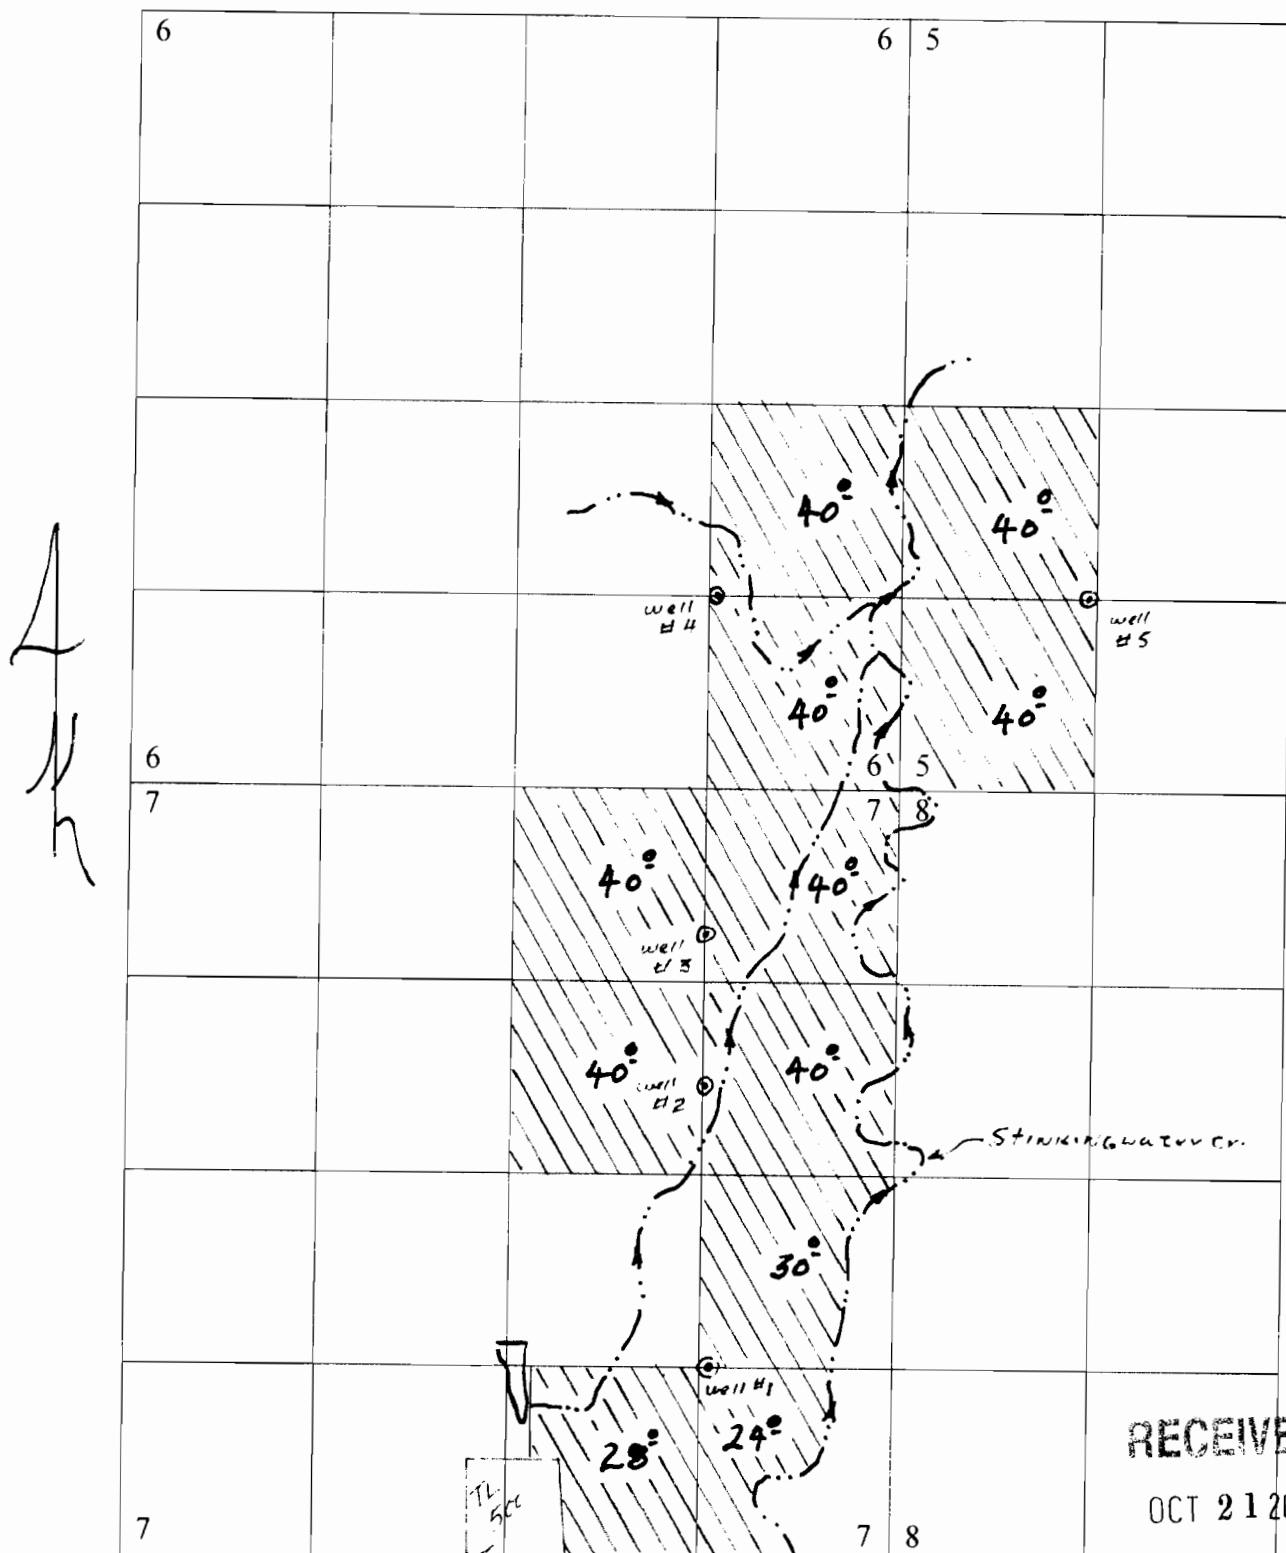

Scale – 1" = 1320'

Well 1 – SE SE, Section 7, T 21 S, R 35 E, WM, 1320' N & 1310' W from the SE Corner, Section 7. Well 2 – SW NE, Section 7, T 21 S, R 35 E, WM, 2000' N & 1320' W from the NE Corner, Section 7. Well 3 – NW NE, Section 7, T 21 S, R 35 E, WM, 1000' N & 1320' W from the NE Corner, Section 7. Well 4 – SE SE, Section 6, T 21 S, R 35 E, WM, 1320' N & 1310' W from the SE Corner, Section 6. Well 5 – SW SW, Section 5, T 21 S, R 35 E, WM, 1320' N & 1310' E from the SW Corner, Section 5.

617730

THIS MAP WAS PREPARED FOR
ASSESSMENT PURPOSE ONLY

0 2,000 4,000
SCALE IN FEET

503
938-3740

T.21S. R.35E. W.M.
HARNEY COUNTY
1" = 2000'

21S 35E
& INDEX


RECEIVED
OCT 21 2013

WATER RESOURCES DEPT
SALEM, OREGON

G17730


SEE MAP 21S 34E

SEE MAP 21S 36E

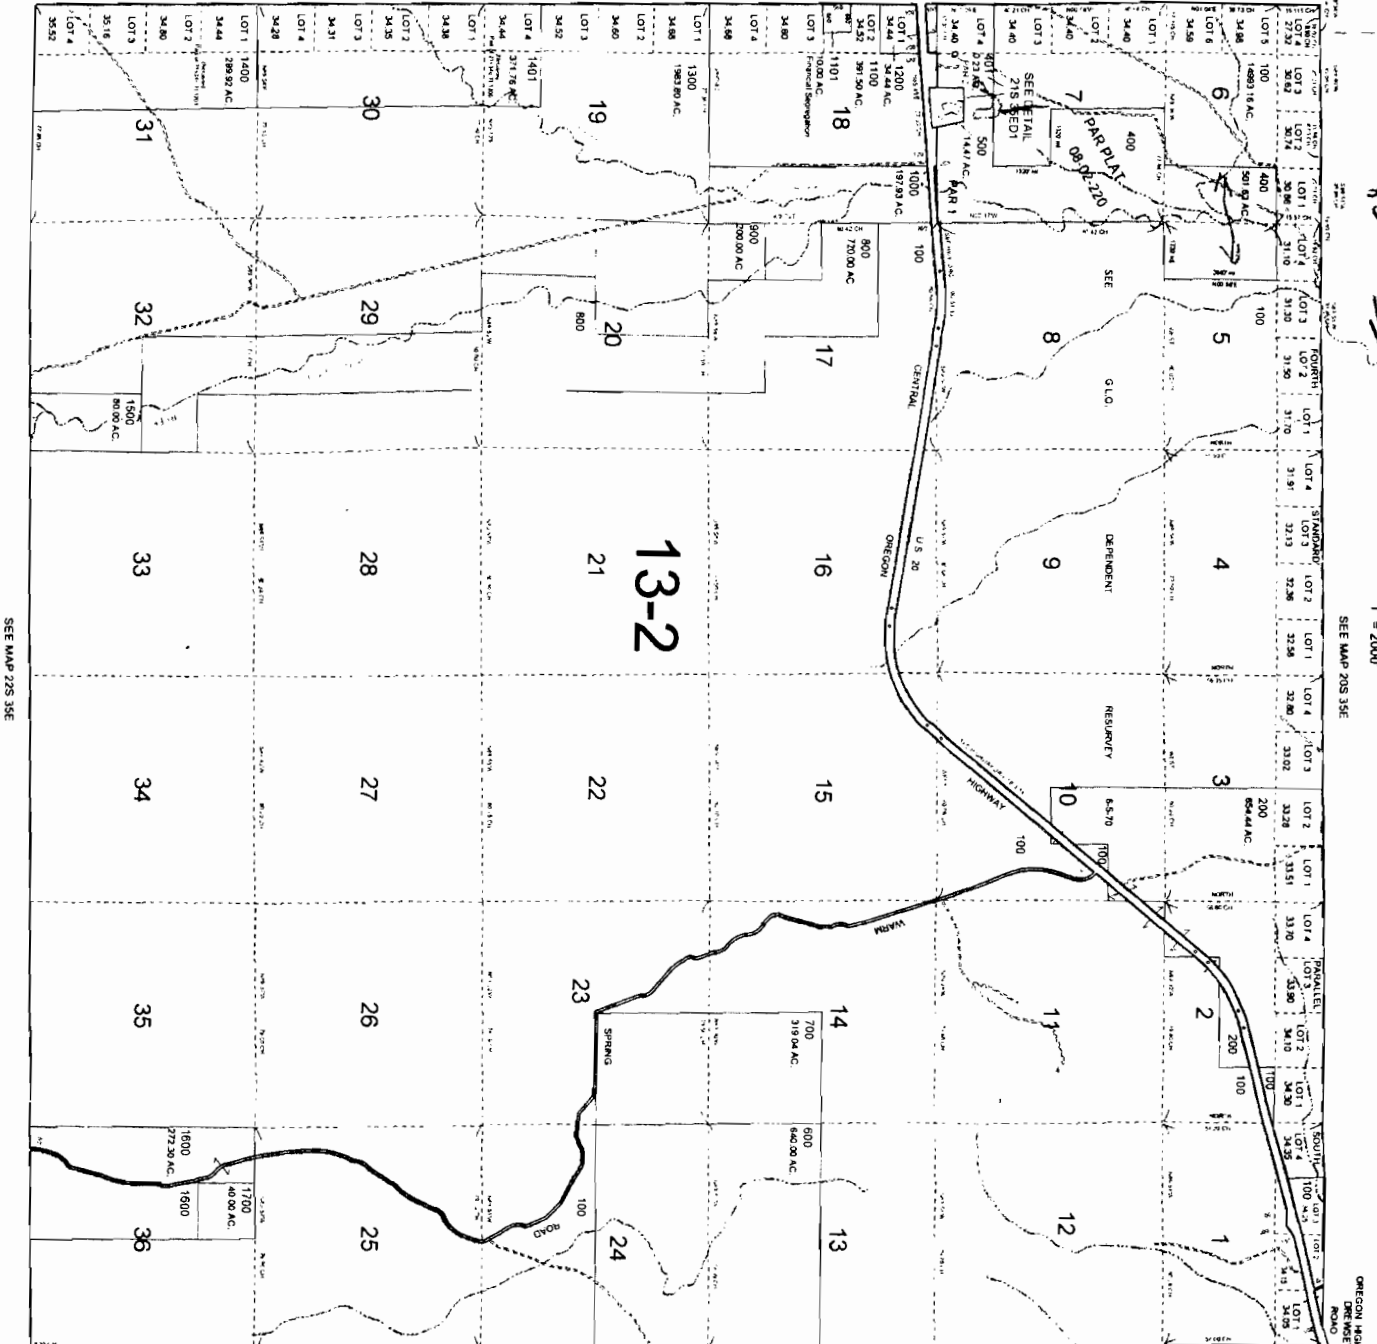

SEE MAP 22S 35E

PRINTED ON
Jun 02, 2008
21S 35E
& INDEX

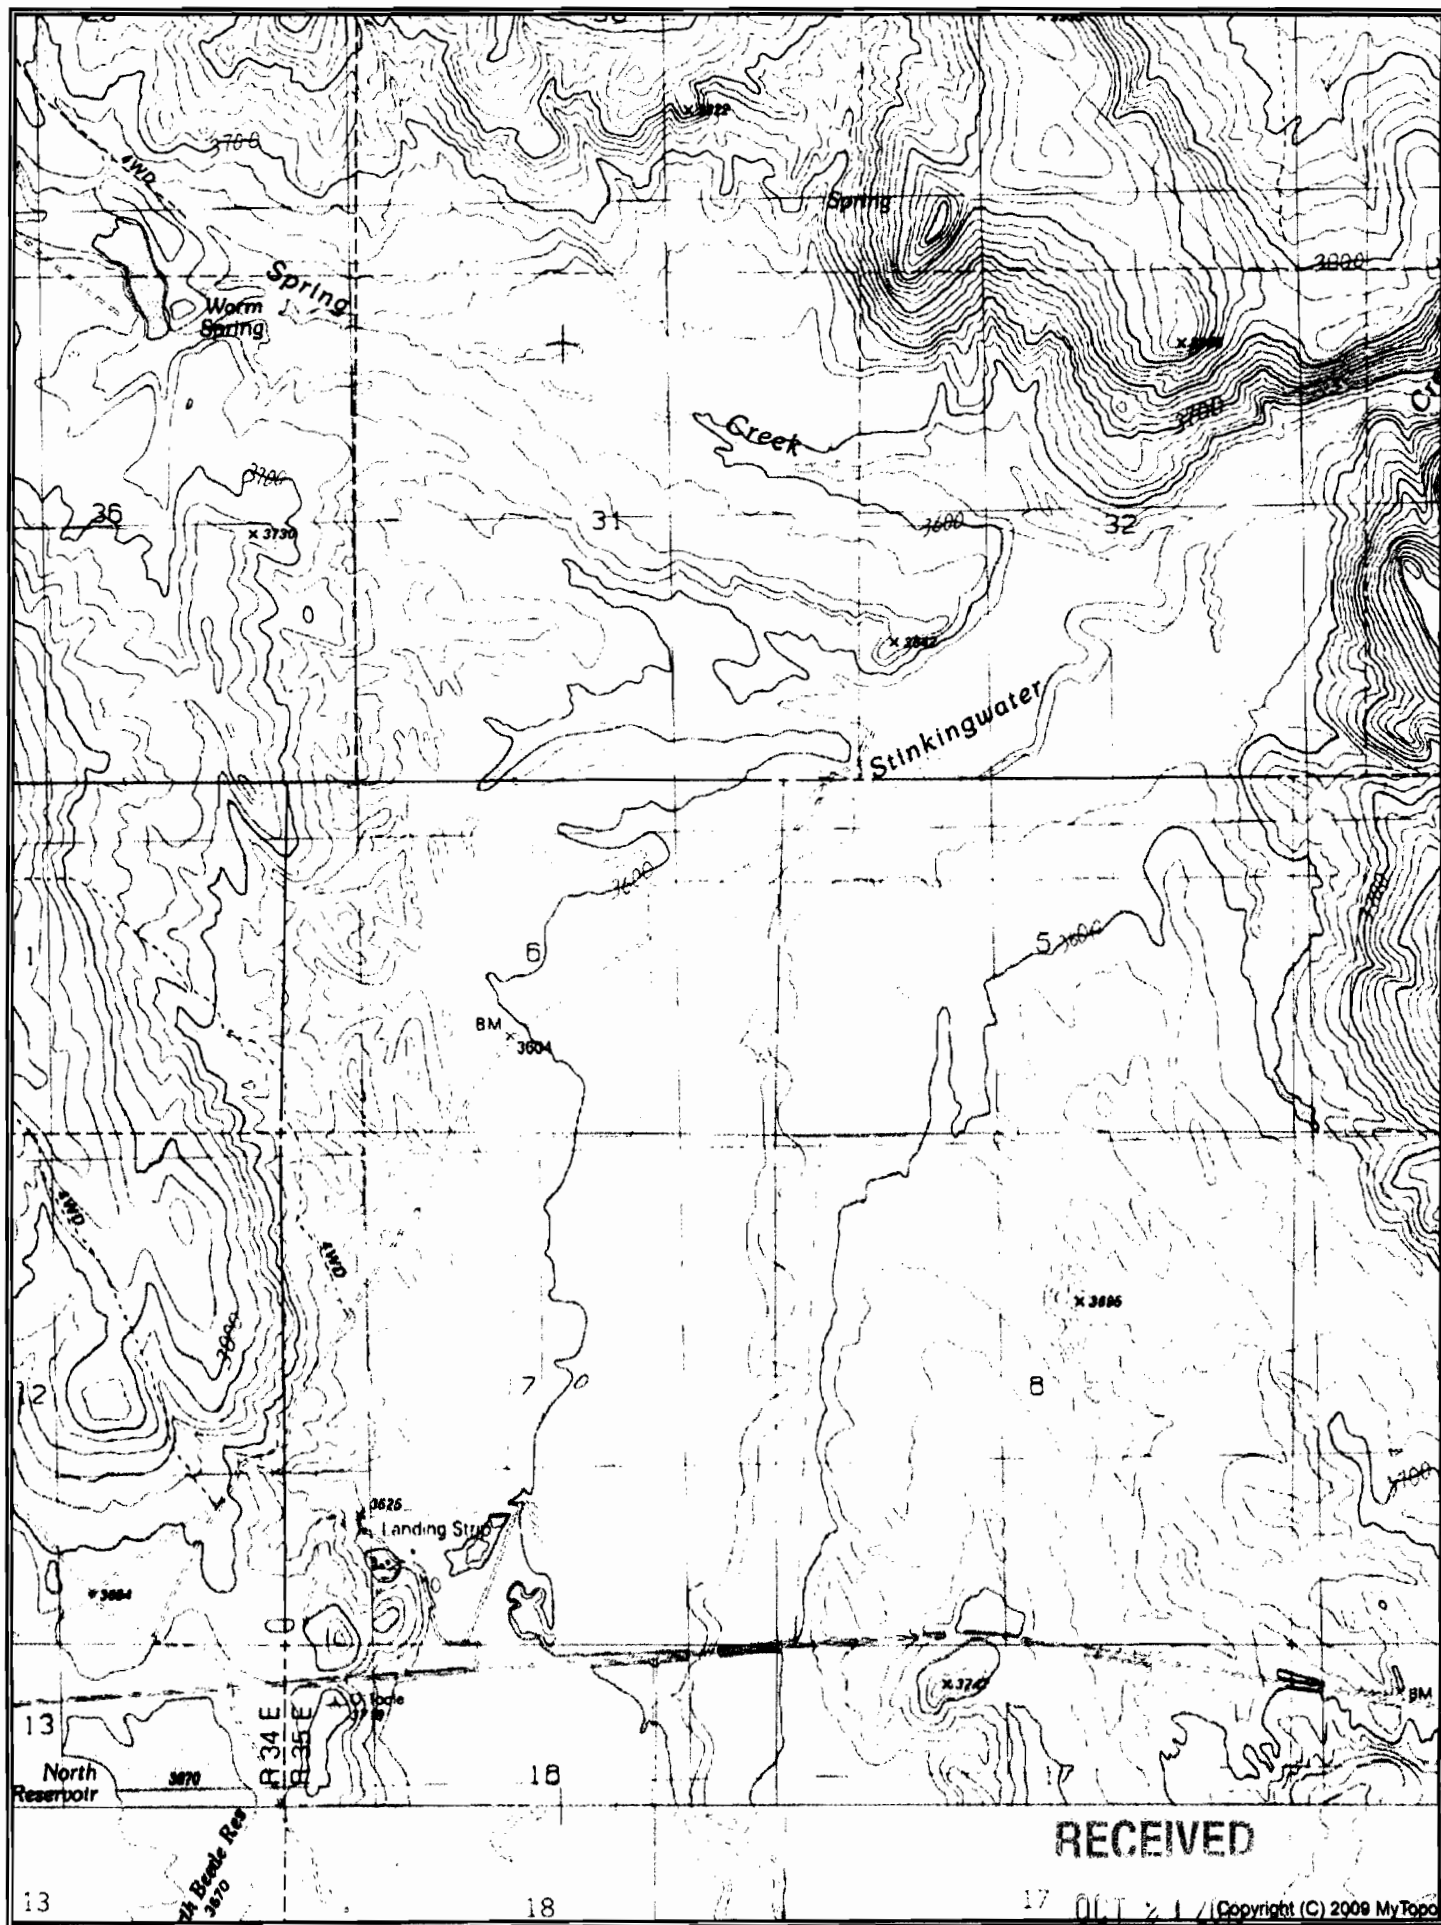

G17730

WATER RESOURCES DEPT
SALEM OREGON