

~~CONFIDENTIAL~~ NOT CANCELLED



P 8 5 33

PARALLEL

NORTH

32

34

20

35.80 Ac<sup>+</sup>

300  
18.50 Ag

16.50 AC

LOT 3

11.51  
Acres

100  
32.60 Ac.  
100 M 1

100 M1

26.18

CS# 192






7.77  
2.78  
Acres

5.12  
ACCEPT

|     |       |
|-----|-------|
| .85 | Acres |
|-----|-------|

CS# 1028

**5-08**

600

700

200

900  
12.60 Ac

12.50 Ac

COR

|     |     |   |   |   |
|-----|-----|---|---|---|
| SEE | MAP | 7 | 5 | 3 |
|-----|-----|---|---|---|

**RECEIVED**


WATER RESOURCES DEPT  
SALEM, OREGON

617731

| REVISIONS |     |             |      |          |
|-----------|-----|-------------|------|----------|
| ZONE      | REV | DESCRIPTION | DATE | APPROVED |



**RECEIVED**

OCT 21 2013

WATER RESOURCES DEPT  
SALEM, OREGON


12734 MARSHLAND RD

|       |  |          |  |         |  |       |  |
|-------|--|----------|--|---------|--|-------|--|
| SIZE  |  | FSCM NO. |  | DWG NO. |  | REV   |  |
| SCALE |  |          |  |         |  | SHEET |  |

© 2013 Google

617731

1" = 400' N↑ CANCELLED:

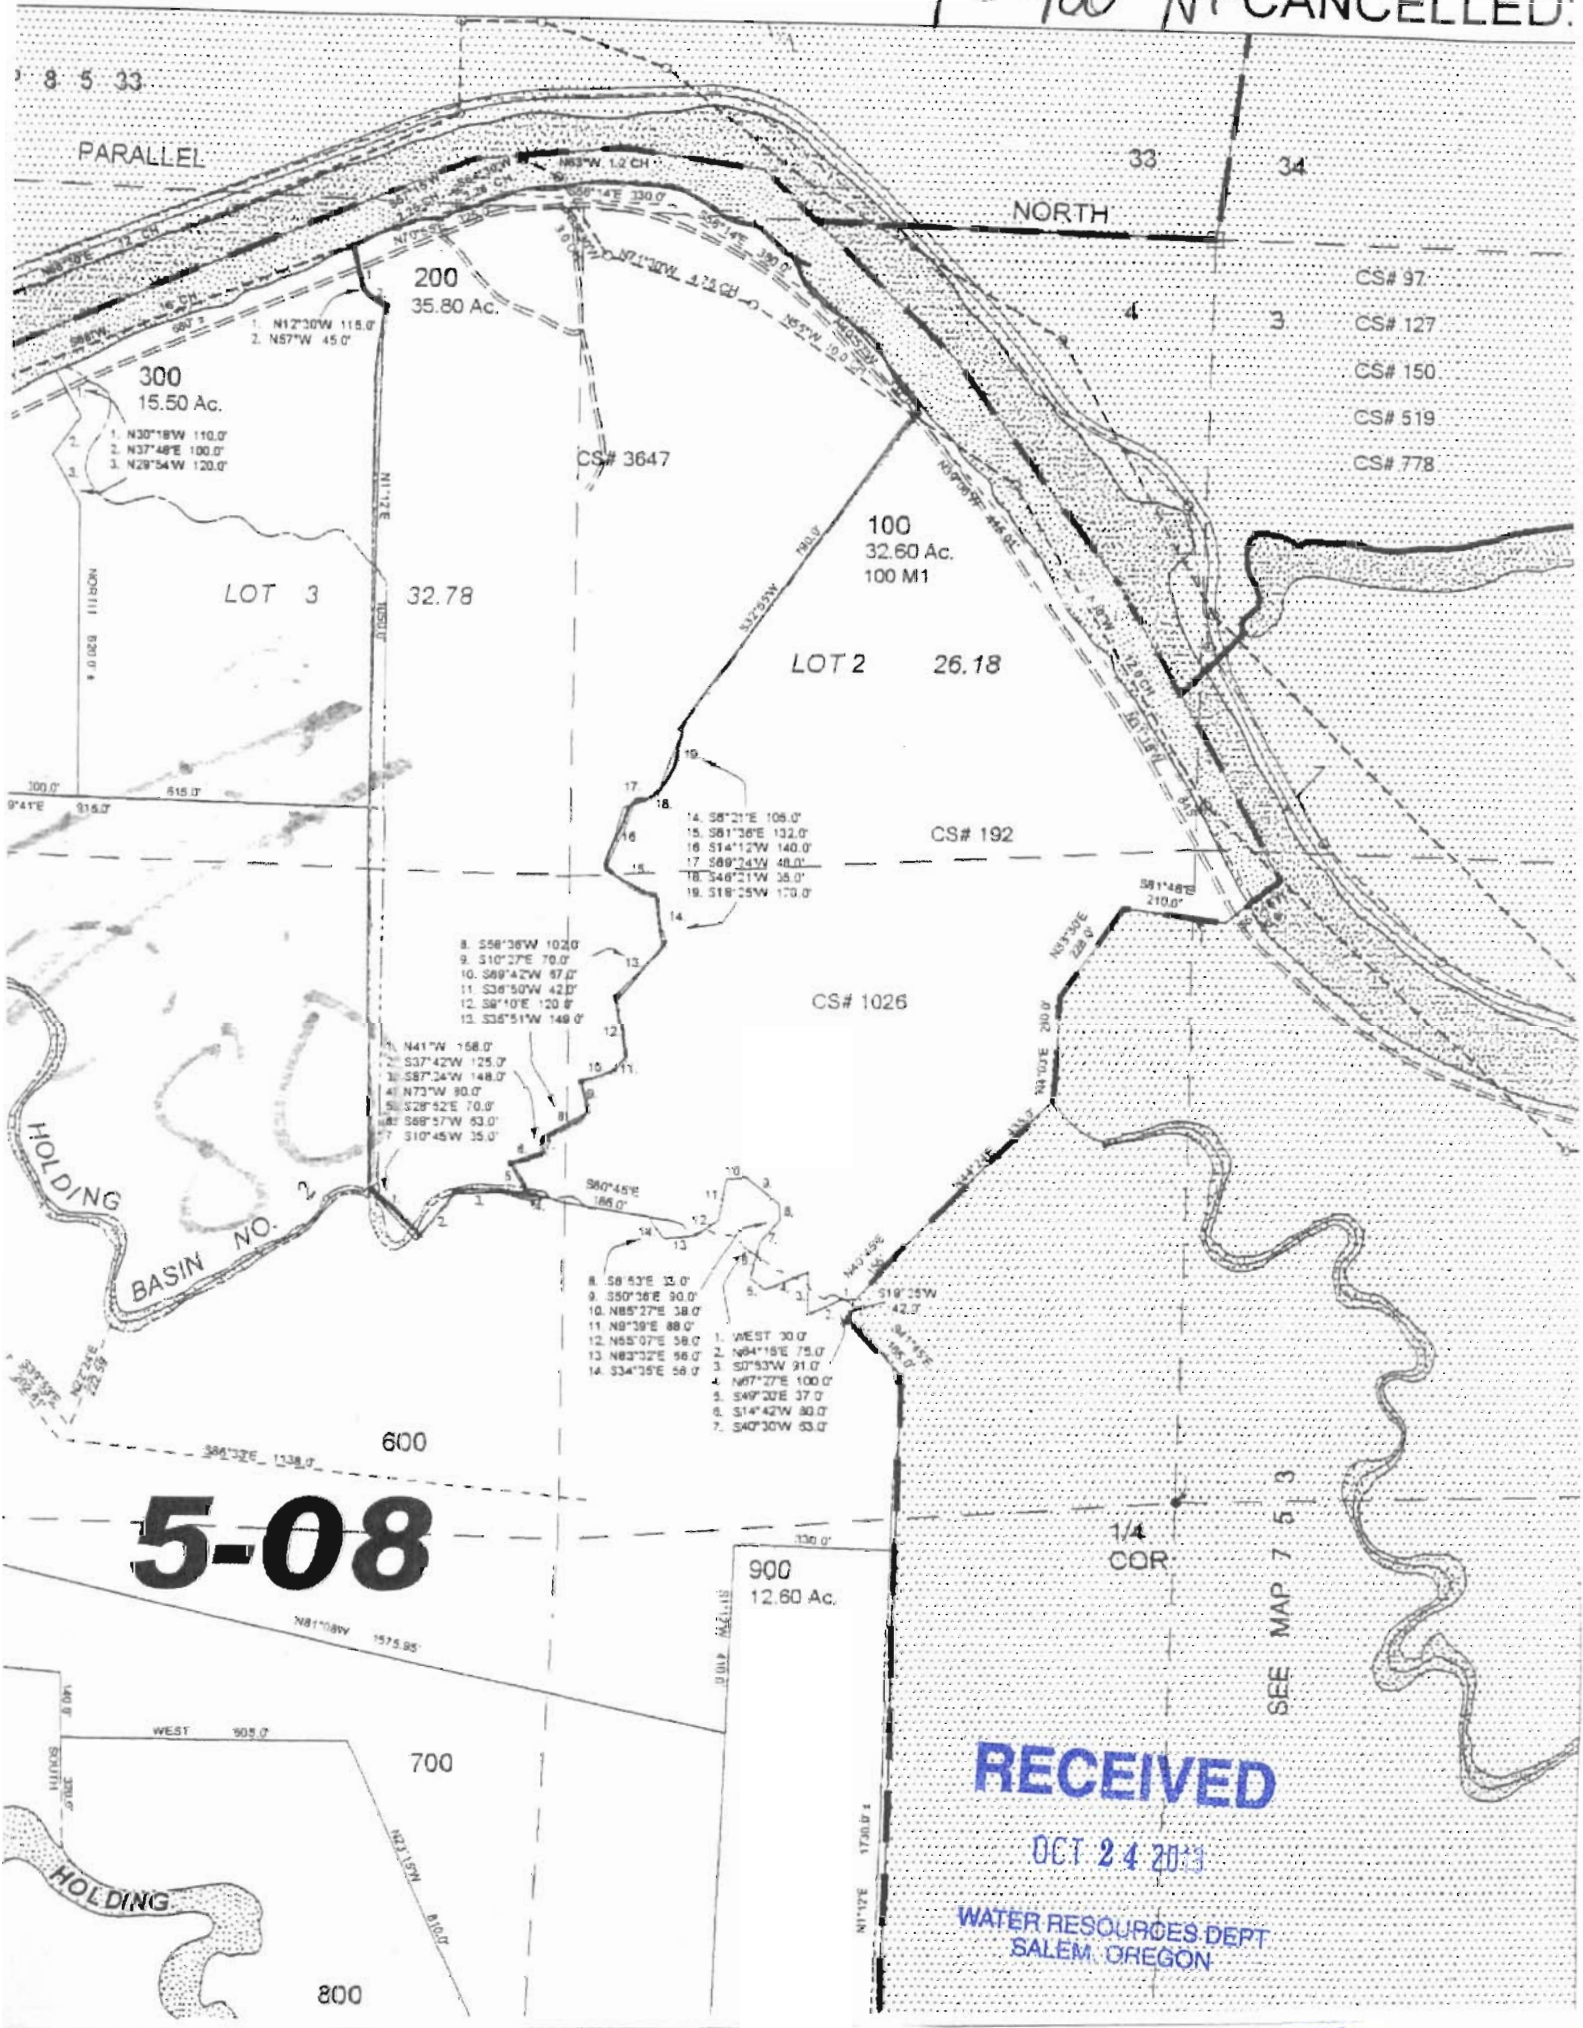

617731

## Audra Martin

---


**From:** Bill Morris <beamore@msn.com>  
**Sent:** Monday, October 28, 2013 5:43 PM  
**To:** Tim Wallin; 'Audra Martin'  
**Subject:** Marshland Property  
**Attachments:** Oregon Property.pdf

Dear Audra,

I approve the modifications to the above map, (specifically POD 200'N,0'W of SW Corner of NENE)

Sincerely,

William L Morris III

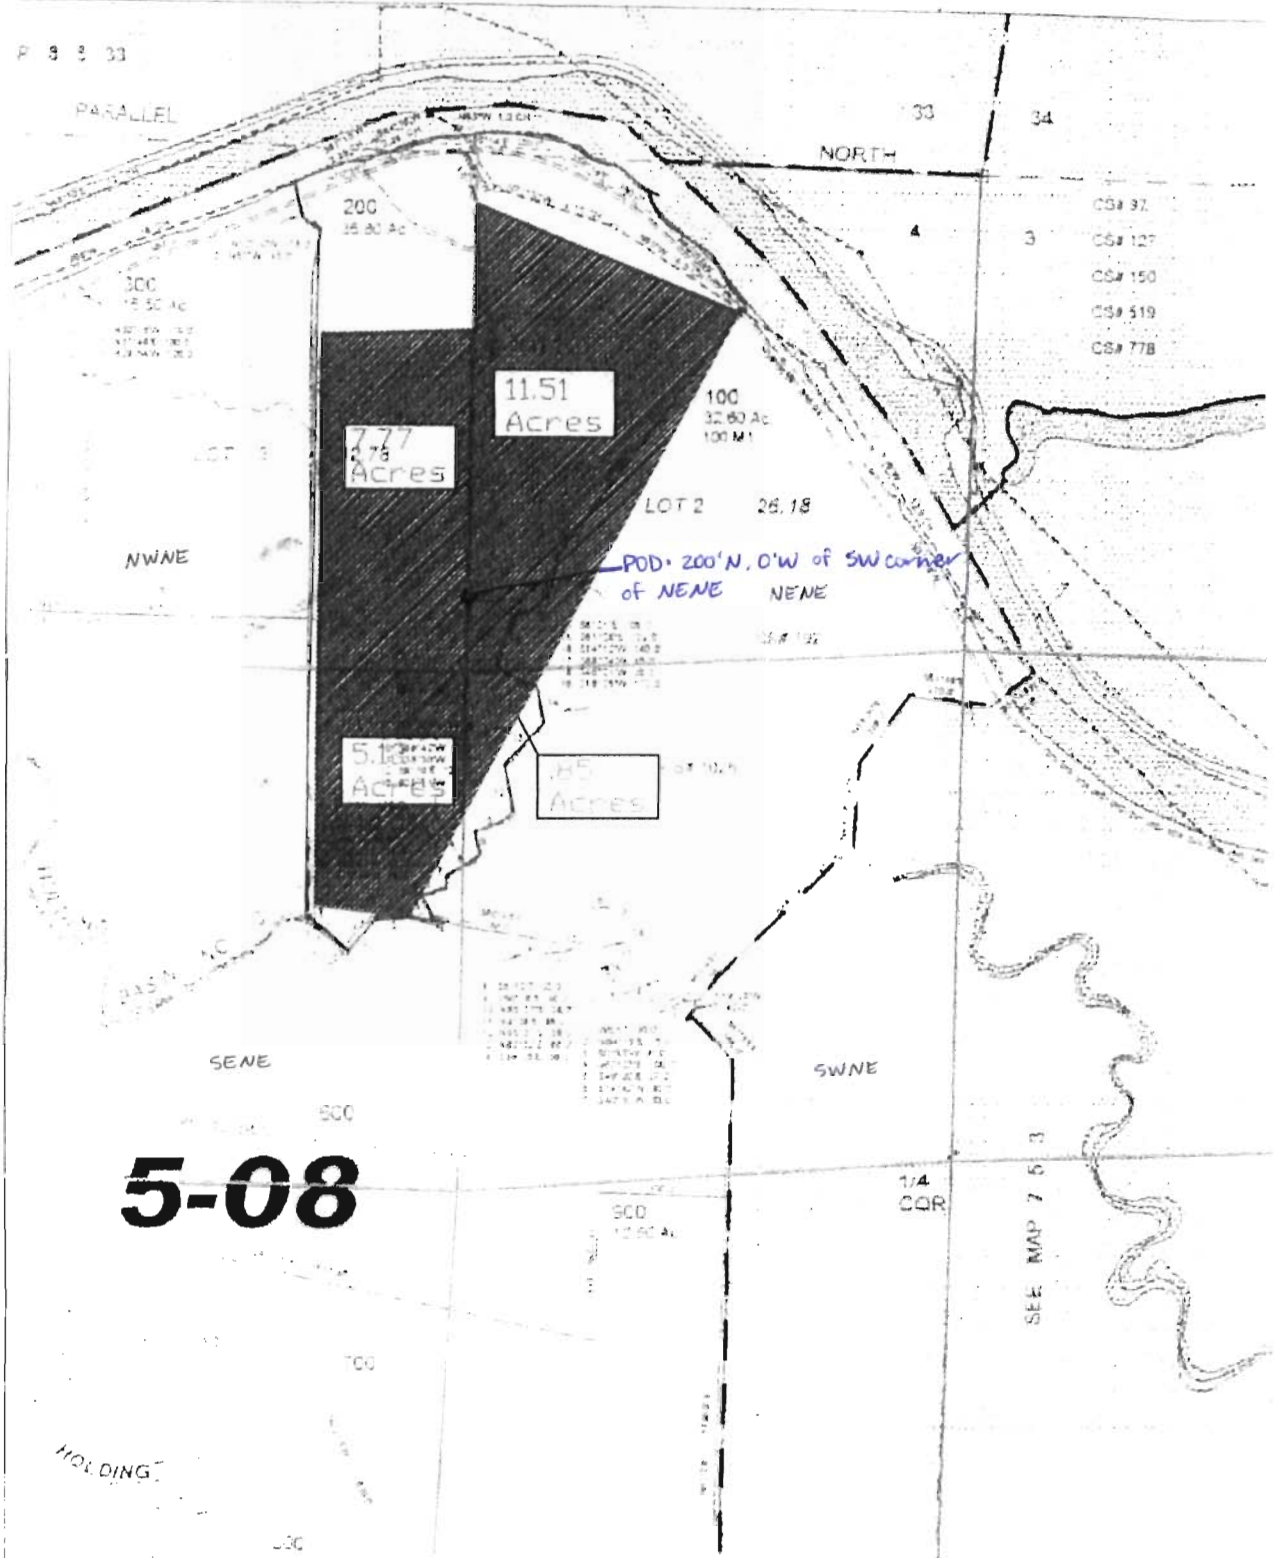

Township 7N, Range 5W  
NE Corner Section 4  
1"=500'

↑ N

owed staff  
amendments