


T.35 S., R. 24 E., W.M.

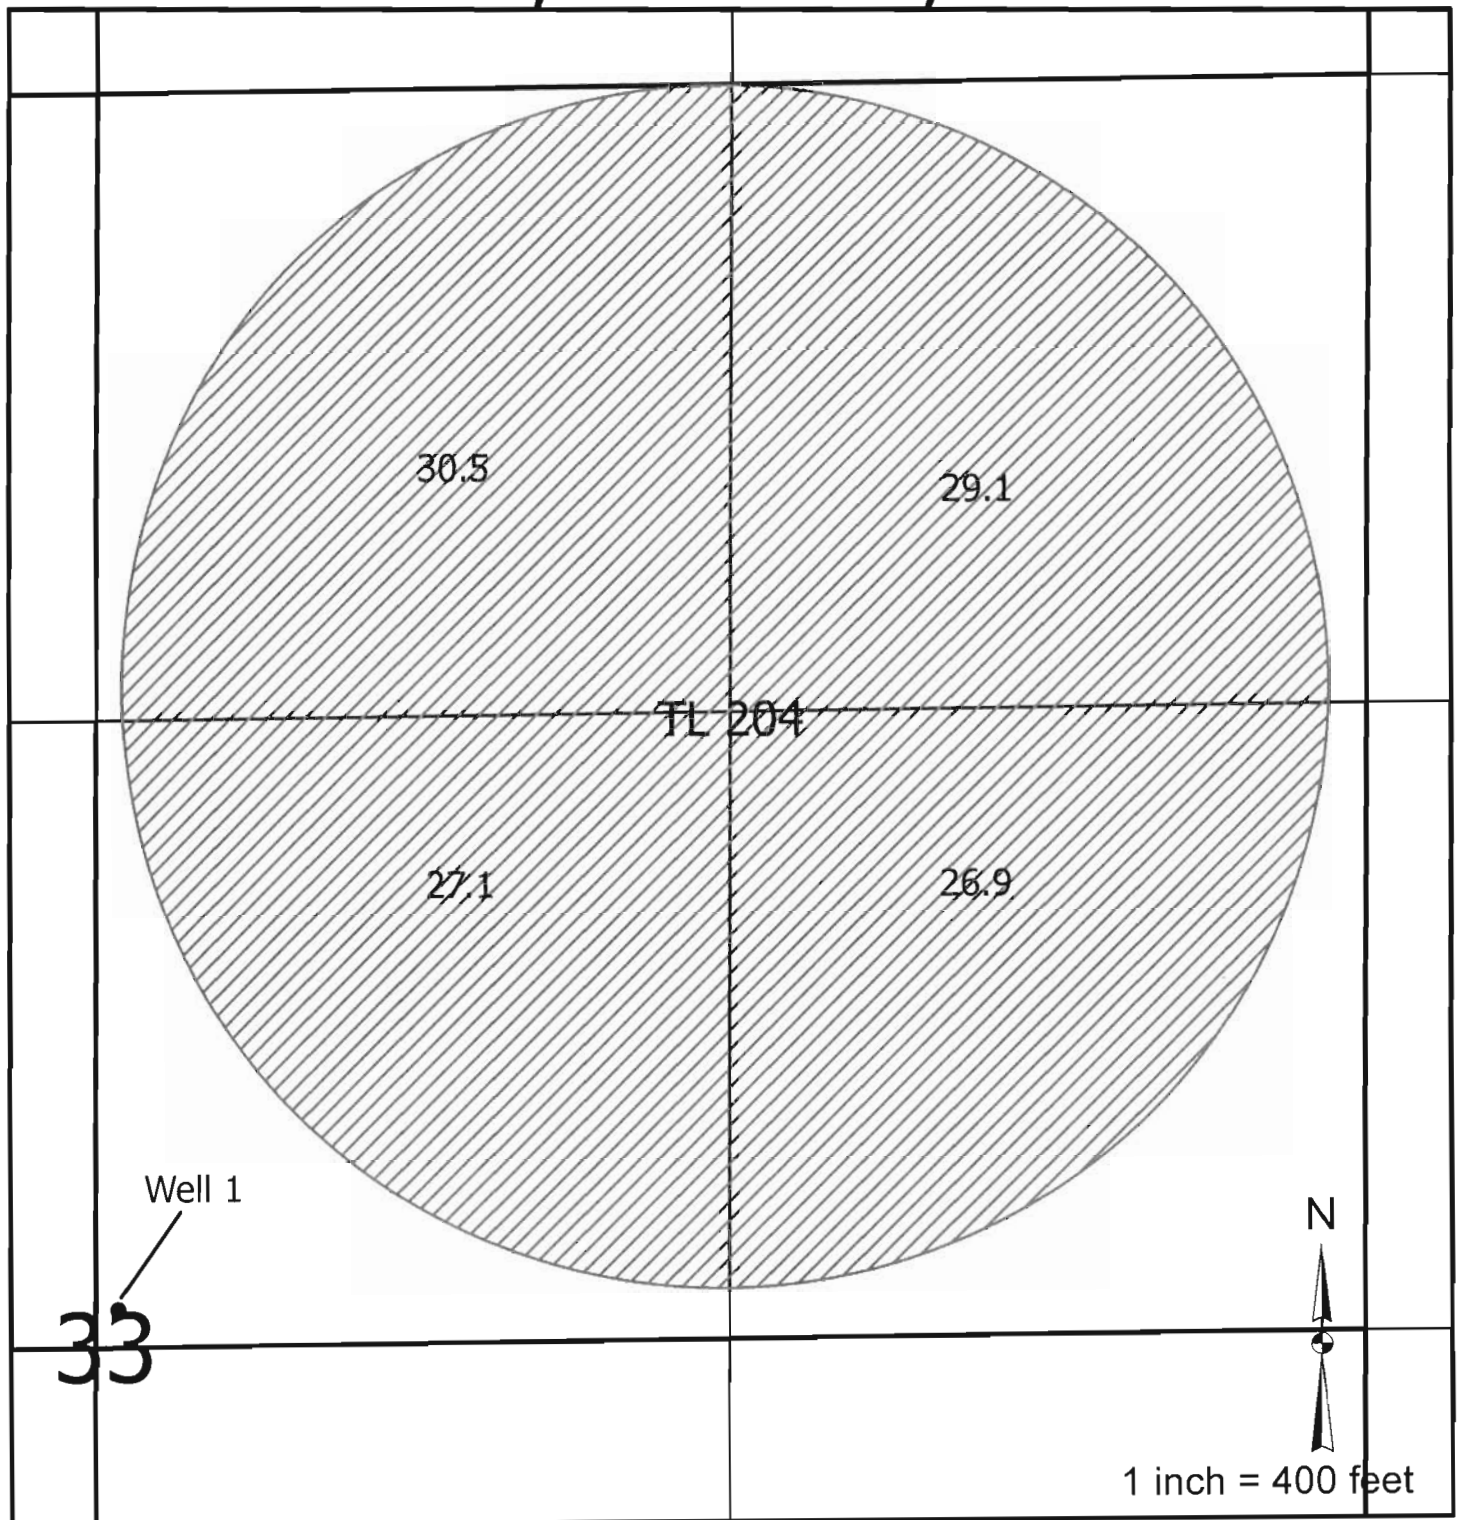

Well 1 is located 2601 ft. West and 2535 ft. South of the NE corner of Section 33

RECEIVED BY OWRD

NOV 04 2013

SALEM, OR

G17733