


SECTION 20 T5S R4W W.M.
YAMHILL COUNTY

5 4
AMITY IND

MAP WAS PREPARED FOR
ASSESSMENT PURPOSE ONLY

1" = 400'

CANCELLED
190
301
501
502
1001
1200
1401
1500
1501
1502
1800

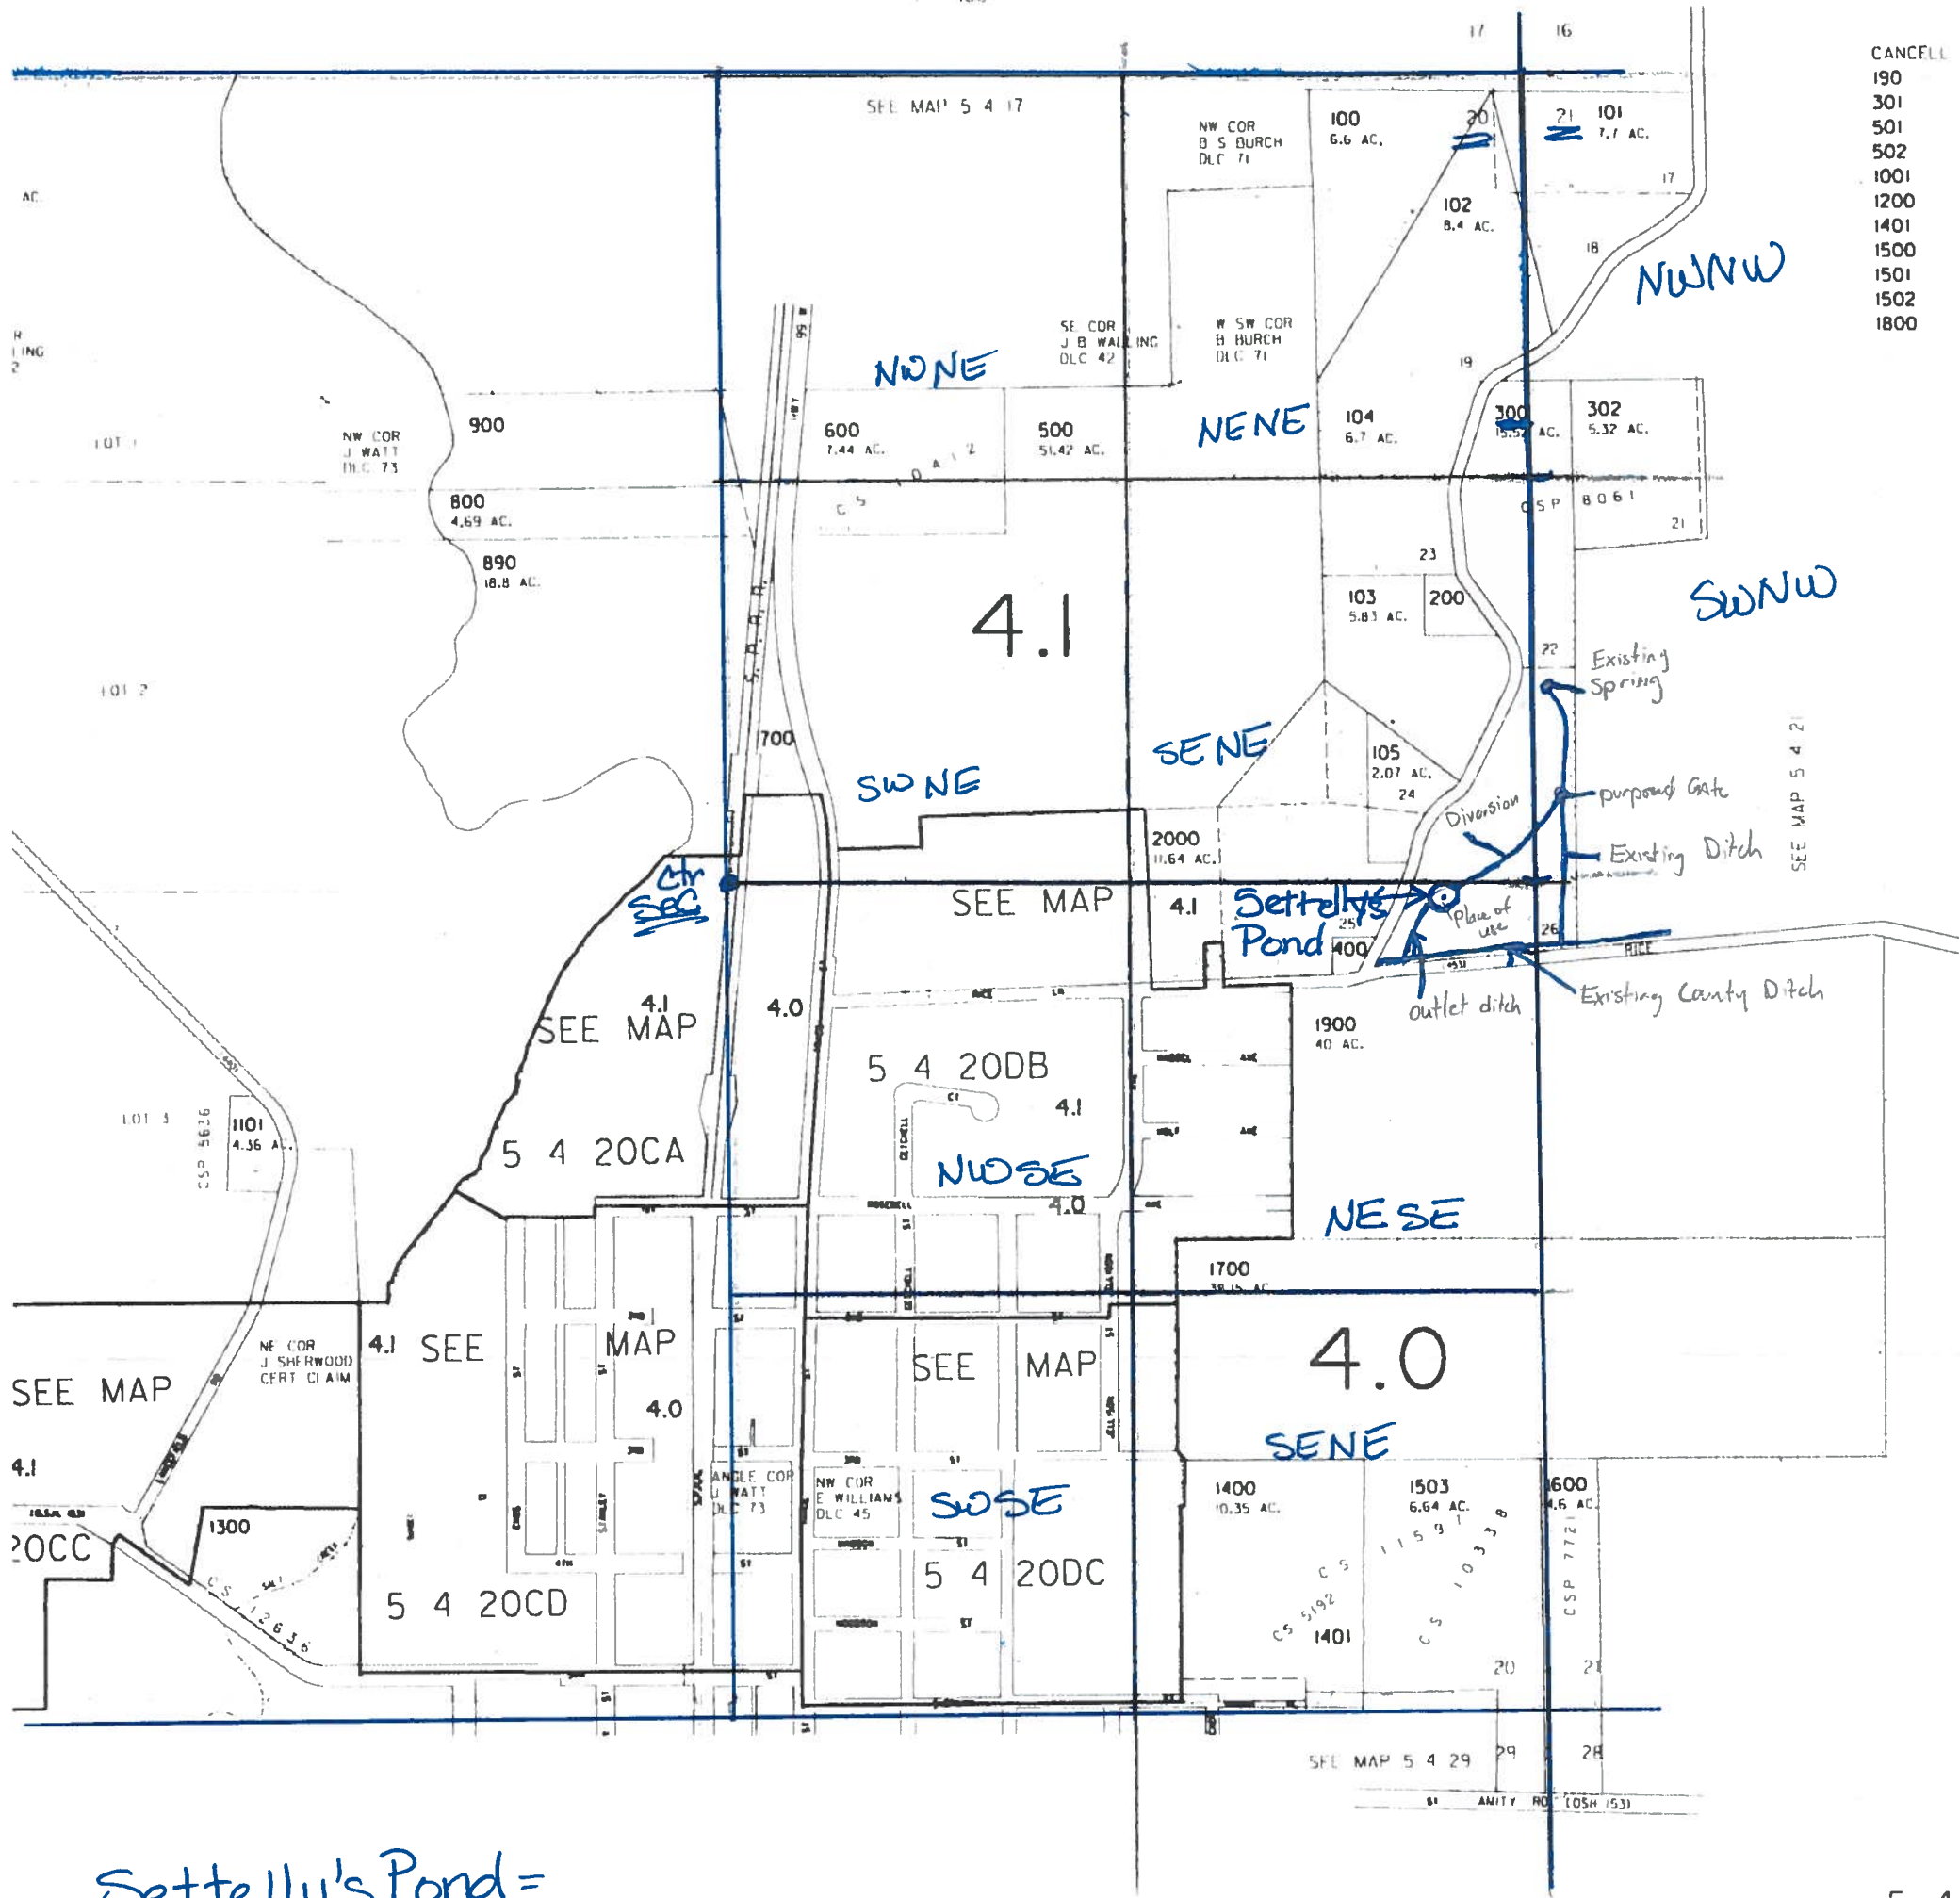

Settelly's Pond =
POU = T5S, R4W, Sec 20,
 NESE, Sec 20,
 300' East, 60'S from E 1/4 corner

POD: T5S, R4W, Sec 21,
 SWNW, 60' East, 630 ft N,
 from W 1/4 corner, Sec 21

*Tax Lot 300

Bryce Roberts
 8/13/2013

R87940



RECEIVED
 OCT 30 2013
 WATER RESOURCES DEPT
 SALEM, OREGON

scale 1" = 600'

5 4