Revised Map

G-17586 Amended by MM
WMD2

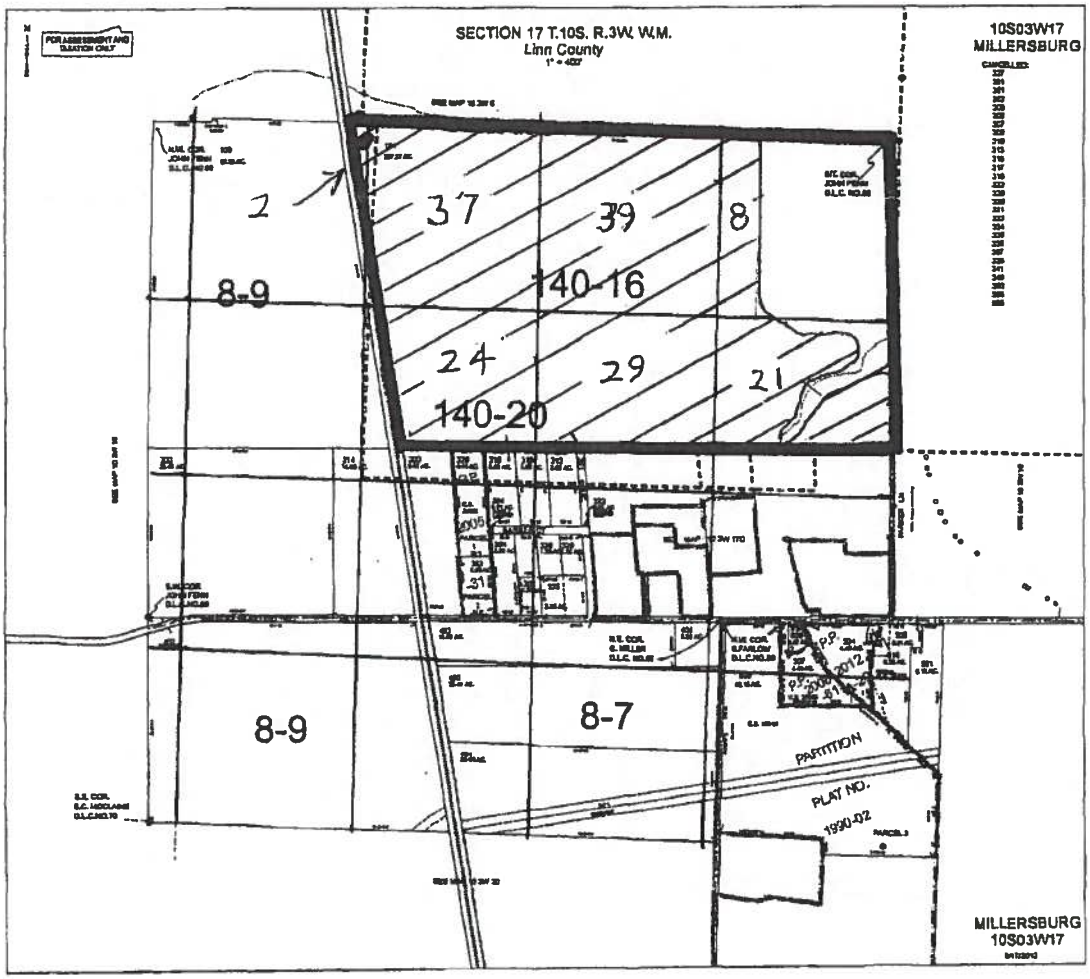

Scale 1" = 1320'
POD 1320' East & 150' South
From NW Corner Section 17

RECEIVED
SEP 27 2013
WATER RESOURCES DEPT
SALEM, OREGON

RECEIVED BY OWRD
OCT 30 2013
SALEM, OR