

NORTHEAST QUARTER of  
SOUTHWEST QUARTER of 28

1942.45'  
SOUTHEAST QUARTER of  
SOUTHWEST QUARTER of 28

WELL # 2A  
G-735  
205' N x 970' W  
from 3/4 Cor.

WELL # 4B

WELL # 4A  
G-737  
981' N x 1078' W  
from 3/4 Cor.


WELL # 3A  
G-736  
622' N x 1240' W  
from 3/4 Cor.

WELL # 1  
(COMING)

NORTHWEST QUARTER of 28

NORTHWEST QUARTER of  
SOUTHWEST QUARTER of 28

SOUTHWEST QUARTER of  
SOUTHWEST QUARTER of 28

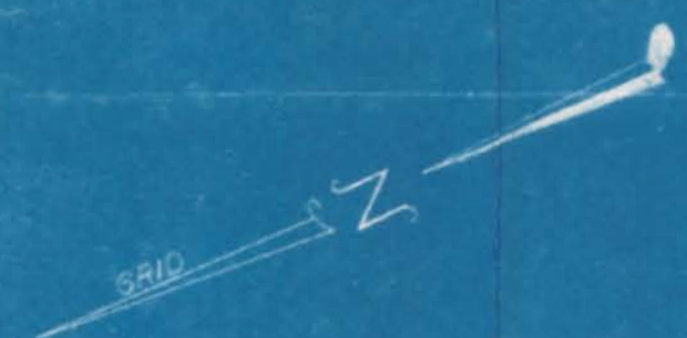

Application Nos. G-734, G-735, G-736, G-737  
Permit Nos. G-645, G-646, G-647, G-648

CONFIDENTIAL  
This document contains confidential information which is the property of this Company. Disclosure in any manner is expressly prohibited. Neither this document nor the information contained herein shall be duplicated, used or disclosed in whole or in part, nor be published for distribution, in any manner identifying the Company, without the written authorization of this Company.  
This document contains information affecting the National Defense of the United States within the meaning of the Espionage Law, Title 18, U. S. C., Section 793 and 794. Its transmission or the revelation of its contents in any manner to an unauthorized person is prohibited by law.

NO.	REVISION	DATE	BY	APPD.	APPROVED FOR CONSTRUCTION	INIT.	DATE
					ENGINEERING STAFF		
					DESIGN ENGINEER		
					CHIEF ELECTRICAL ENGINEER		
					CHIEF PROCESS ENGINEER		
					CHIEF DESIGN ENGINEER, A & E		
					CHIEF PROJECT ENGINEER		

HARVEY ALUMINUM  
DIVISION OF  
HARVEY MACHINE CO., INC. TORRANCE, CALIF.  
THE DALLAS ALUMINUM REDUCTION  
FACILITY —

DRAWING TITLE  
WELL LOCATIONS  
DWG. BY J. PERHARD  
CHECKED  
DATE July 22, 1957  
SCALE 1" = 100'  
DWG. NO.  
DAR-31

20 21  
22 23

28 29  
30 31