


T85, R 2W, Sec 16

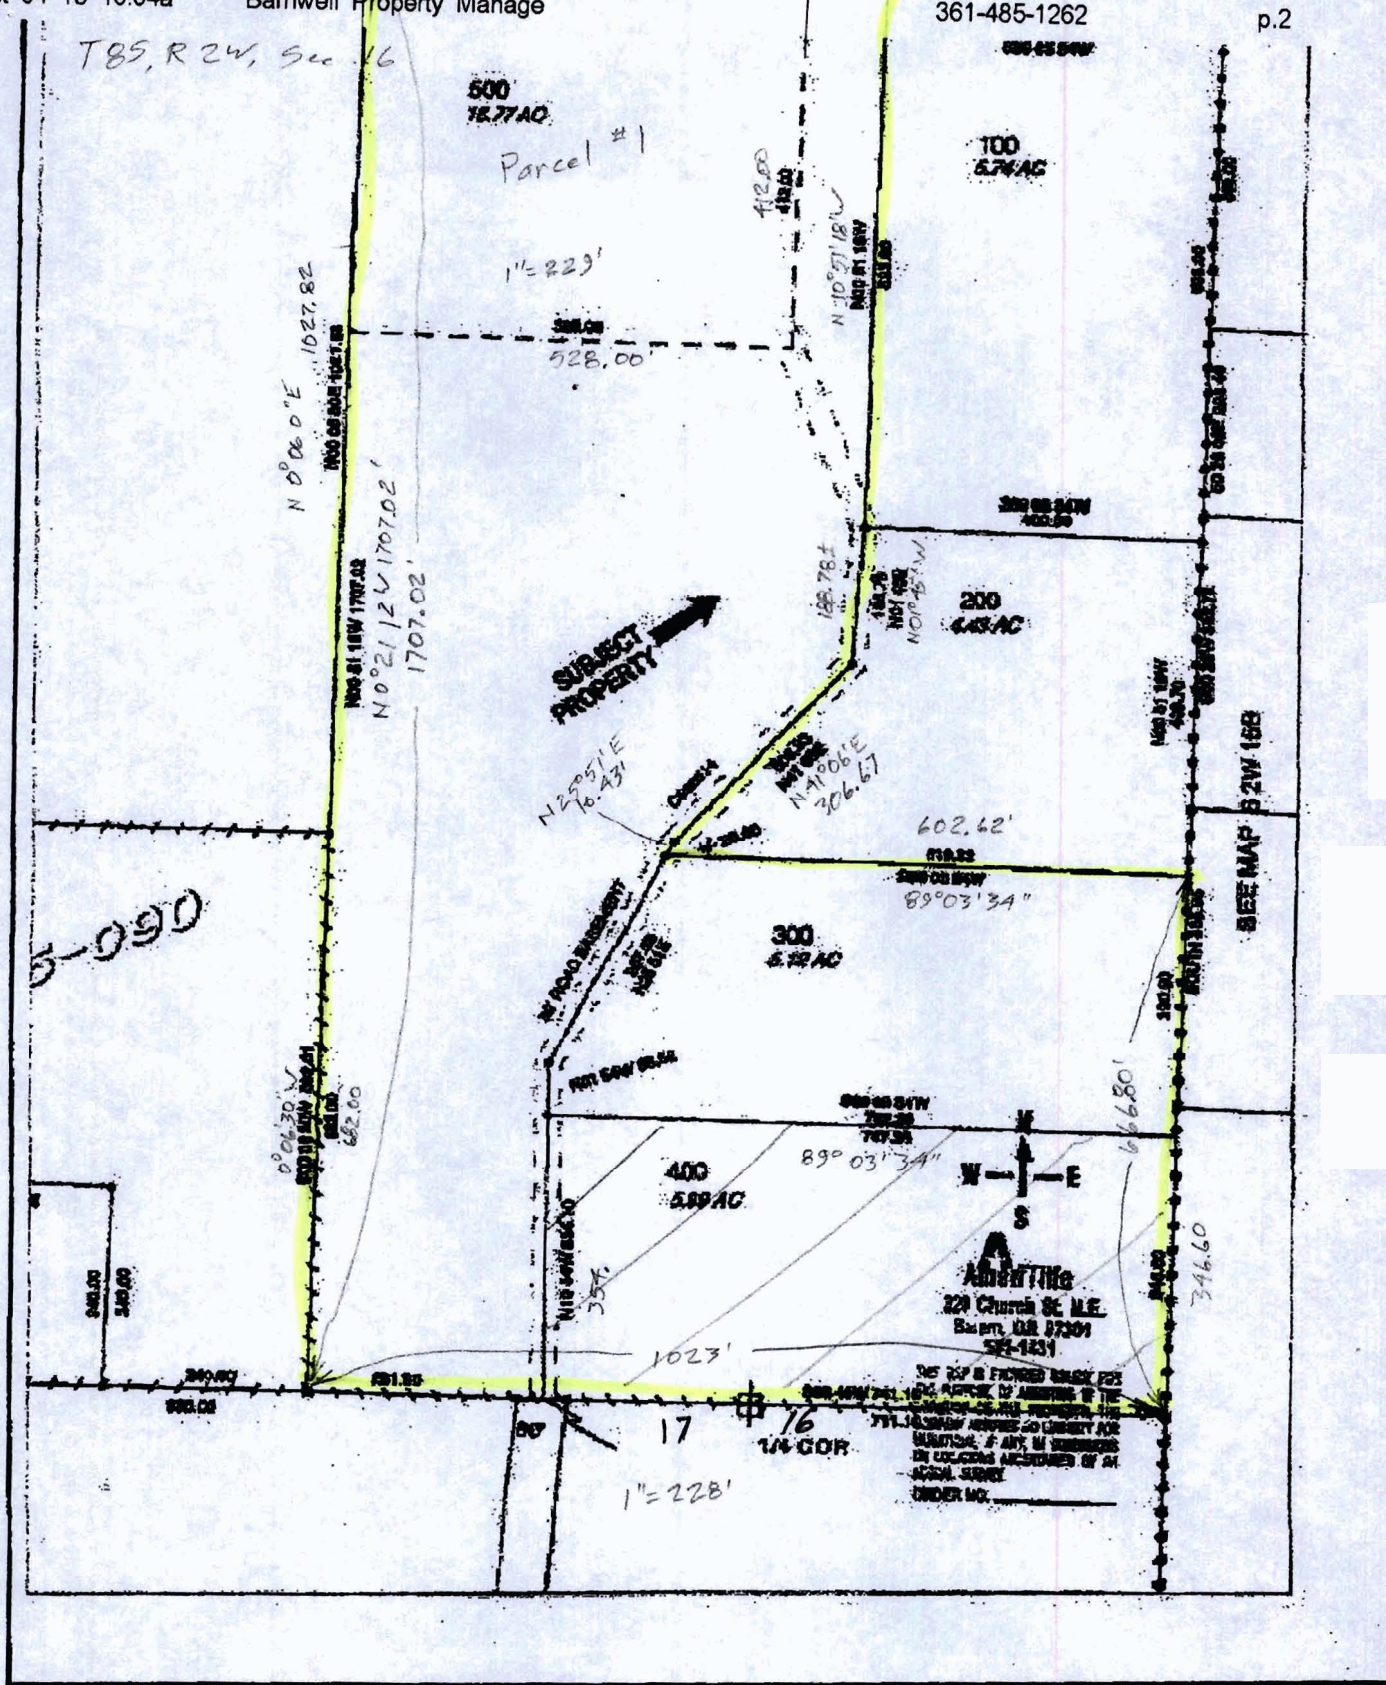

 229 Church St. N.E.
 Salem, OR 97301
 ORDER NO.

RECEIVED BY OWRD

NOV 19 2013

SALEM, OR